


Deemer

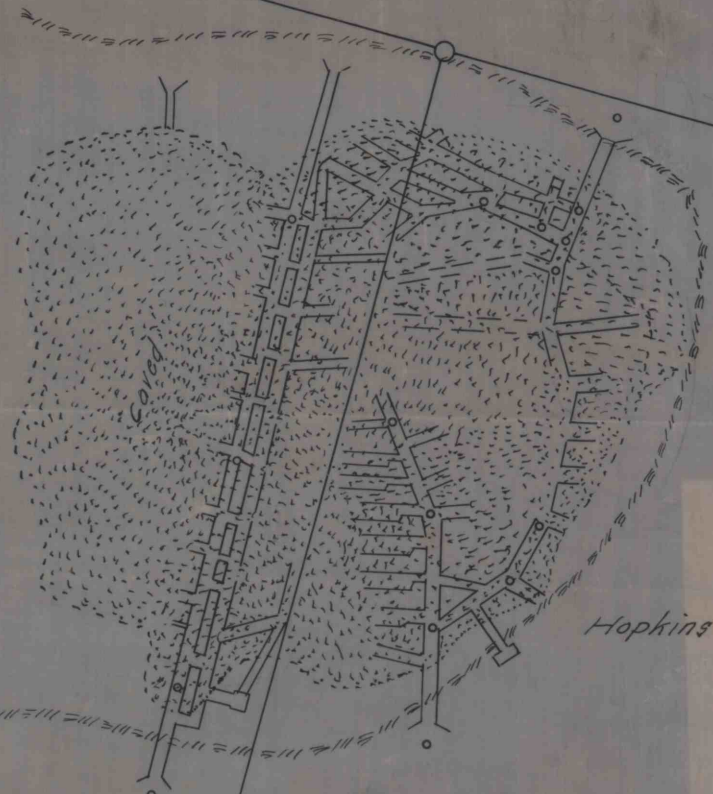

Hopkins Est.

G. B. Stauffer

Fike Mine
 Knox Township - Jeff. Co. Pa.
 Scale 1" = 100' Nov. 1944.

#993
 7-19-97
 C.C.