


STATE OF PENNSYLVANIA, {
COUNTY OF JEFFERSON.

Fred D. Seyer, a Registered Professional Engineer in the State of Pennsylvania, first being duly sworn according to law does depose and say that this survey of mine situate in Oliver Township, Jefferson County, Pa., is true and correct according to surveys made, and makes this affidavit to the end that it may be recorded as such.

Sworn and Subscribed to before me this 12, day of December A.D., 1947

Mary E. Rebayla
NOTARY PUBLIC

My Commission Expires JANUARY 21, 1951

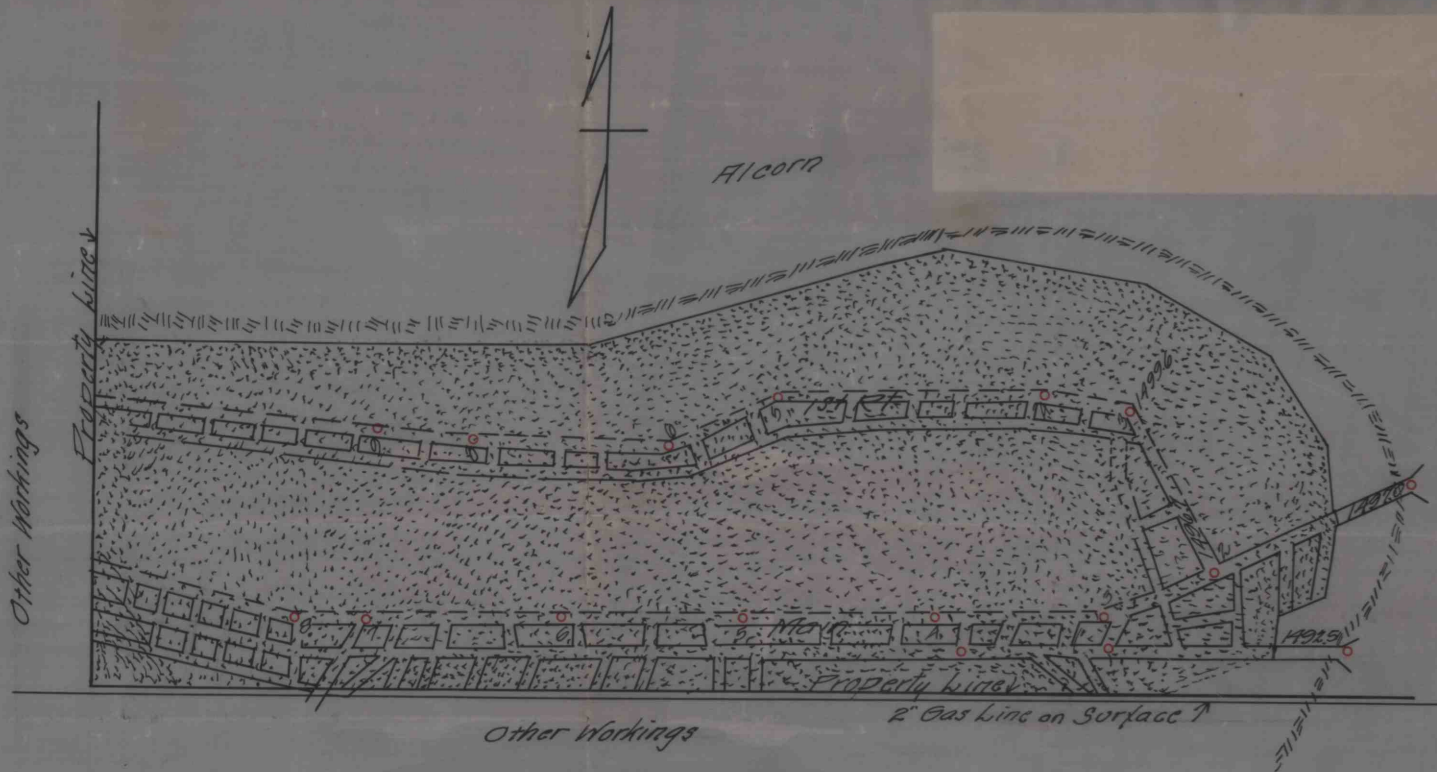

#994
7-19-51
CC