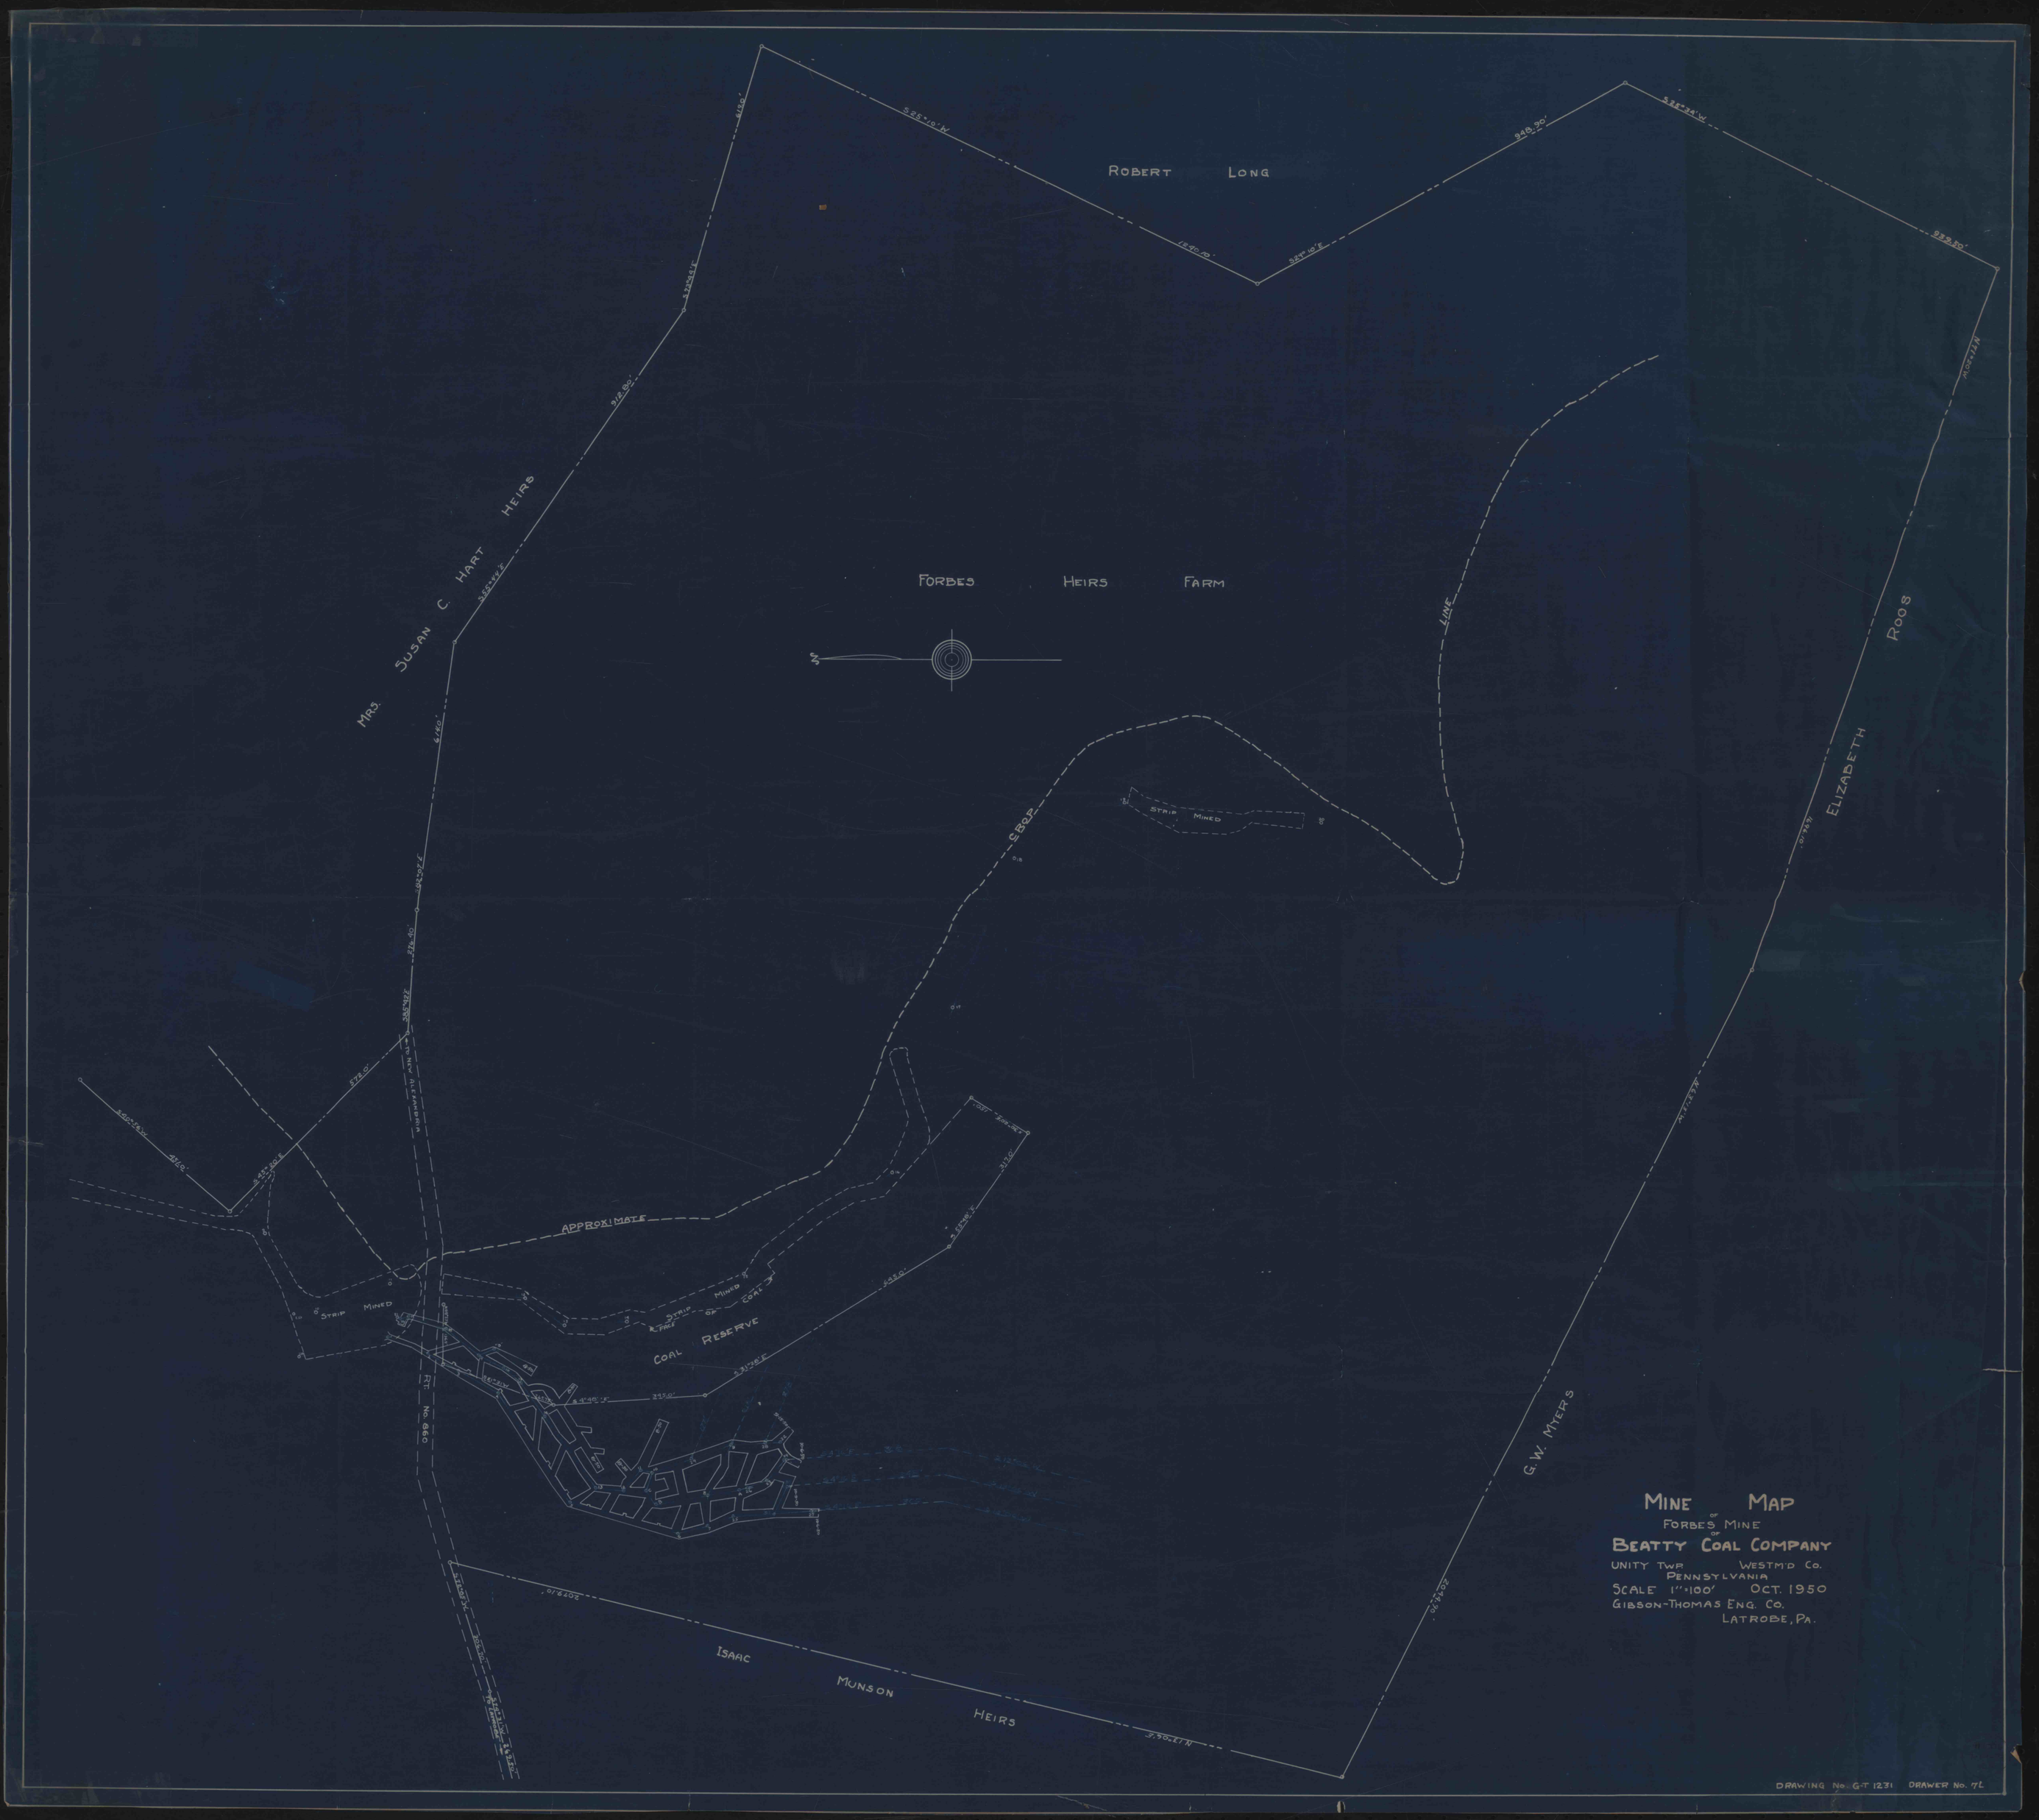
ROBERT LONG
MRS. SUSAN C. HART HEIRS
FORBES HEIRS FARM
ELIZABETH ROOS
G.W. MYERS
ISAAC MUNSON HEIRS
STRIP MINED
CROP
LINE
APPROXIMATE
COAL RESERVE
RT. No. 860
MINE MAP
OF
FORBES MINE
OF
BEATTY COAL COMPANY
UNITY TWP. WESTM'D CO.
PENNSYLVANIA
SCALE 1"=100' OCT. 1950
GIBSON-THOMAS ENG. CO.
LATROBE, PA.
DRAWING No. G-T 1231 DRAWER No. 7L