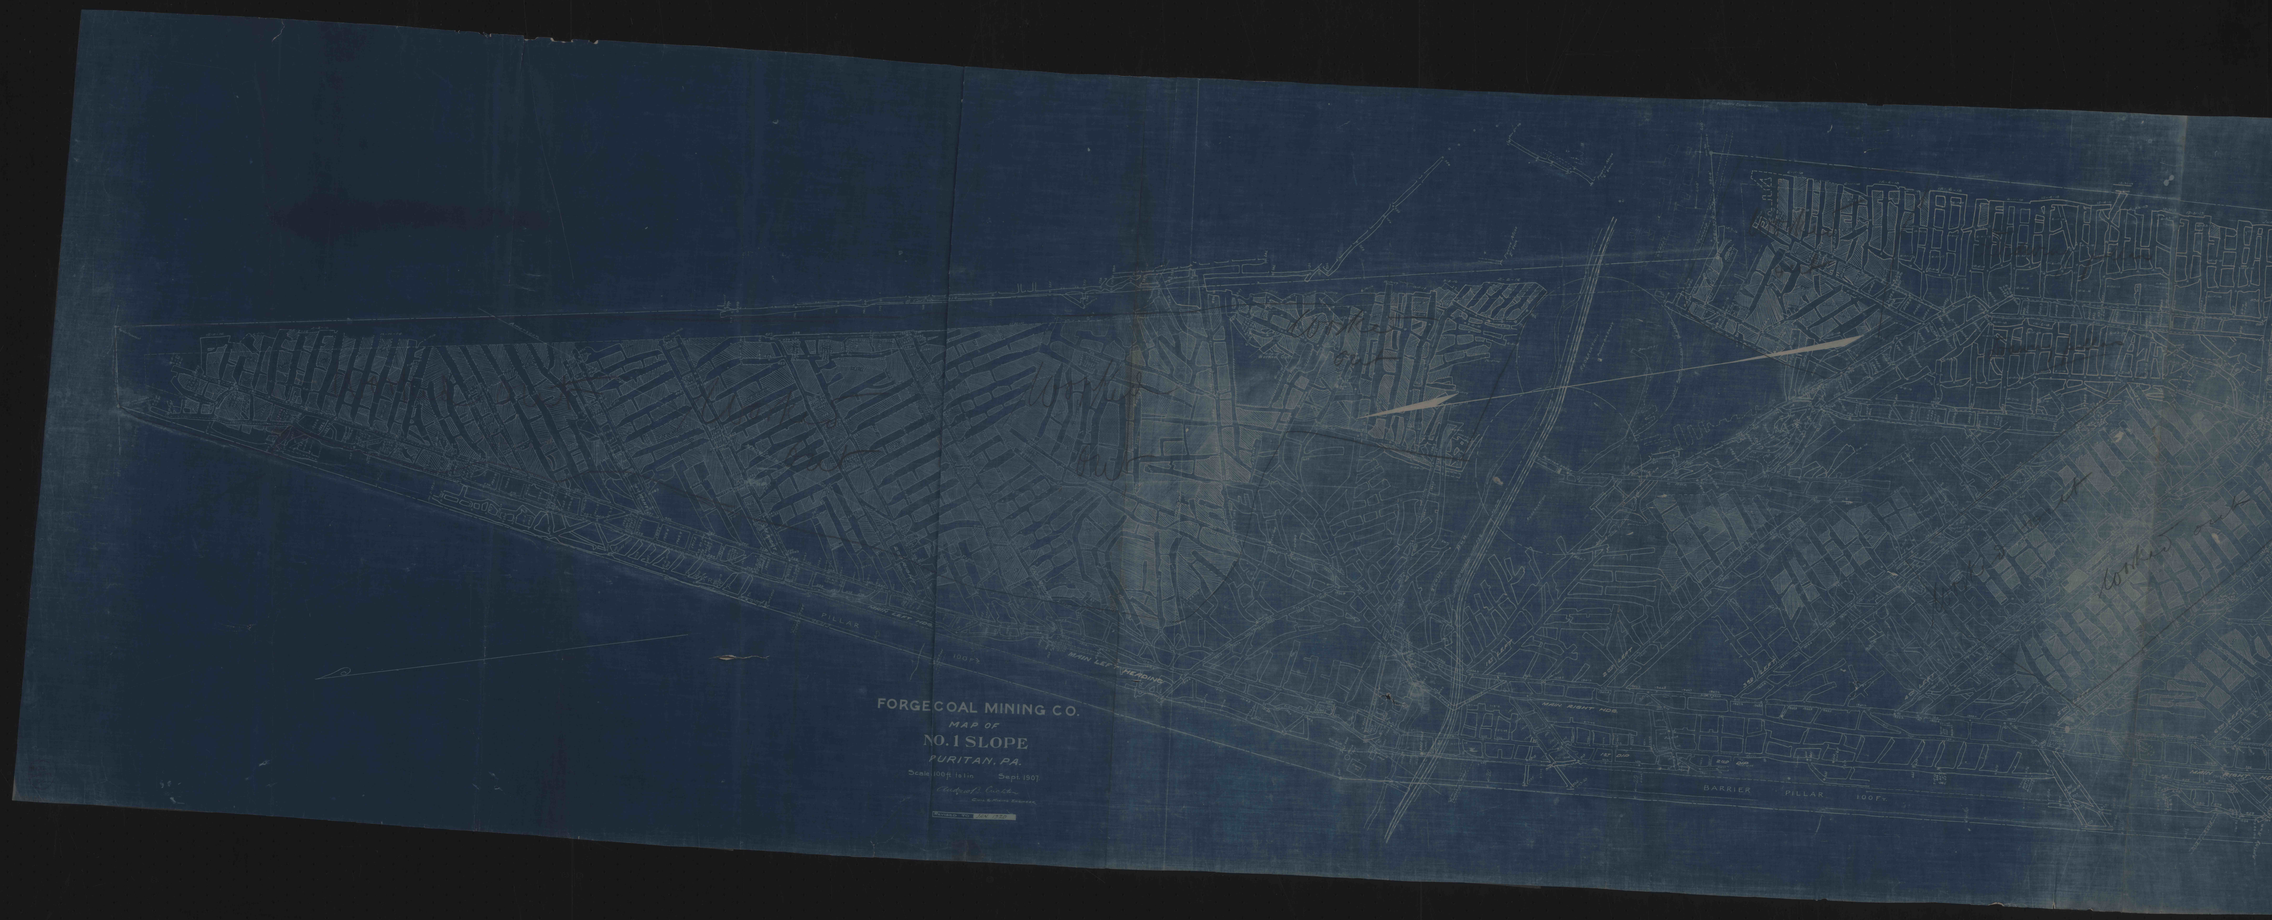
FORGE COAL MINING CO.
MAP OF
NO. 1 SLOPE
PURITAN, PA.
Scale 100 ft to 1 in
Sept. 1901
Surveyed & Drawn by
BARRIER PILLAR 100 Ft.