


Ralph

Lambert


Lambert

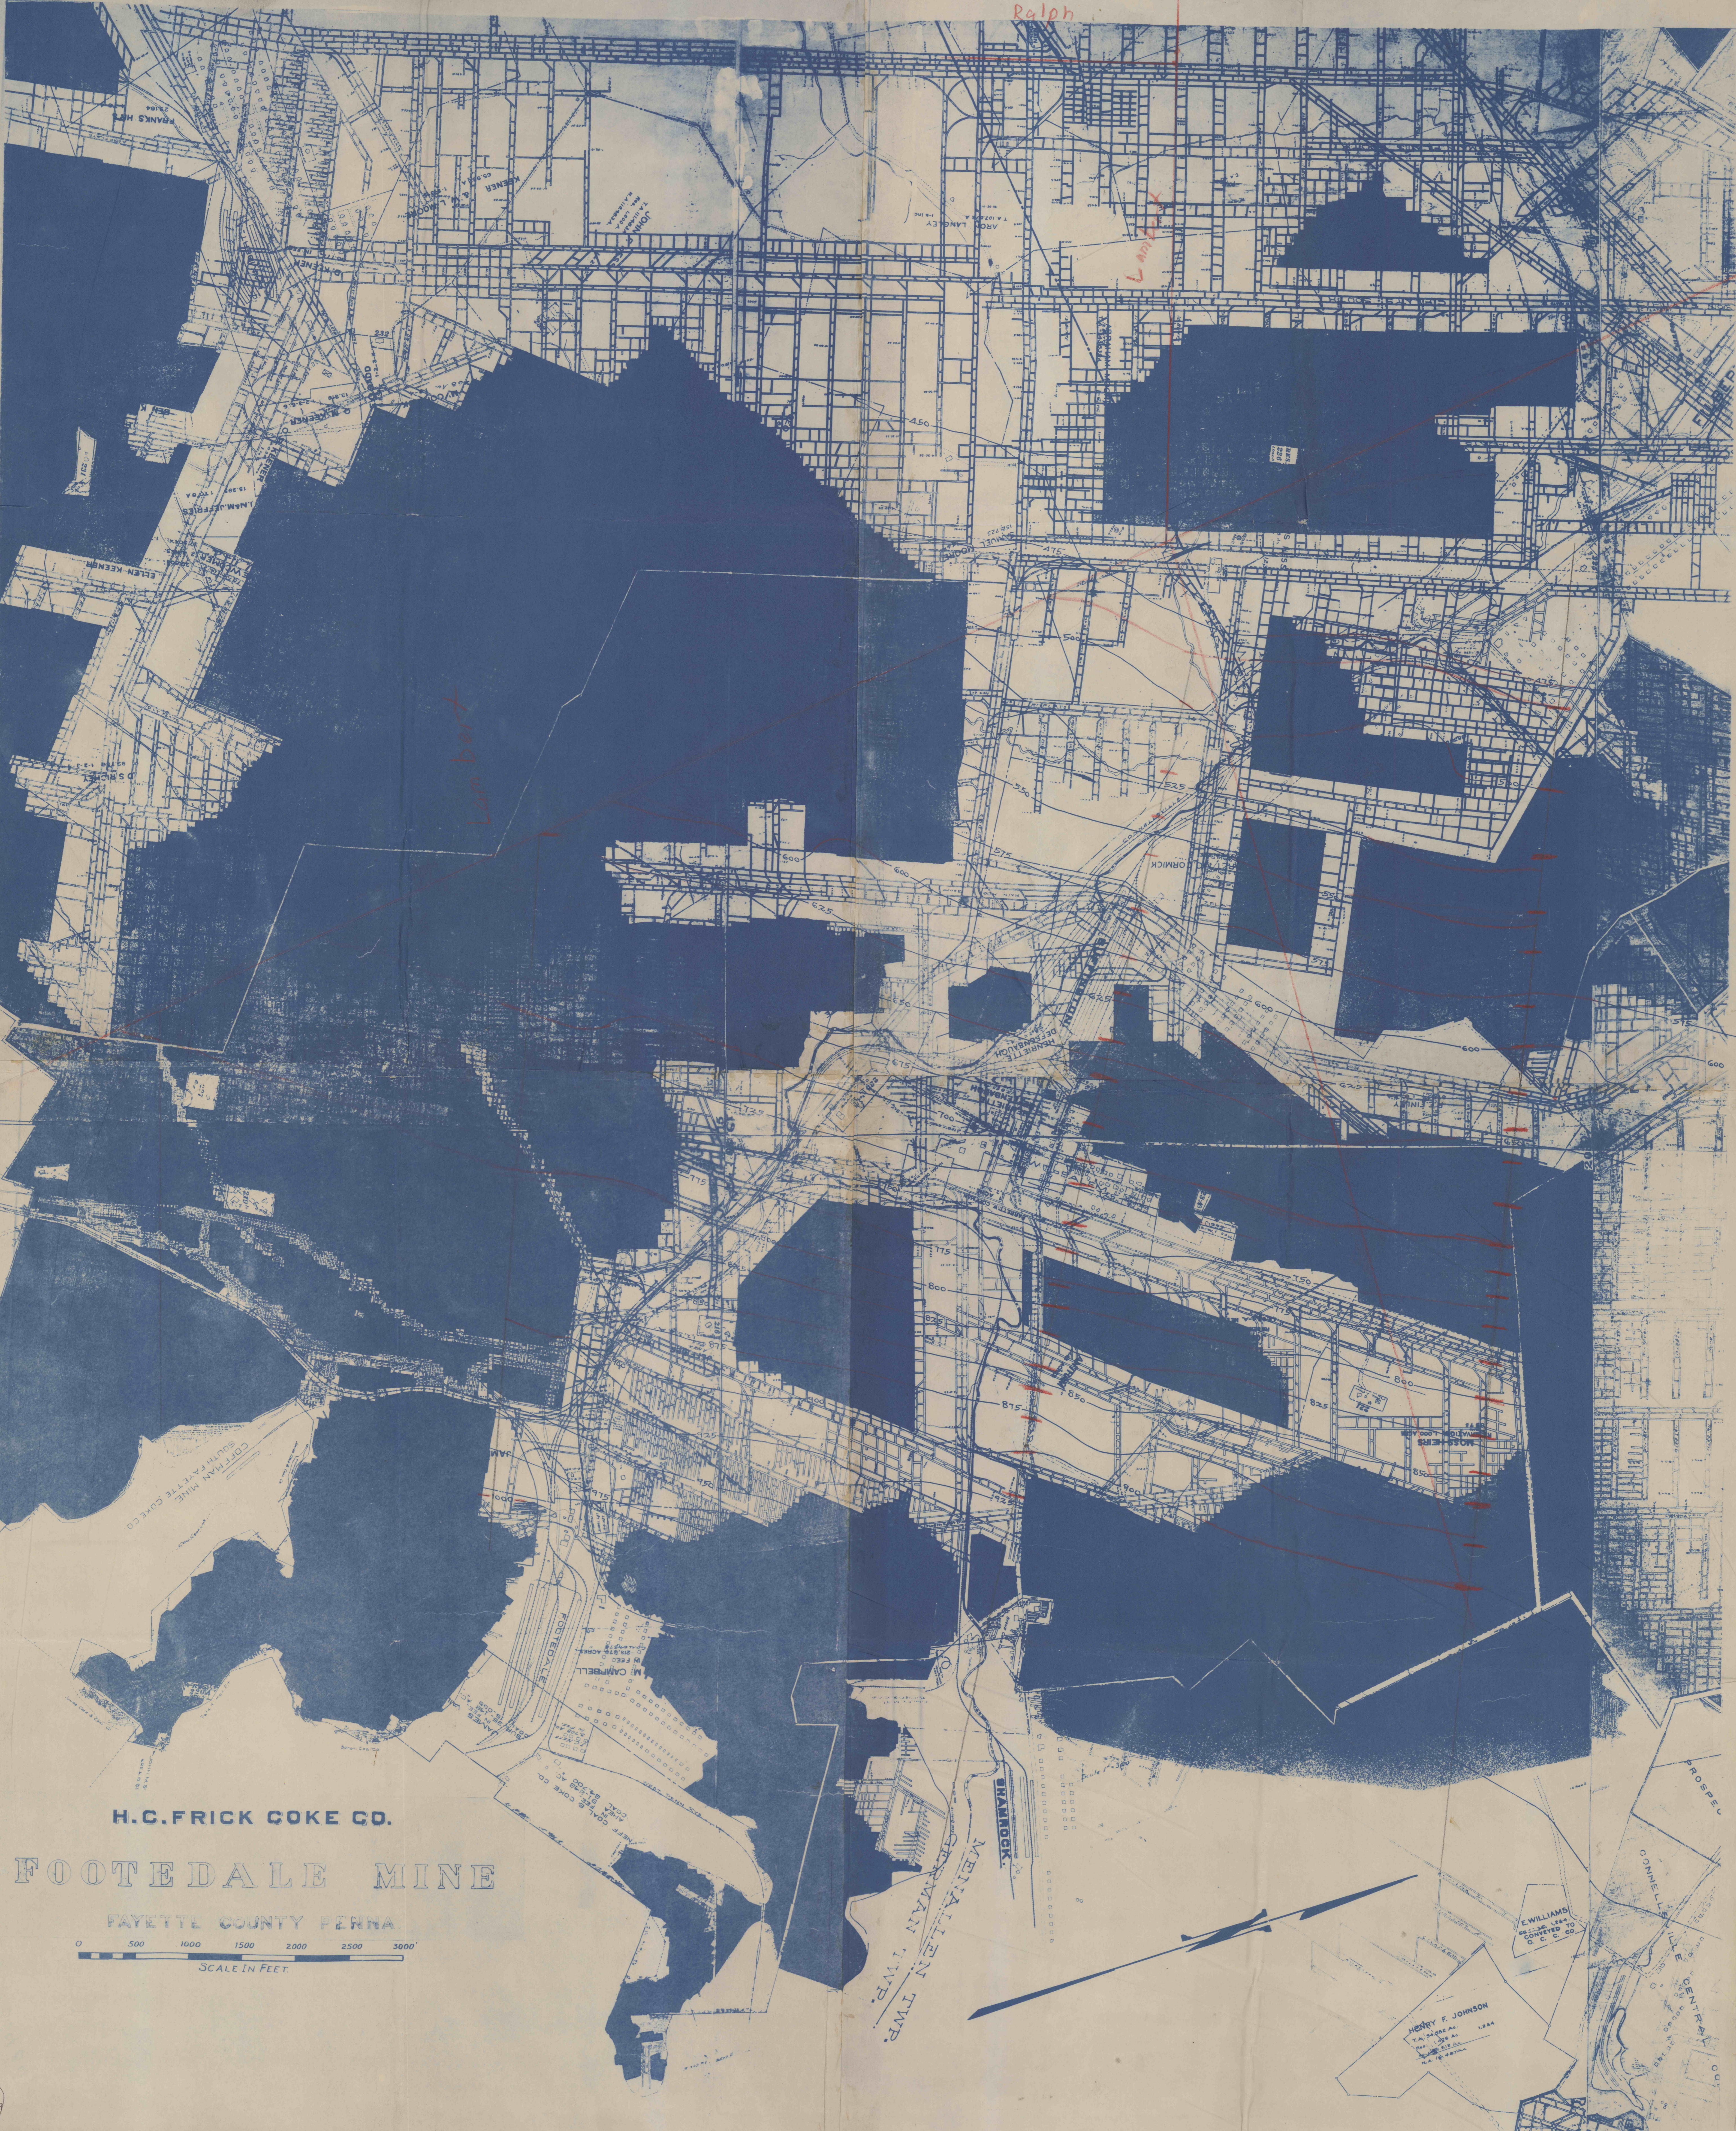

H.C. FRICK COKE CO.

FOOTEDALE MINE

FAYETTE COUNTY PENNA.

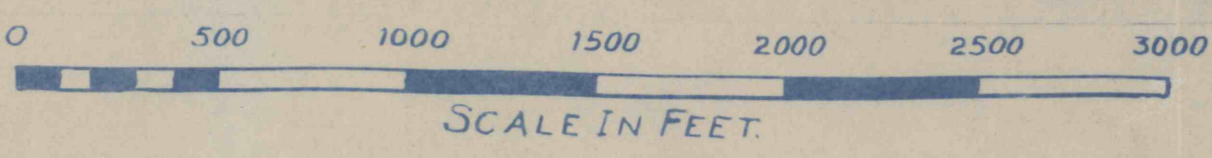

SCALE IN FEET.



HENRY F. JOHNSON  

E. WILLIAMS  
