




H.C. FRICK COKE CO.



CONSOLIDATED CONNELLVILLE COAL AND COKE COMPANY

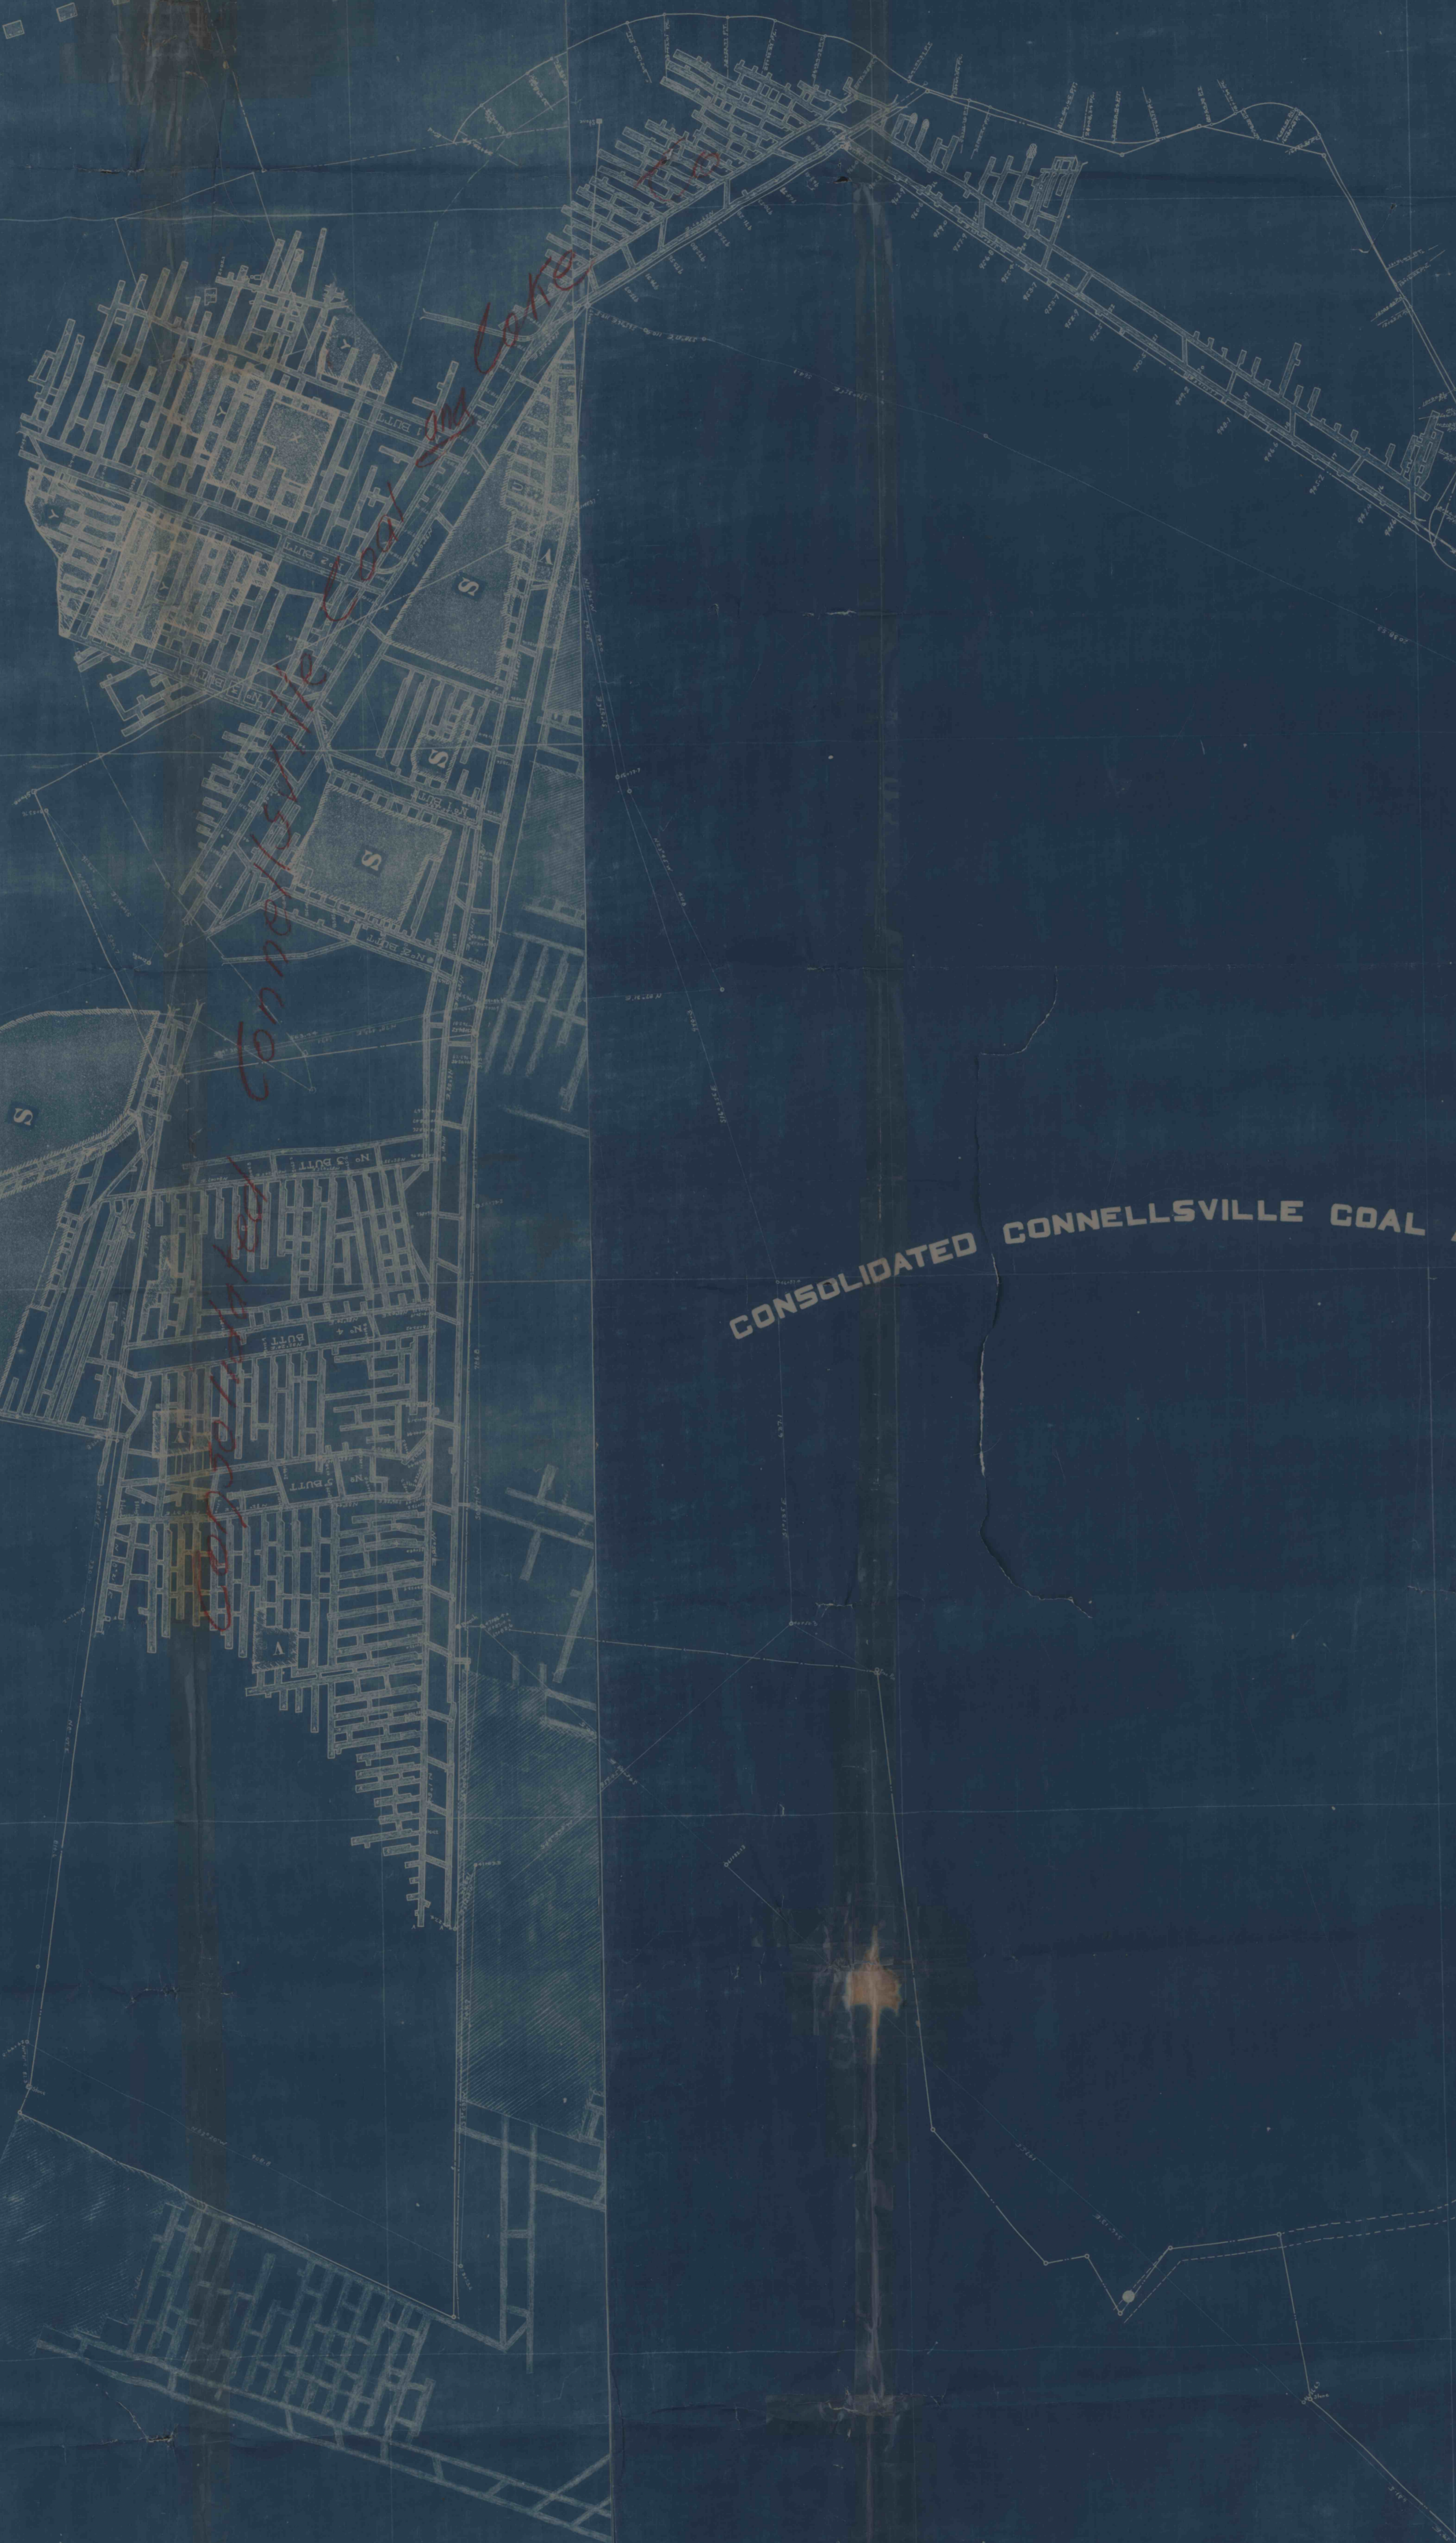

Consolidated Coal & C. Co.

*Although this
apparently shows a
change about the
shape of the*

MAP OF
FRANCIS NO. 1 MINE
AMERICAN CONNELLVILLE CO. & C. COMPANY.
MARTIN, FAYETTE CO., PA.
SCALE, 1 INCH = 100 FT.

AMERICAN NO.-2

STATE OF PENNSYLVANIA

