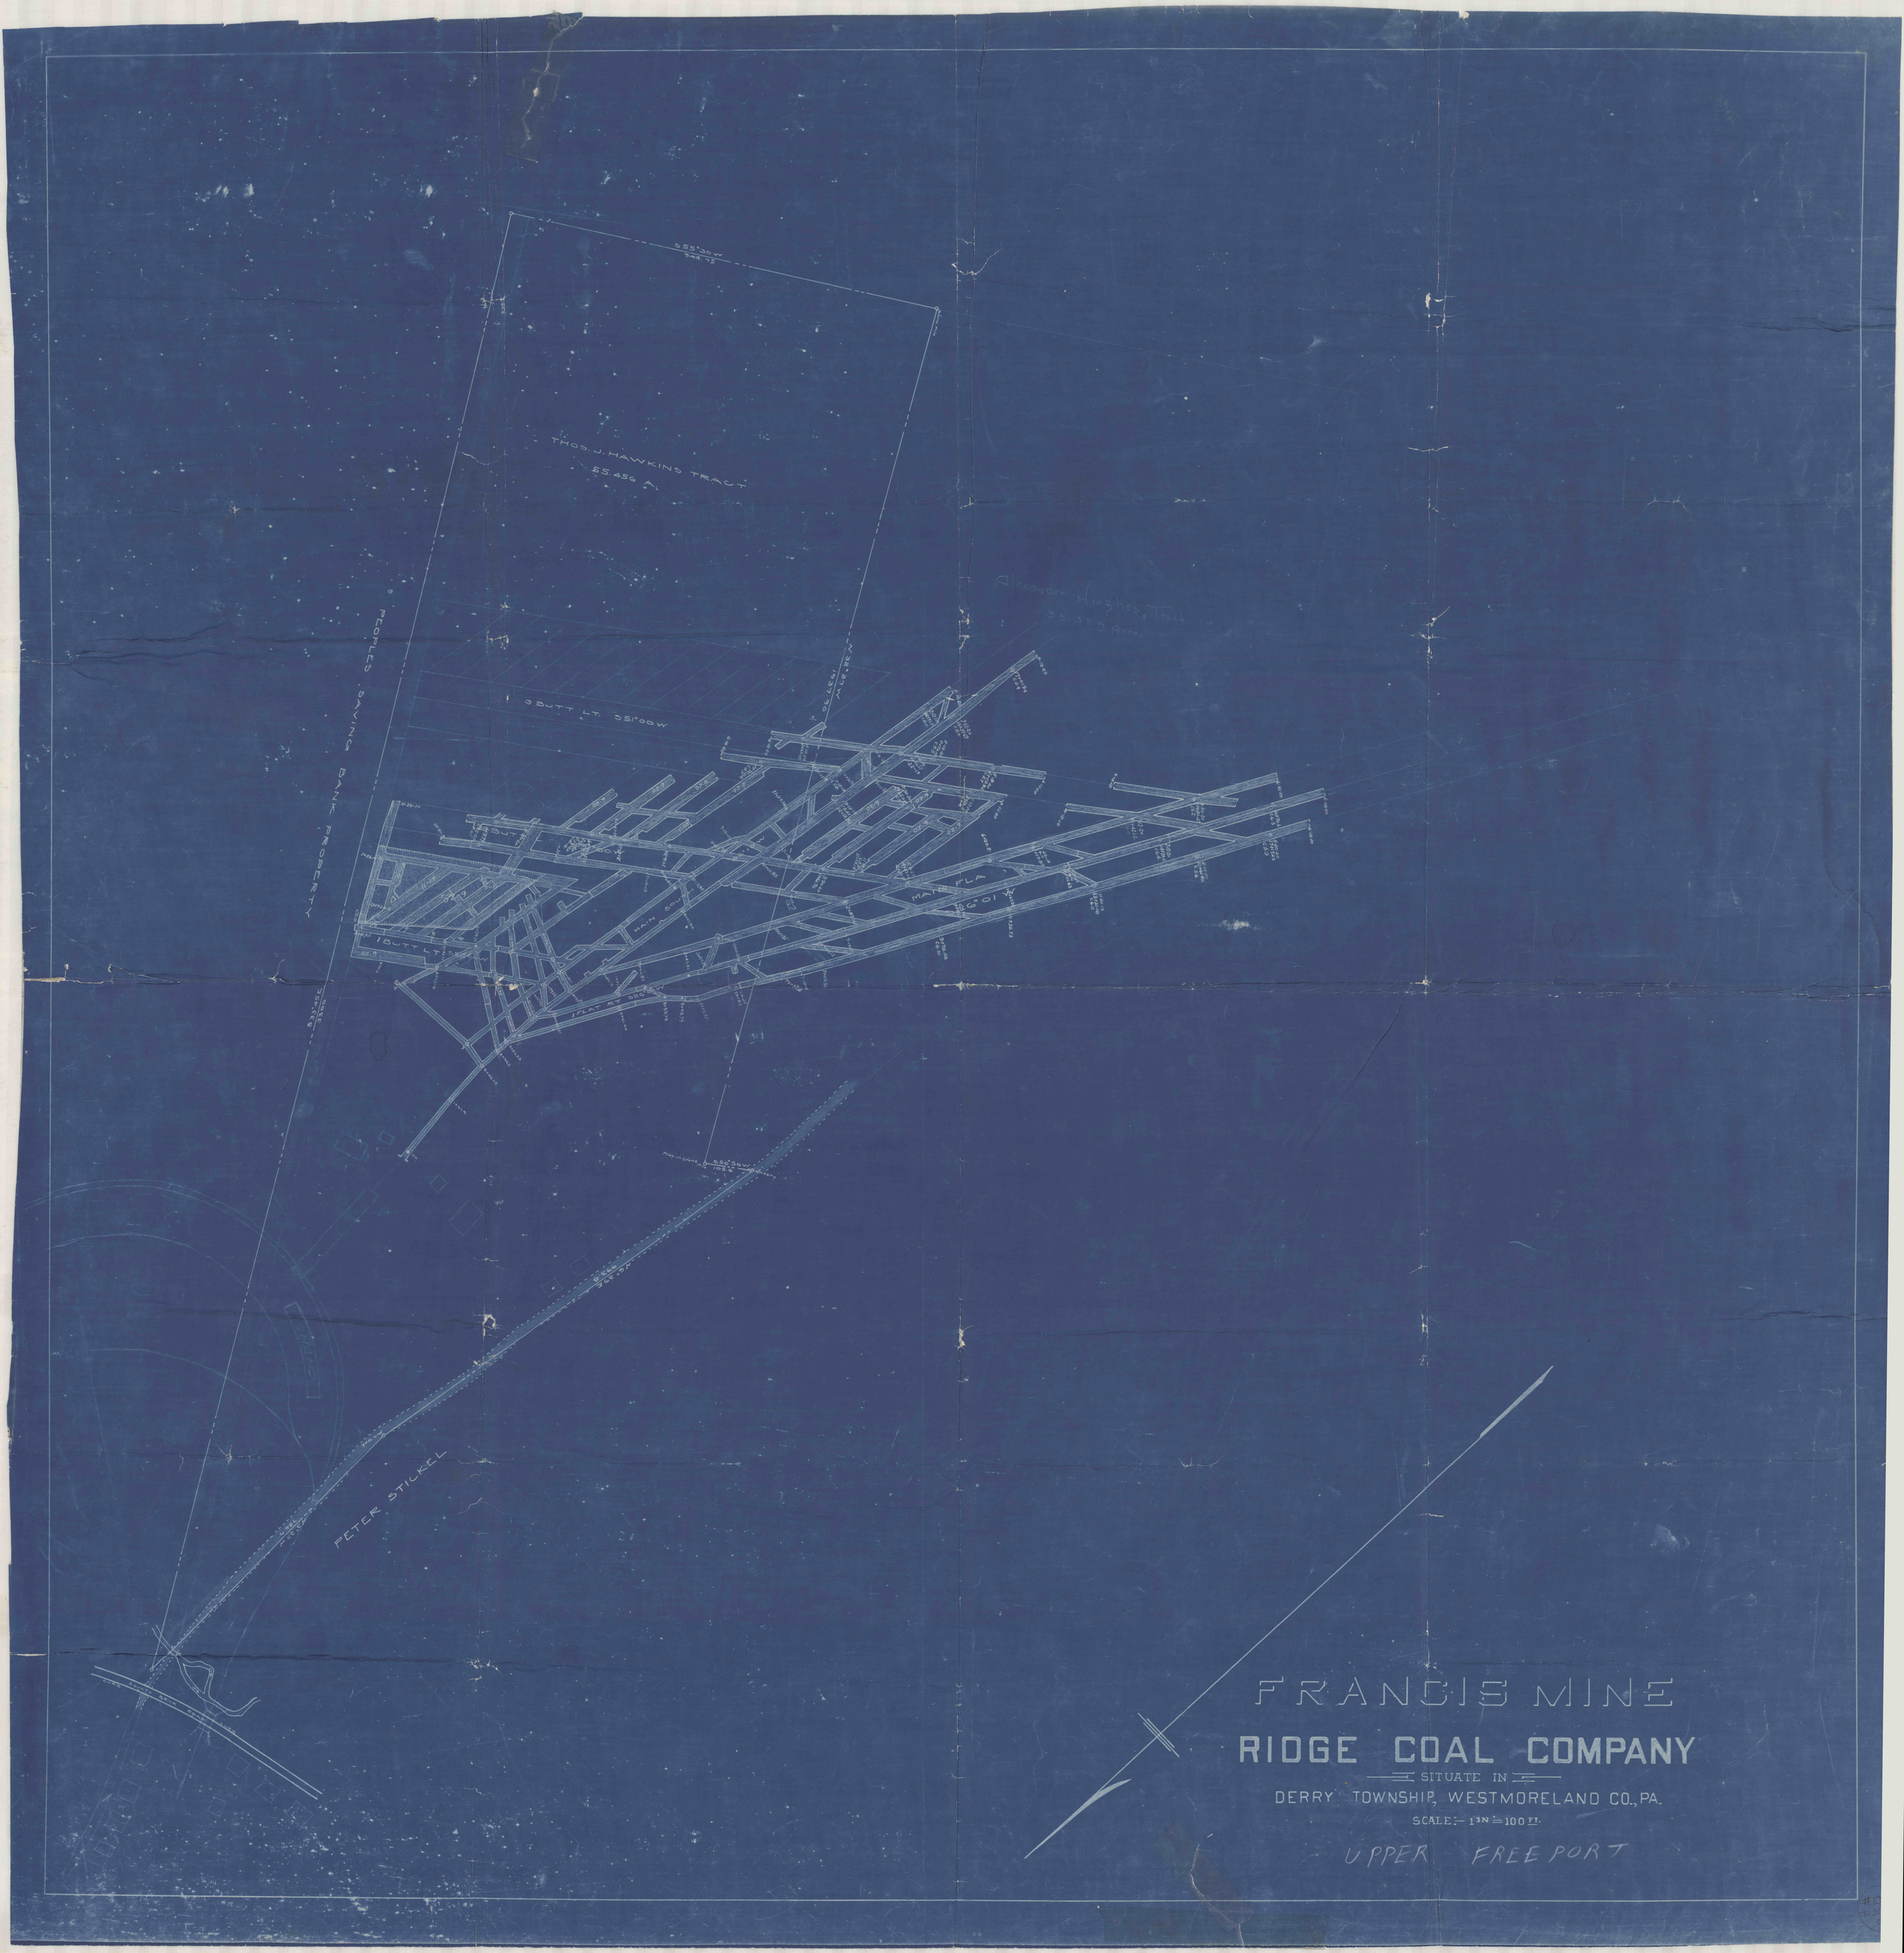
S 55° 30 W
348.75
THOS. J. HAWKINS TRACT
55.456 A.
PEOPLES SAVINGS BANK PROPERTY
S 34° 45' E
2000
3 BUTT LT. S 51° 00 W
1 BUTT LT
MAIN SOUTH
MAIN FLAT
S 6° 01 W
1 FLAT AT S 52°
S 22° 30 W
PETER STICKEL
FRANCIS MINE
RIDGE COAL COMPANY
SITUATE IN
DERRY TOWNSHIP, WESTMORELAND CO., PA.
SCALE:- 1 IN = 100 FT.
UPPER FREEPORT