

THE DEWEY ESTATE
Lot #17


FRAZIER COAL CO.
EAST BRADY PA.
LOWER KITTANNING VEIN
BRADY'S BEND TWP. ARMSTRONG CO. PA.
Scale 1"=100'

Surveyed 10-25-1949

E.J. WILSON R.S. 6574

REVISED NOV. 26-60

Recent Survey
Proposed Development

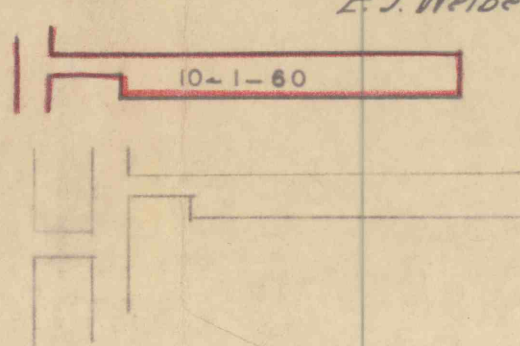

1035
7-20-97
C.C.