

Graff Engineering Co.
Blairsville, Pa.

Coal Property
Workings - Next 6 Months
Permit Area
Mined Out
No Dwellings
Date - December 19, 1967 to June 19, 1968

Nick Barndt

Stop

North

South

S.C. Berkebile Surface
Coleman & Gindelsberger Mineral
Mineral

Old Workings
Caved - Abandoned

D.D.H.

2.00 Ac. Reservation

old drift c.

INDEX TO SURVEYS

Survey	Date
B	9-25-58
C	6-1-65
D	3-15-67


S. 74°-20' E.

No. 2 Drift

No. 1 Drift

c. outcrop

c. outcrop

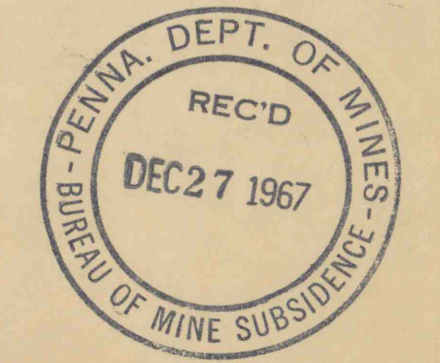

BERKEBILE BROS. COAL CO.

FORMERLY THE B. QUALITY COAL CO.
C PRIME MINE

SHADE TWP., SOMERSET CO., PA.

SCALE 1"=100' - REVISED BY S.E. DICKEY & CO. - SEPT. 27, 1958
CIVIL AND MINING ENGINEERS
JOHNSTOWN, PA.

Note: Survey "D" from information furnished - T.L.L.

Note: Survey "C" from information furnished - T.L.L.

84A-181
F.B. 325 Pg. 47

#1088
7-20-99
C.B.