


I HEREBY CERTIFY THAT THIS MAP IS A TRUE AND CORRECT COPY OF THE COAL MINE OF THE FREEPORT BRICK CO. AND THAT THE ORIGINAL MAP IS A TRUE, COMPLETE AND CORRECT MAP SHOWING ALL EXCAVATIONS MADE IN THIS MINE AT THE TIME OF ABANDONMENT  
DATE NOV 6 1913  
REGISTERED ENGINEER

PLAN OF  
FREEPORT CLAY PRODUCTS CO.  
COAL MINE  
FREEPORT PENNA.  
SCALE 1"=100' NOV 1913

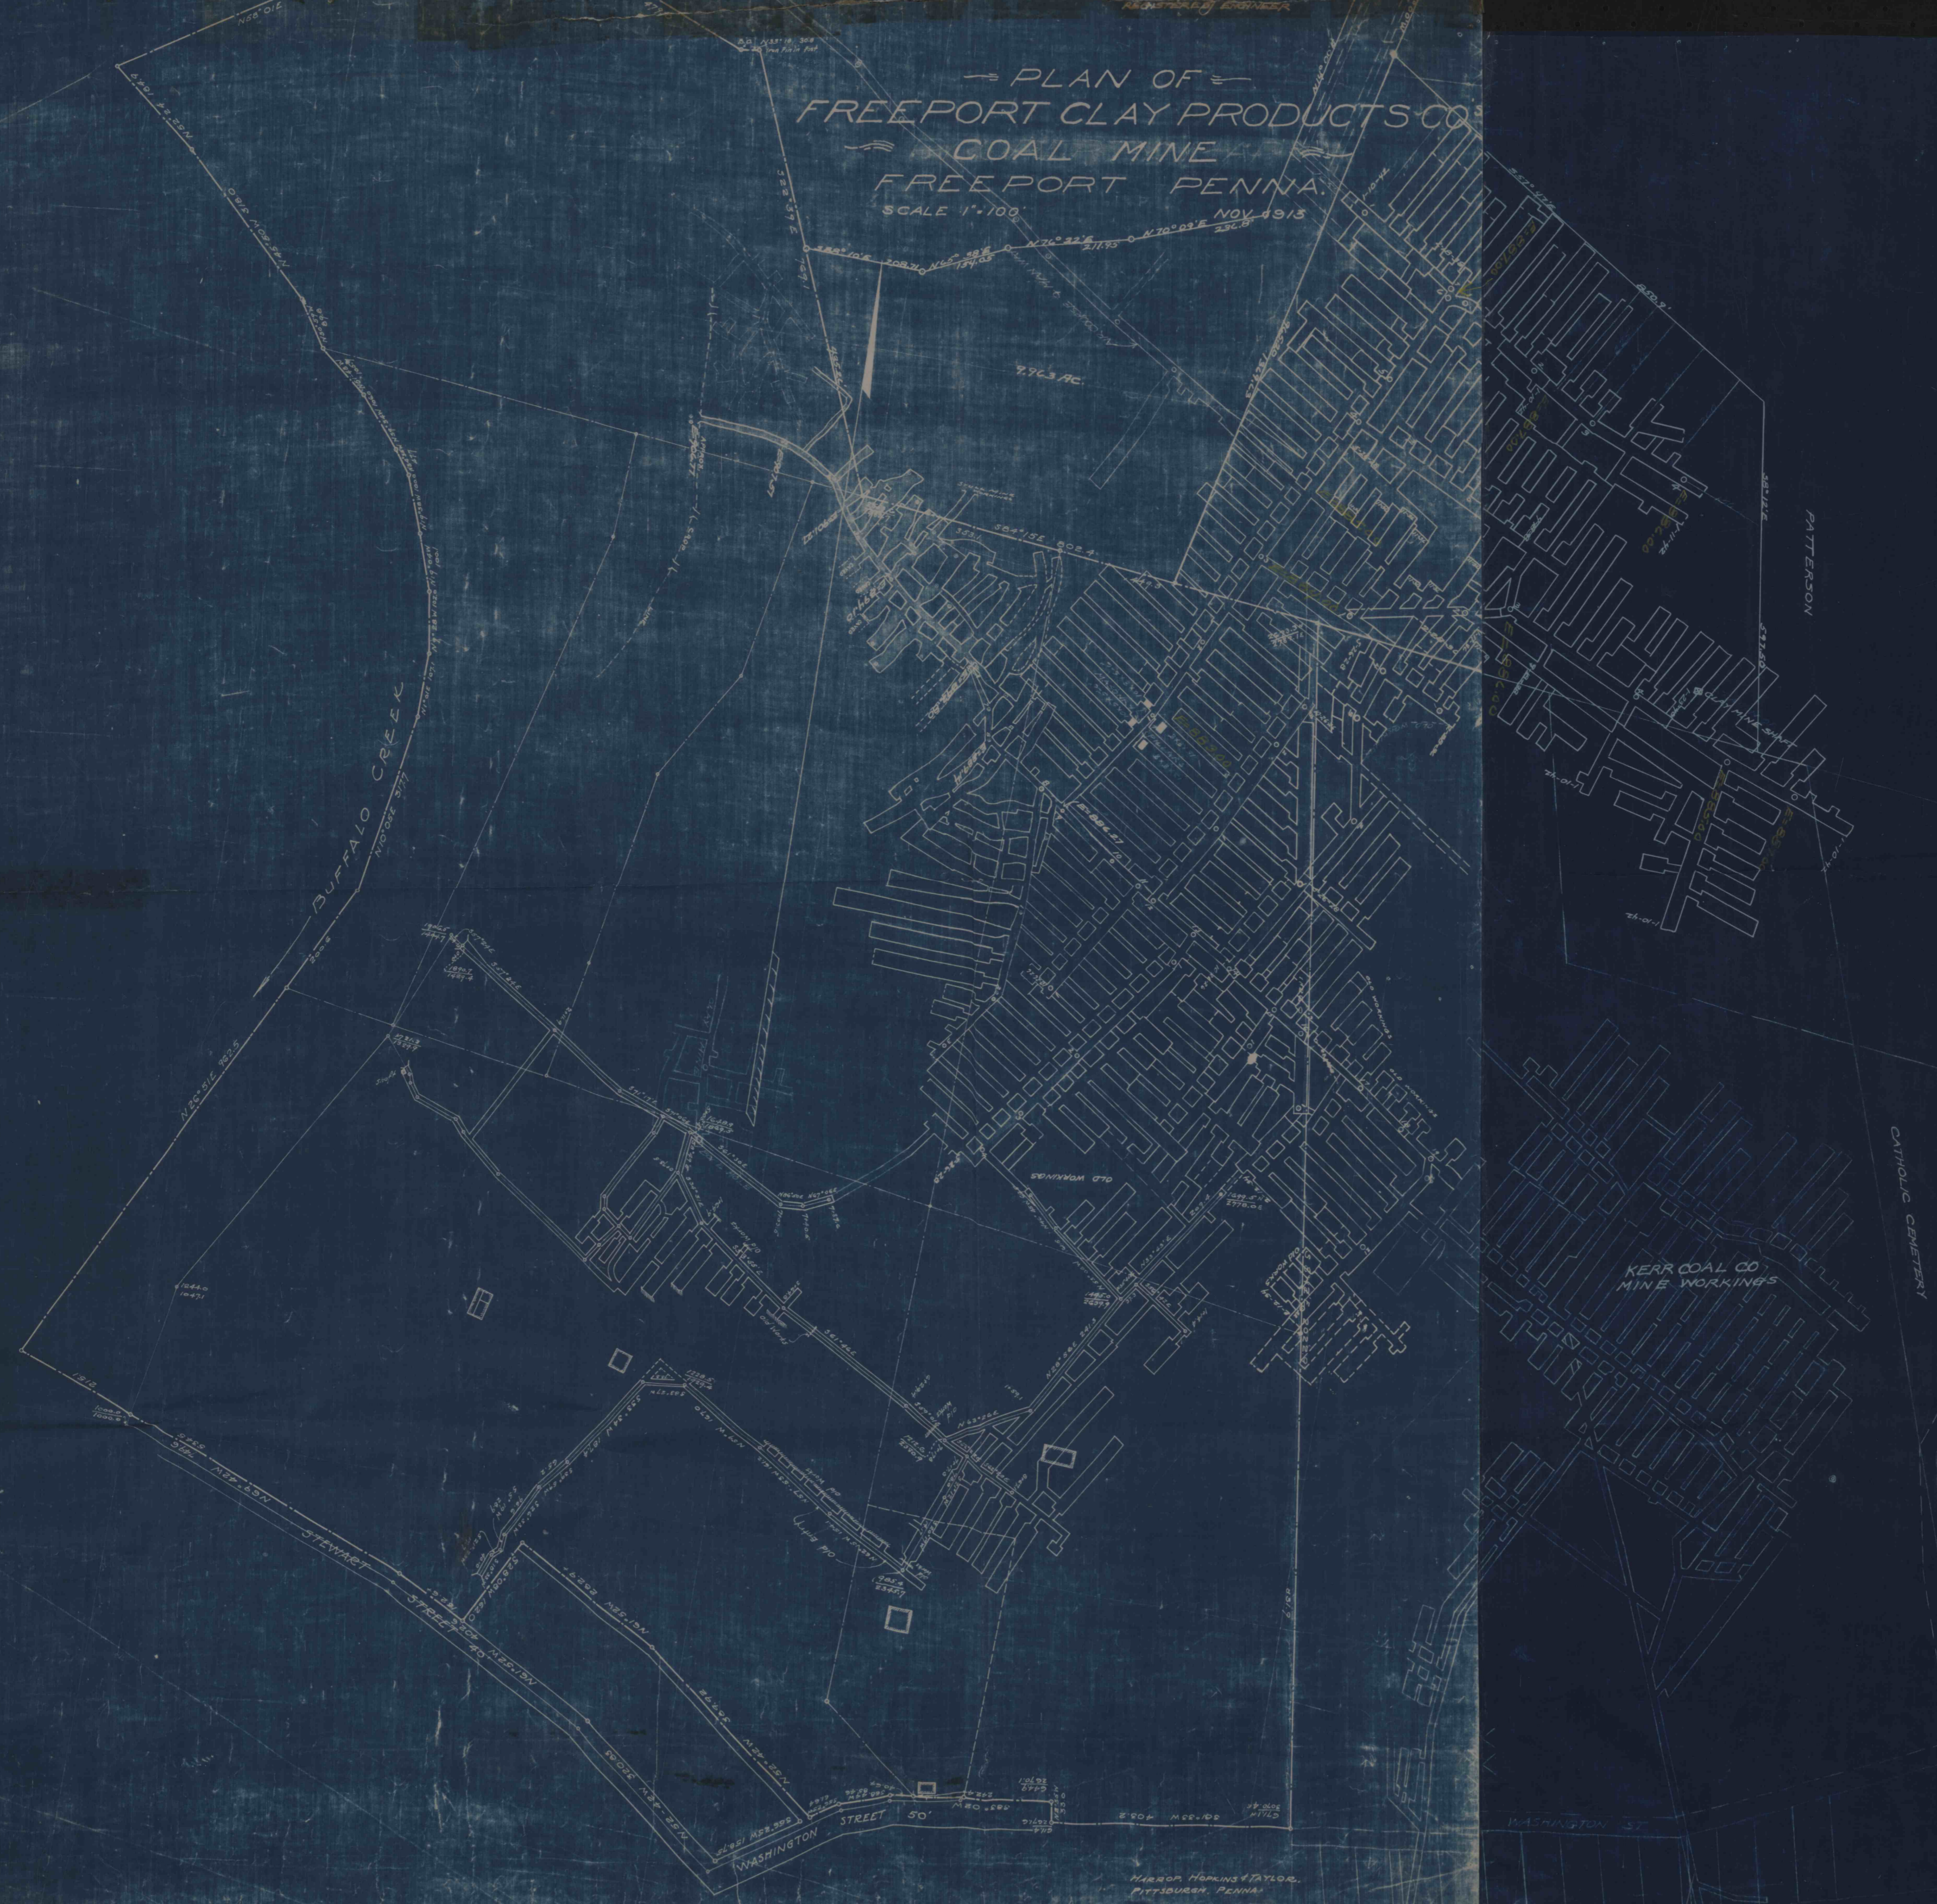

MICHAEL HOPKINS & TAYLOR,  
PITTSBURGH, PENNA.