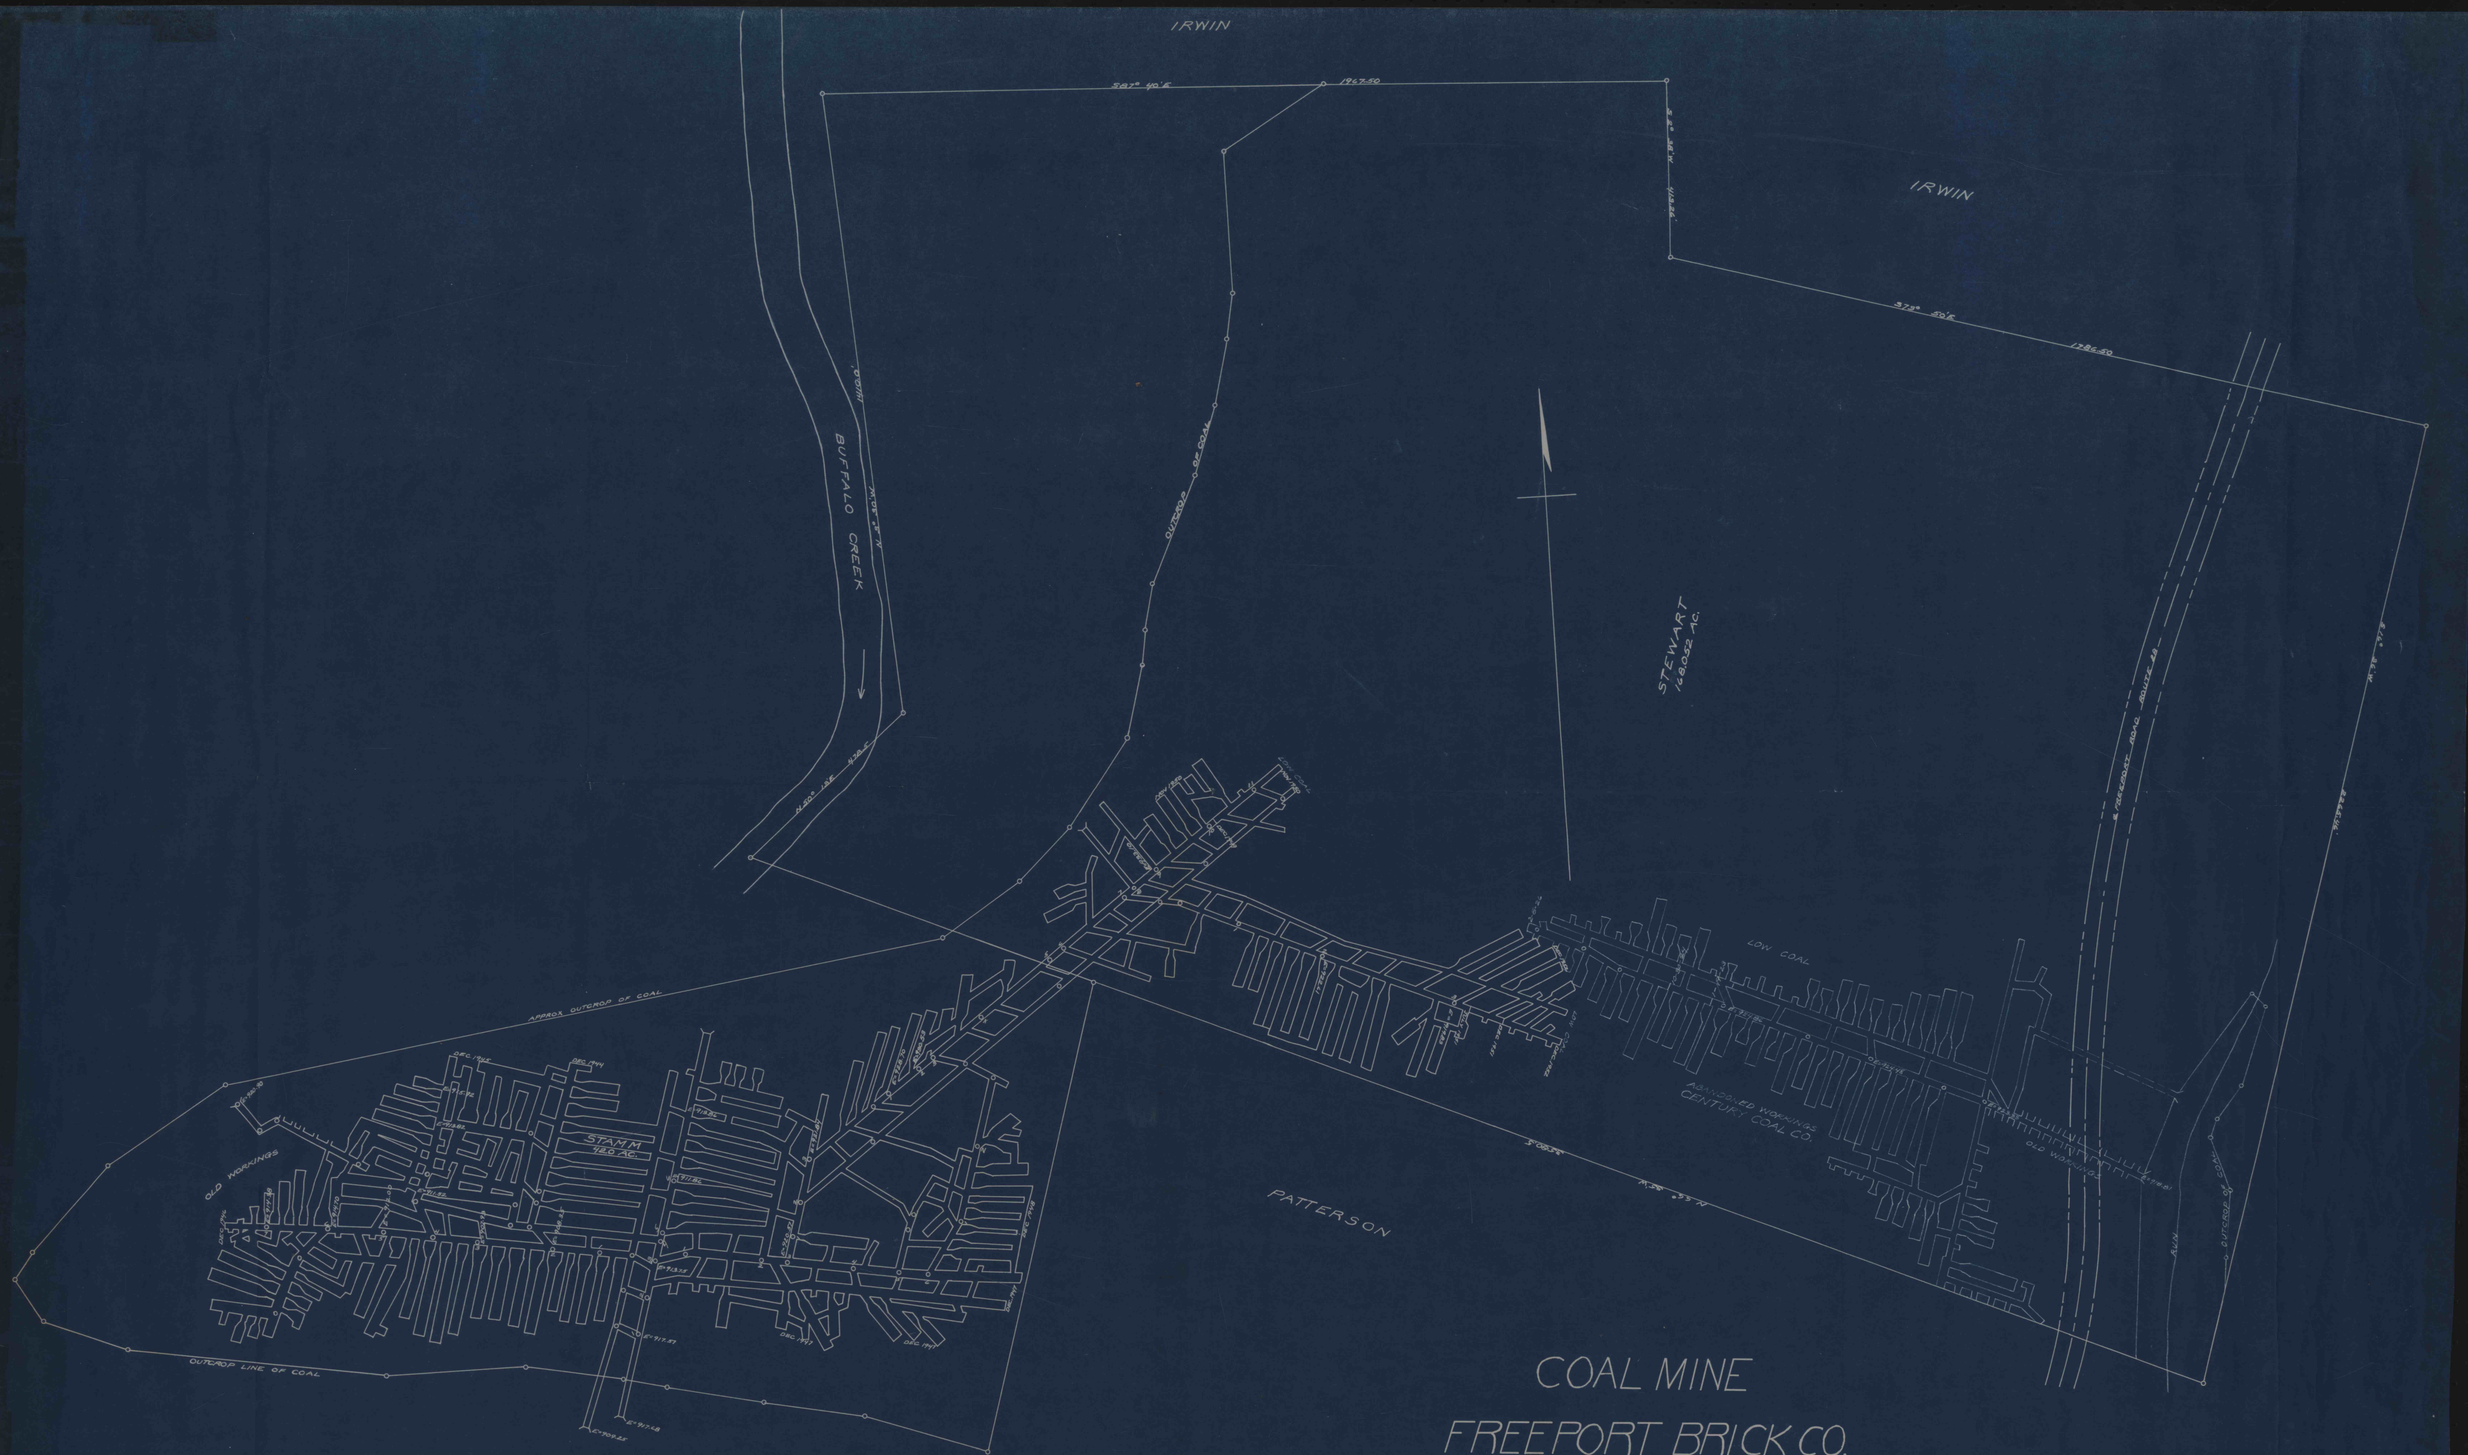

COAL MINE
FREEPORT BRICK CO.
FREEPORT PA.

SCALE 1"=100'

DECEMBER 19, 1953

D.E. TAYLOR E.M.