

L.I. GORMAN-SURF  
J & C.D GORMAN TRACT

L.I. GORMAN-SURF  
M. CARNAHAN TRACT

JOHN BUGAY-SURF

J. P. PRUSHNOK-FEE  
A. Mc CRACKEN TRACT

GEO VOYTUS-SURF  
GEO. McAFEO'S TRACT

JESS LYDIC-SURF

STEVE VOYTUS-FEE  
A. Mc CRACKEN TRACT

J. P. PRUSHNOK-FEE


SURVEY NOTES 2-10-1967

STA. 2-3	N 23° 45' W
" 3-4	N 30° 16' W
" 4-5	N 60° 47' W
" 5-6	N 73° 05' W
" 6-8	N 58° 42' W
" 8-9	S 74° 30' W
" 9-10	S 51° 36' W
" 12-13	N 29° 38' E

- LEGEND
- 28A PROPERTY OUTLINE
  - \* MINED OUT 2-10 TO 8-10-1967
  - PRO. 6 MONTHS PROJECTIONS 2-10 TO 8-10-1968
  - MINED OUT PRIOR TO 4-27-1966 ACT
  - \* MINE SHUT DOWN 4-1-67. WAITING FOR WATER PERMIT
  - NO BUILDINGS IN MINING AREA

FIELD COPY

PROPERTY MAP  
 FRENO COAL COMPANY, No 3 MINE  
 UPPER FREEPORT (E) COAL SEAM  
 MONTGOMERY TWP, INDIANA COUNTY, PA.  
 SURVEY & MAP T. HOWARTH 2-10-14-1967  
 SCALE: 1"=100' DIRECTED BY A.K. BLOOM, P.E.  
 REVISED: 8-10-67, REV. 2-26-1968

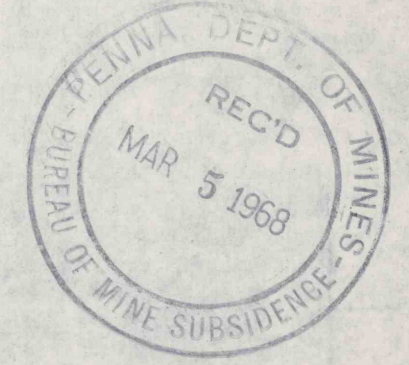

SEAL

#1044  
4-20-99  
A.K. Bloom, P.E.