



DELMONT FUEL CO
RESERVATION
DELMONT FUEL CO

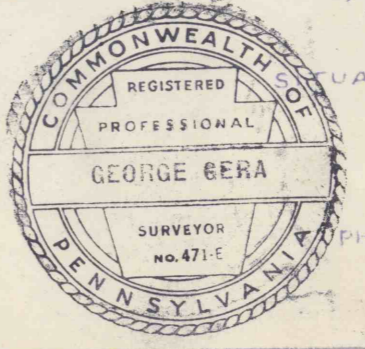

- MINING COMPLETED
- LEASE LINE.
- COAL REMAINING

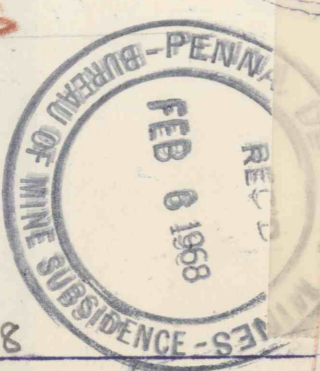

MINE MAP
WORKINGS IN UPPER FREEPORT VEIN
DATE IN EAST HUNTINGDON TWP WESTMORELAND CO, PA
OPERATED BY
HOUGH & FRICANO
SCALE 1"=100'
DEC 20, 1946
PHONE 783 W B BARNHART CE REG NO 4567
REGISTERED PROFESSIONAL ENGINEER
806 MARKET ST, SCOTSDALE PA

JAN. 1968

Surf. 1023±

TO BE MINED DURING NEXT 6 MONTHS To 7-68

#1042
7-20-68
C.C.