


N

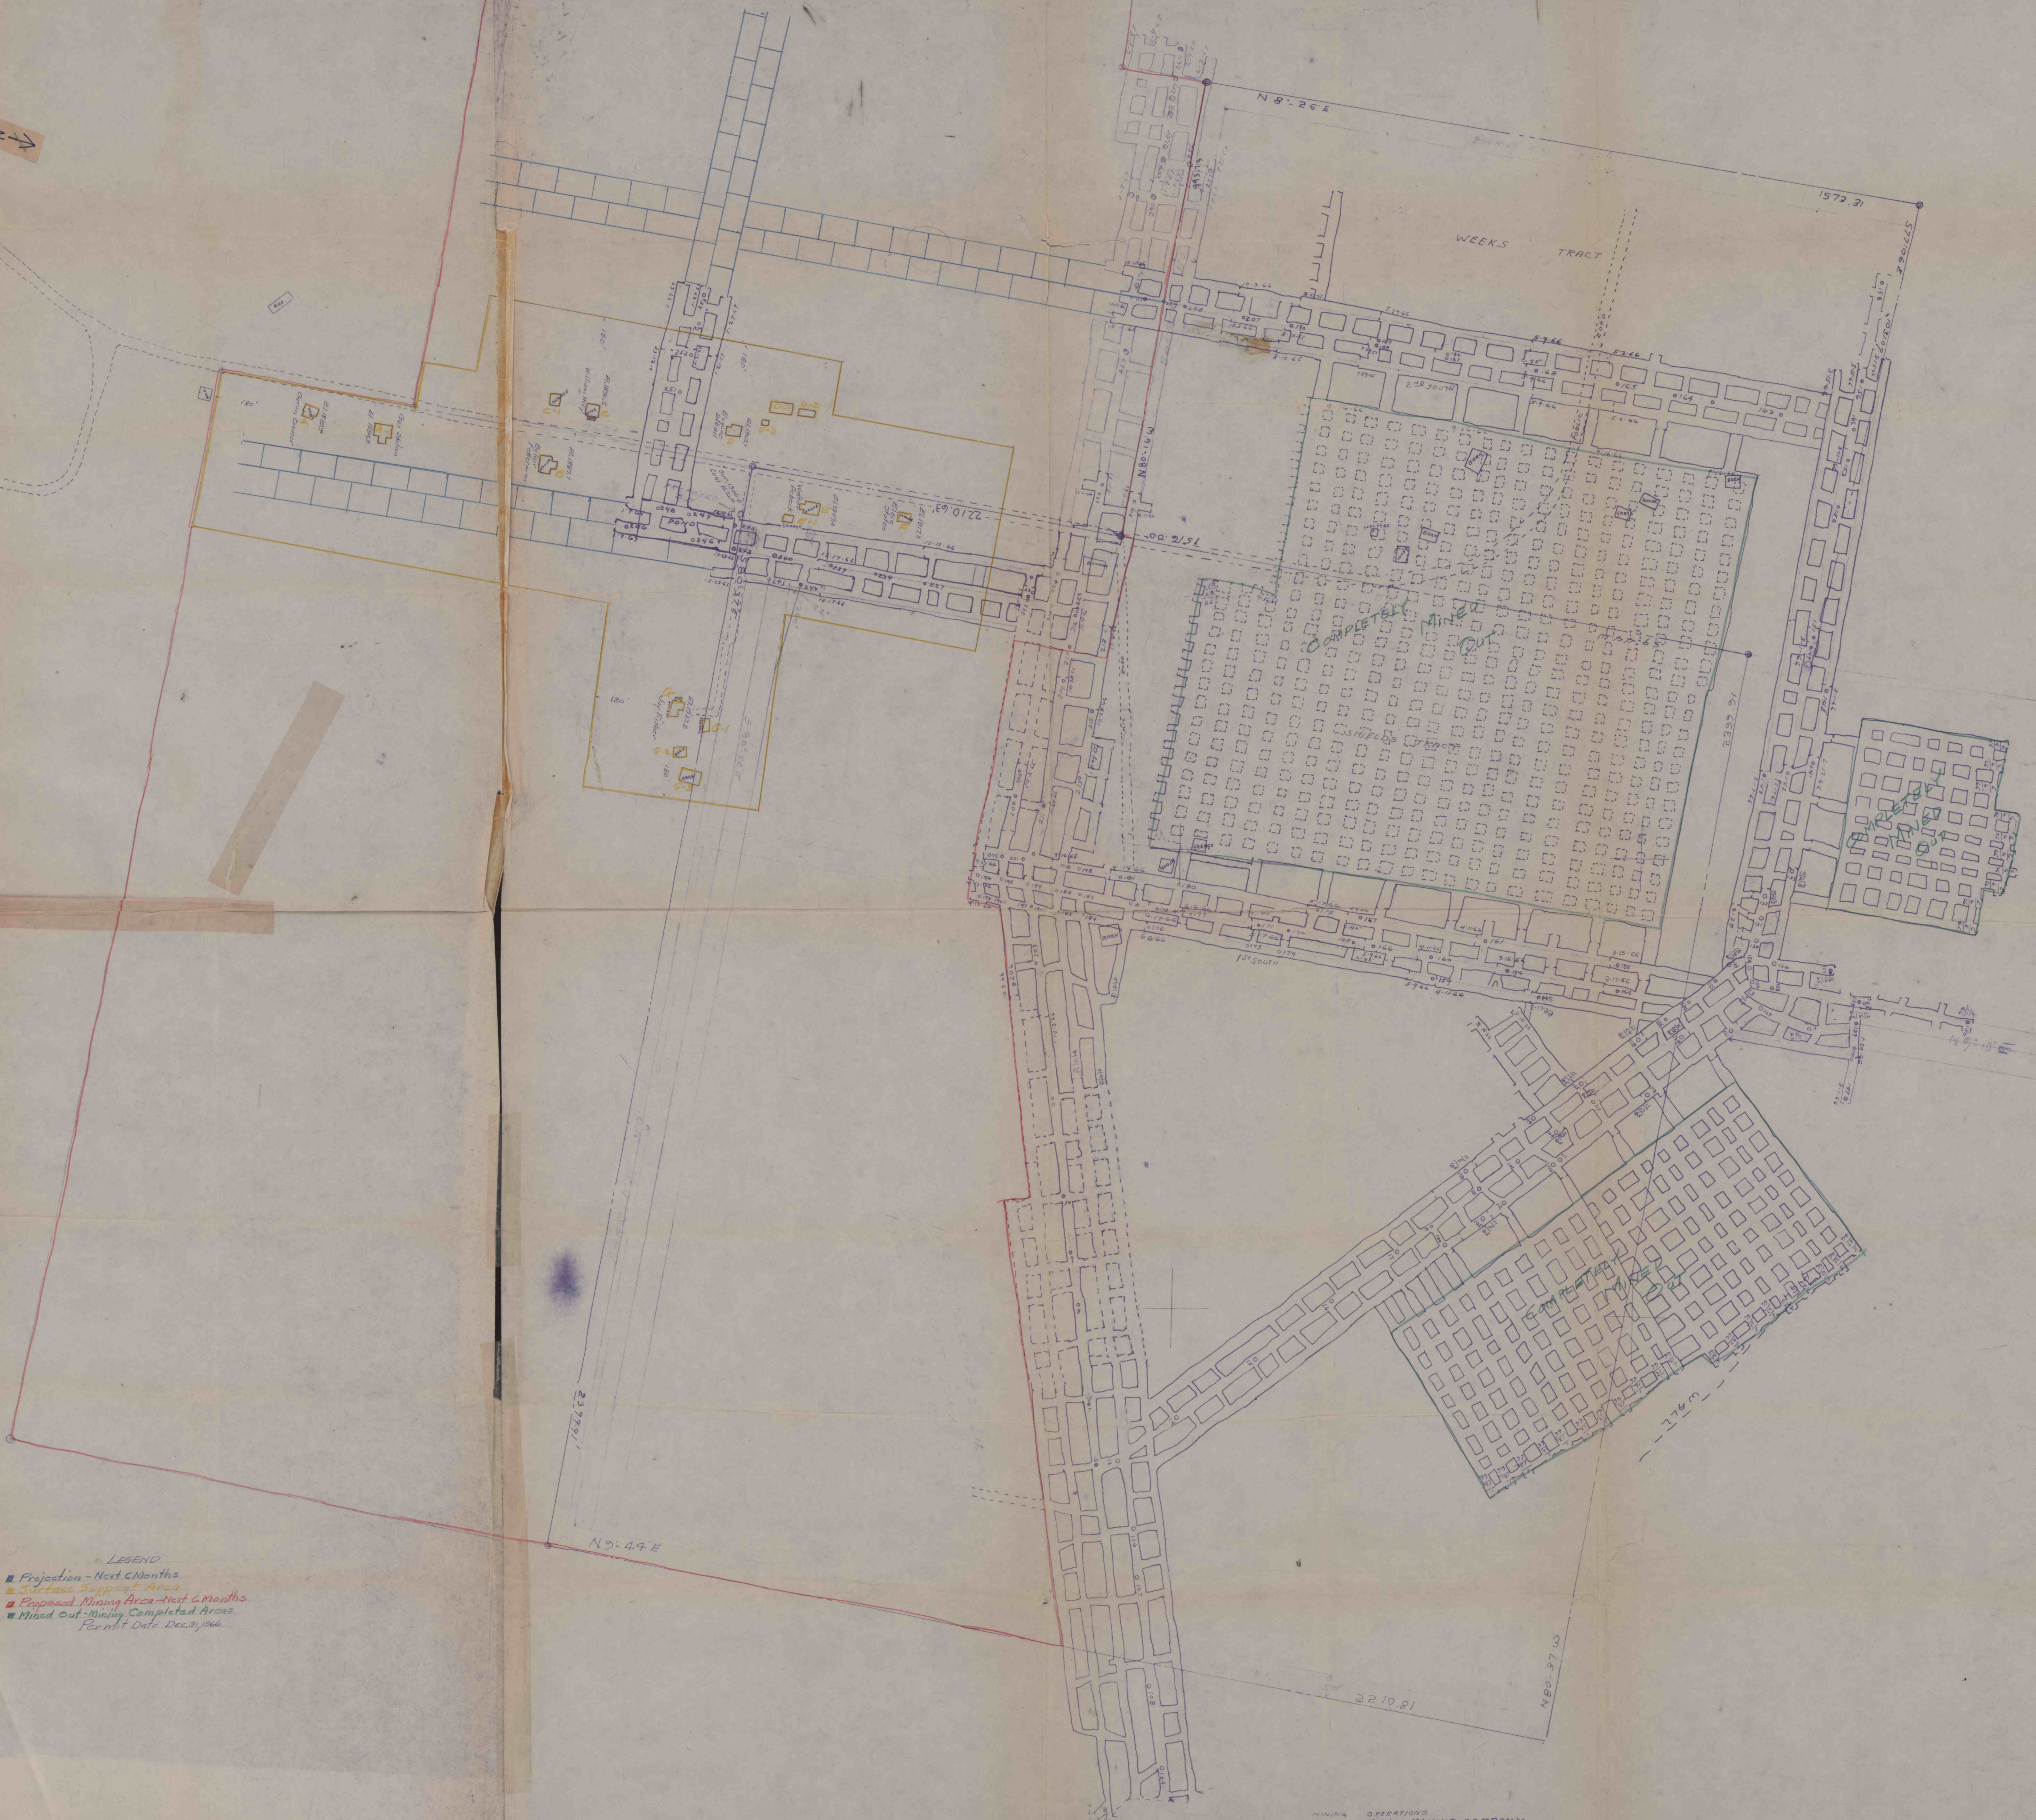

MINING OPERATIONS  
 FRIEL-MARSHALL COAL MINING COMPANY  
 SITUATE IN  
 BANKS TWP INDIANA CO PENNA  
 SCALE 1"=100' JANUARY 1966  
 GRAFF ENGINEERING COMPANY  
 PITTSBURGH PA

#107  
 7-25-66  
 CL