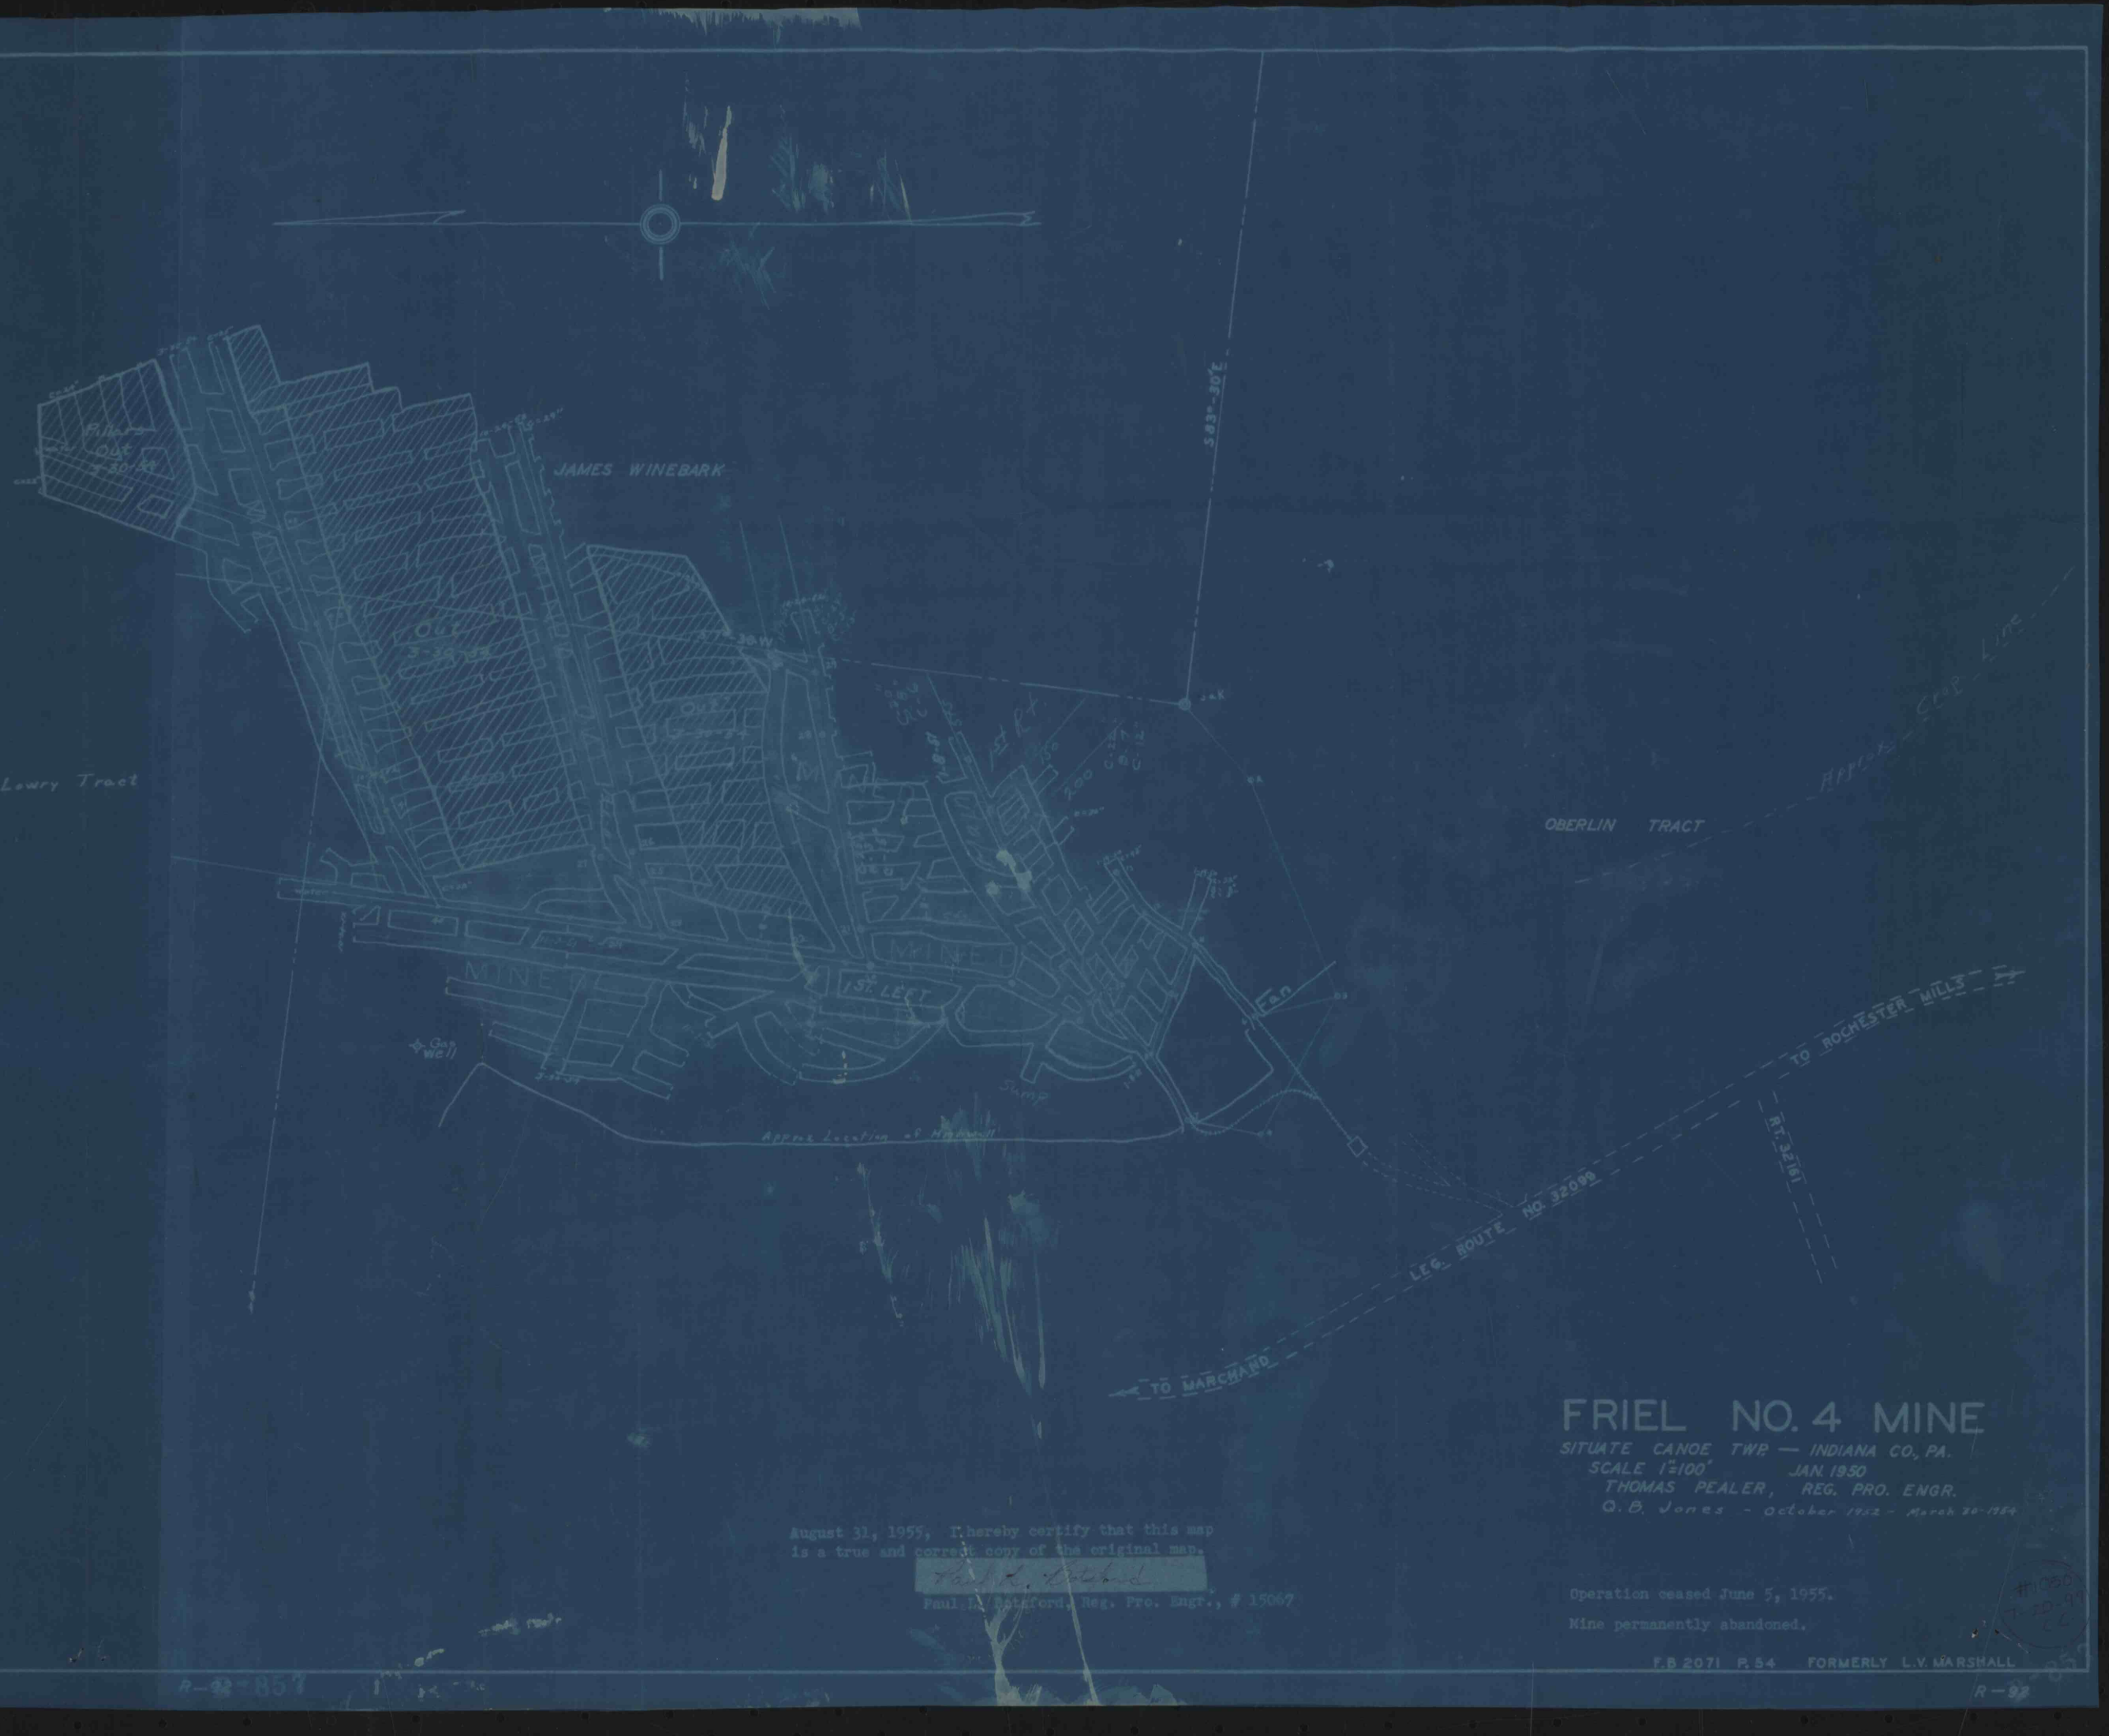

FRIEL NO. 4 MINE

SITUATE CANOE TWP. — INDIANA CO, PA.
SCALE 1"=100' JAN. 1950
THOMAS PEALER, REG. PRO. ENGR.
Q.B. Jones - October 1952 - March 30-1954

August 31, 1955, I hereby certify that this map is a true and correct copy of the original map.

Paul E. Rathford

Paul E. Rathford, Reg. Pro. Engr., # 15067

Operation ceased June 5, 1955.

Mine permanently abandoned.

F.B 2071 P. 54 FORMERLY L.V. MARSHALL

R-93