


HARMON CREEK COAL CO.
 MAP OF WORKINGS, FULTON MINE NO. 1
 BURGETTSTOWN, PA.

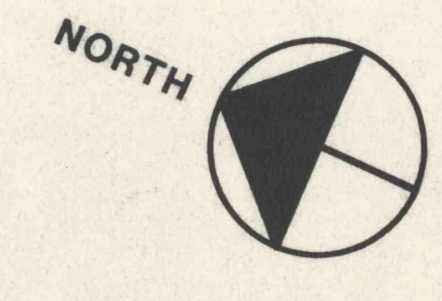

SCALE 100' = 1"

- WORKING
- WORK
- MINED OUT SINCE AUG. 1920
- HALL
- TERRACE

PROGRESS COMPLETE TO
 NOV. 6, 1920
 JAN. 15, 1921
 DEC. 15, 1922

D. J. Jones - 105 DEPT. ENGINEER
 Dec. 1922