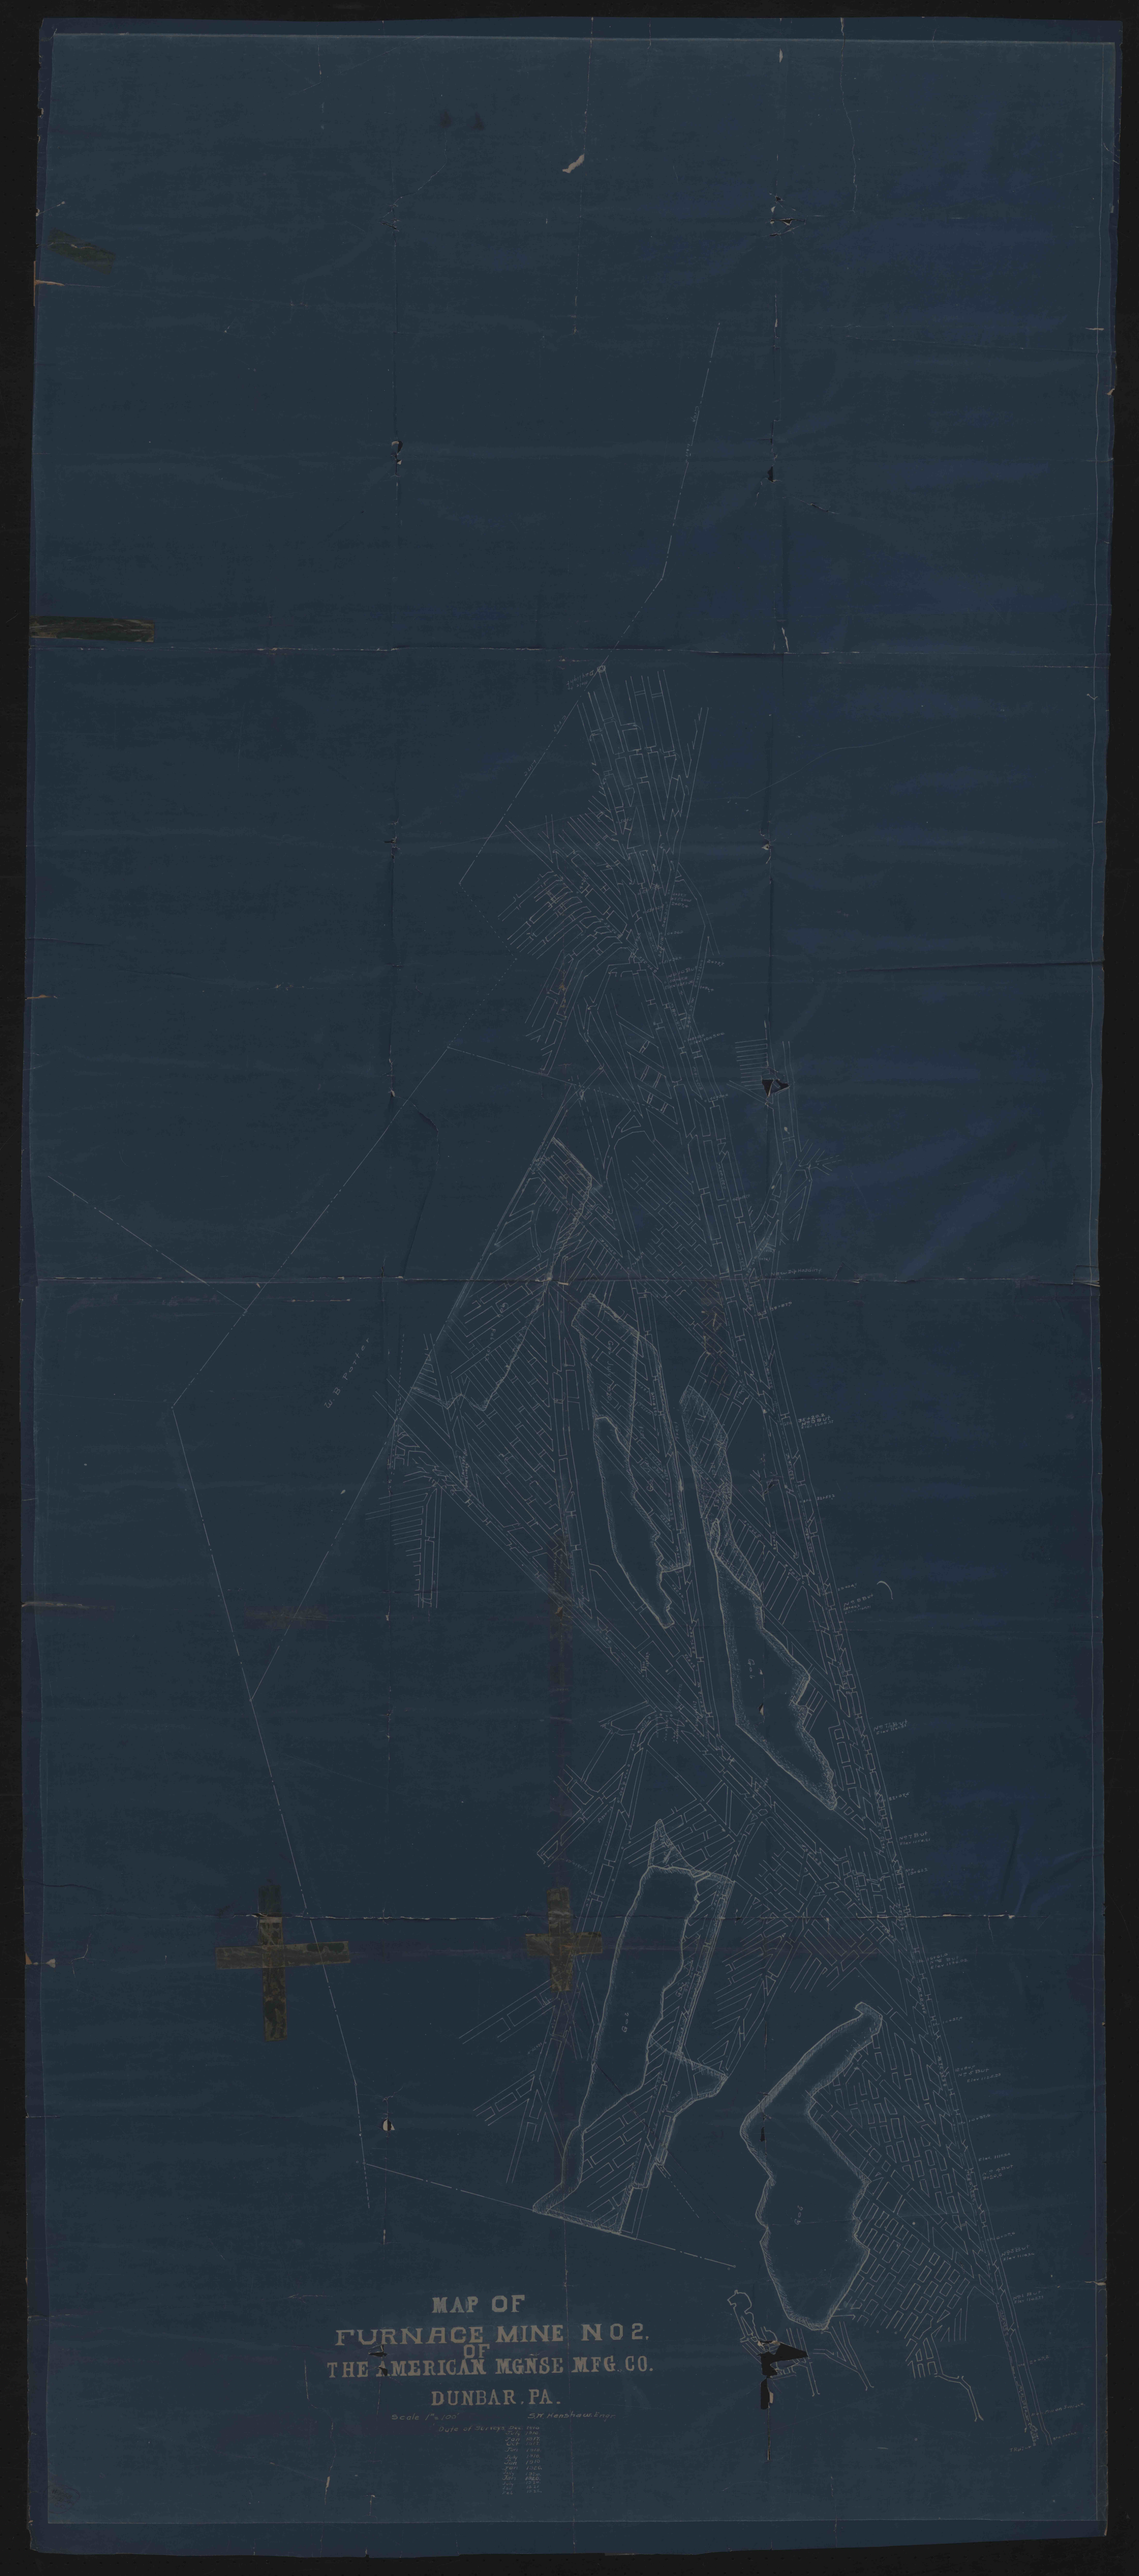
MAP OF
FURNACE MINE NO 2.
OF
THE AMERICAN MGNSE MFG. CO.
DUNBAR. PA.
Scale 1"=100'
S.M. Henshaw Engr.
Date of Survey Dec 1906
Jan 1907
Feb 1907
Mch 1907
Apl 1907
May 1907
June 1907
July 1907
Aug 1907
Sept 1907
Oct 1907
Nov 1907
Dec 1907