


CORNER SHADECK AIRS

CORNER

JAMES HOFFMAN

CAVED AREA ALL PILLERS HAVE BEEN DRAWN BY RALPH FYE  
HOFFMAN

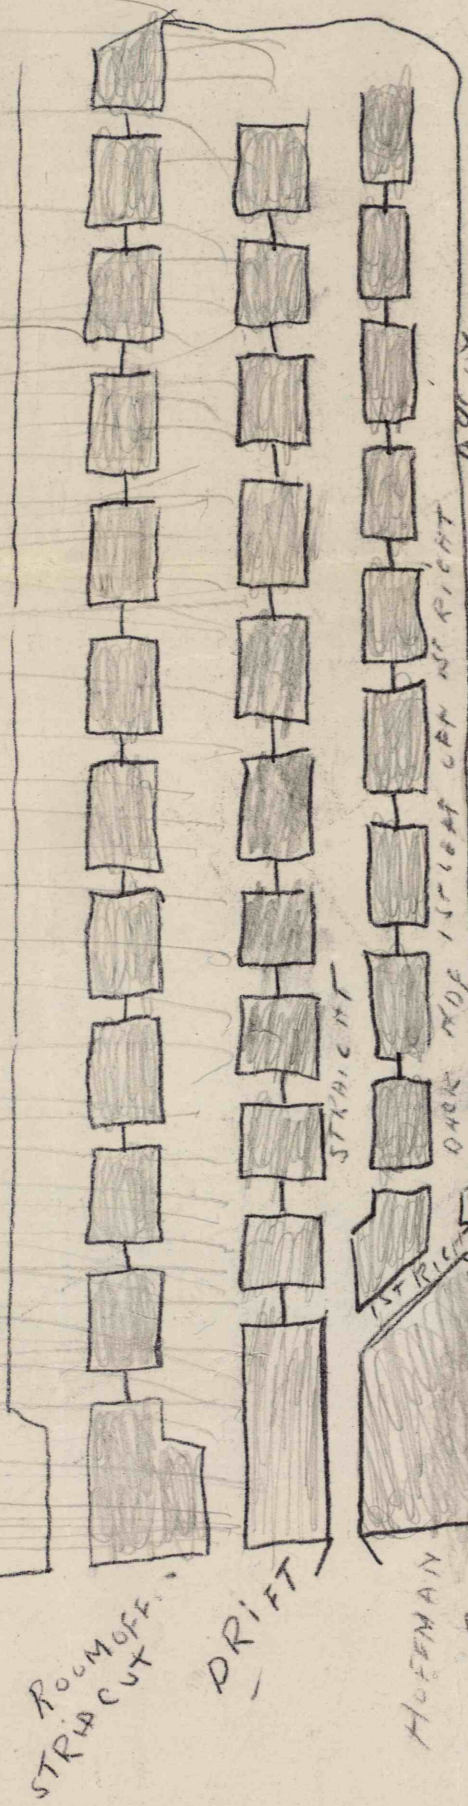

PROPERTY LINE  
REVROTH HOFFMAN  
GRUVER MOORE

THIS AREA WORKED OUT  
PILLERS NOT DRAWN

WORKED OUT

SOLID

STRIP CUT BACK FILLED  
MAGASINE

S  
D  
L  
O  
S

GONSALES COAL CO

ROOM OFF  
STRUCTURE

DRIFT

HOFFMAN

CORNER

FAN

32ft P... ..

CORNER

JAMES HOFFMAN

MAP OF RALPH F. EMMINE  
KARHAUS, PA.  
CLFD, PO.

#1059  
7-21-99  
CC.