


PENNA COAL & COKE CO

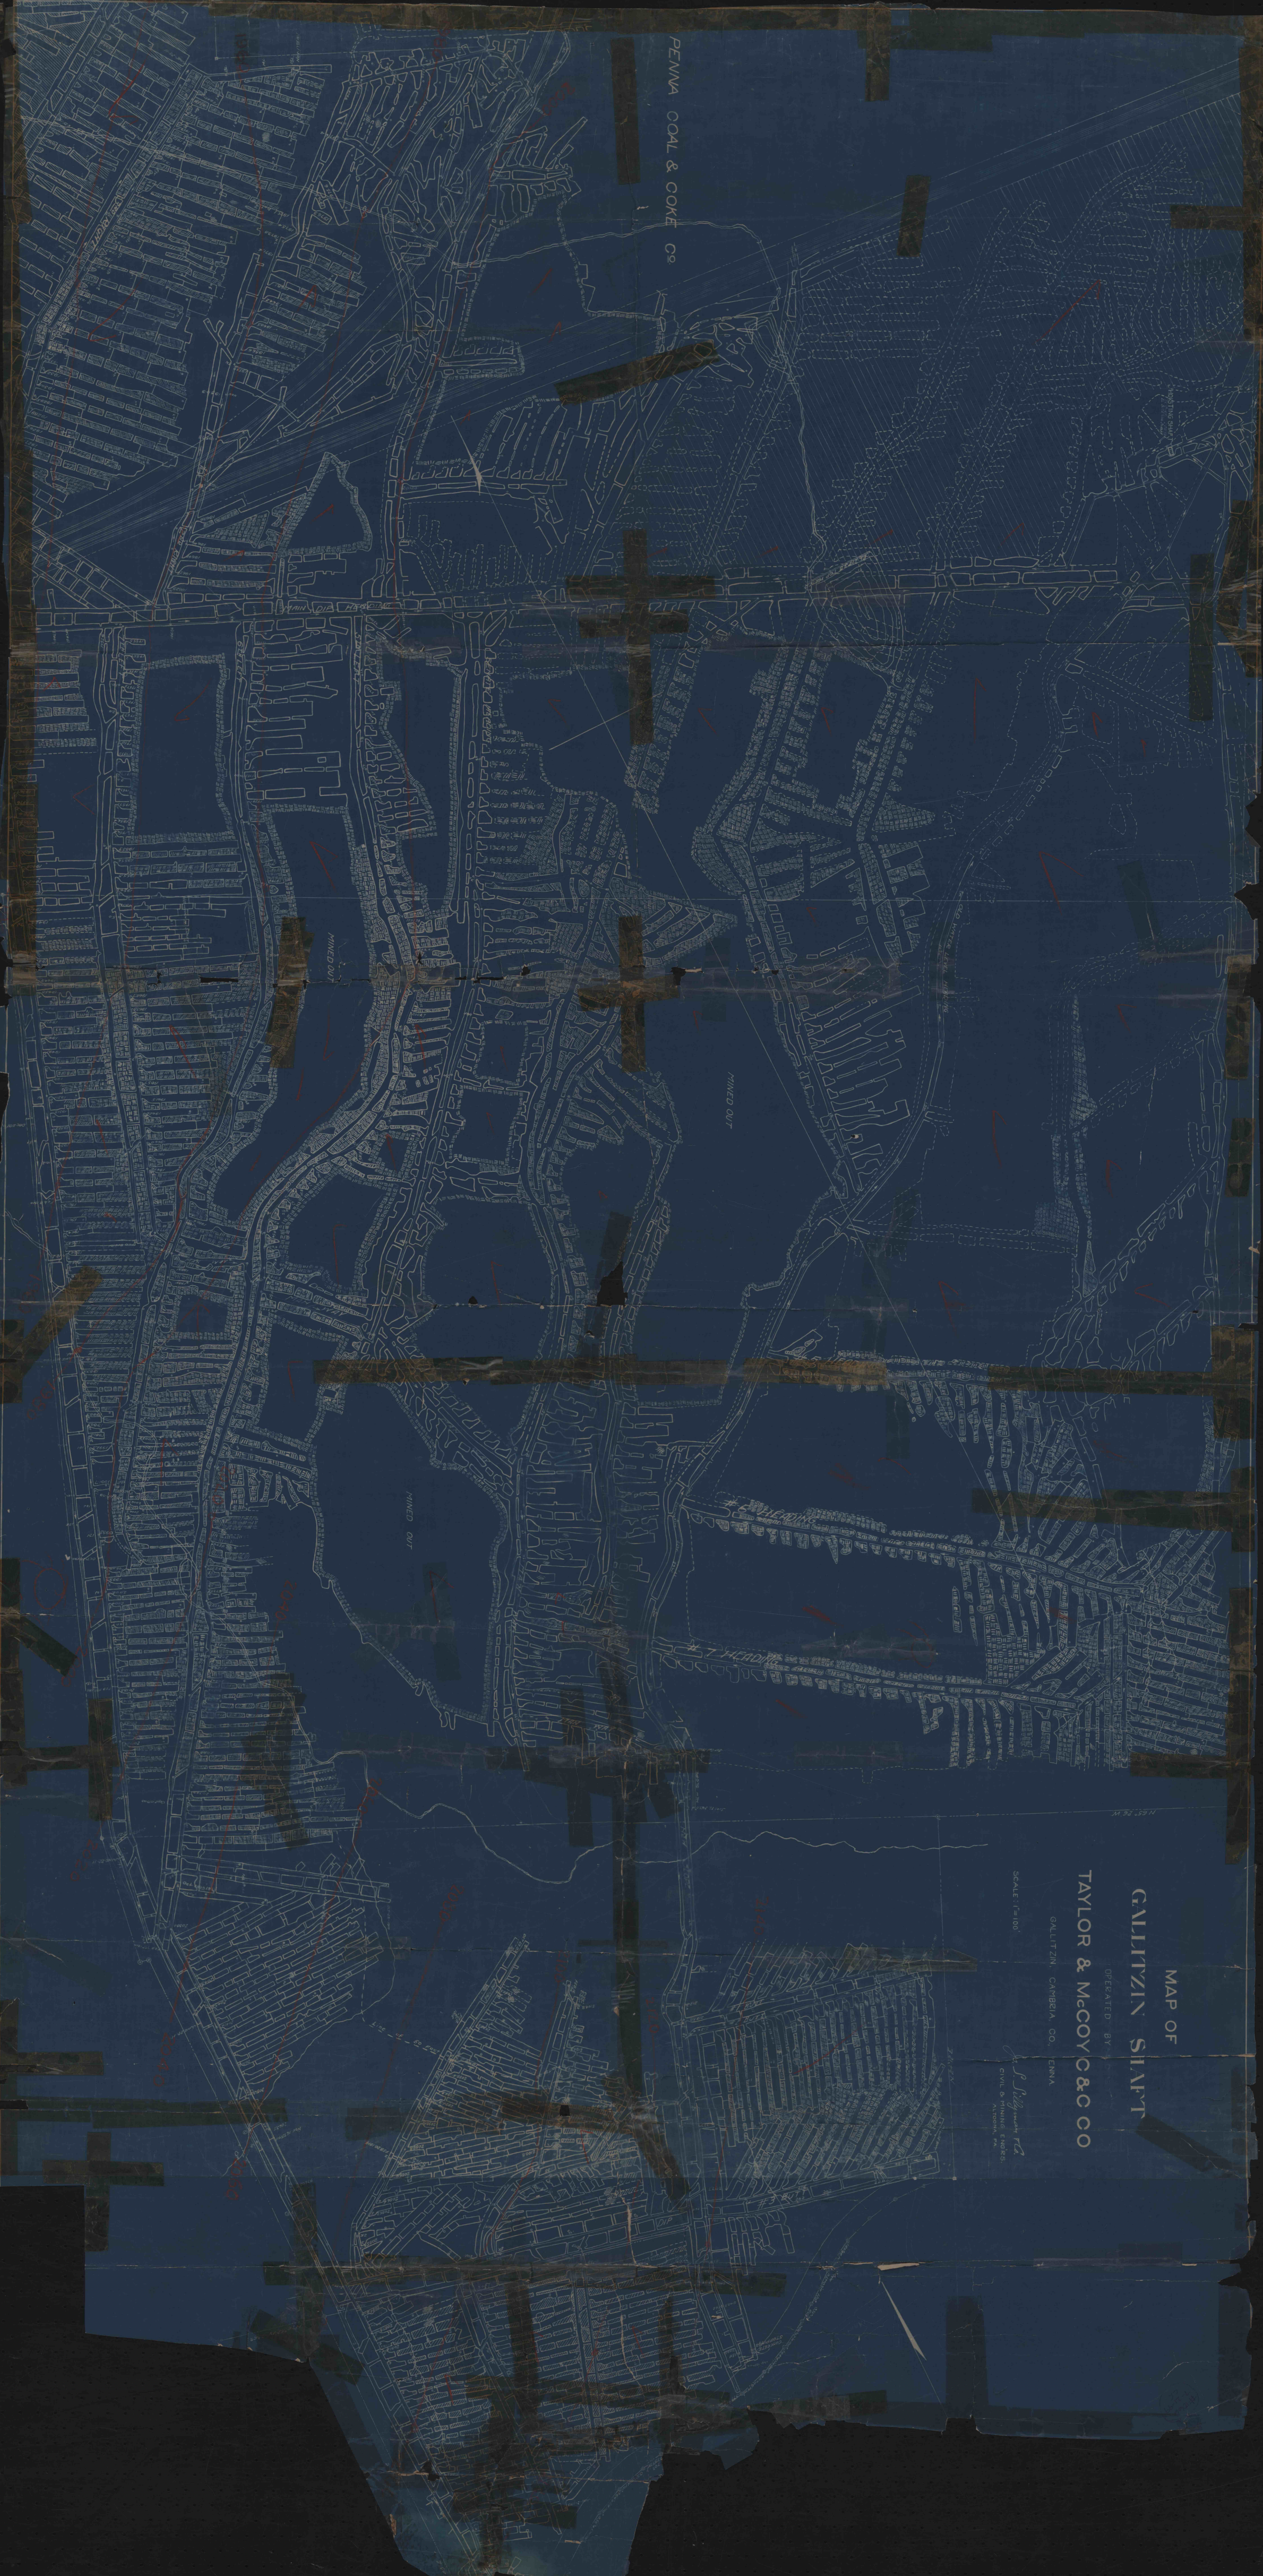

MAP OF
GALLITZIN SLAFT
OPERATED BY
TAYLOR & MCCOY & CO

GALLITZIN, CARBRIA, CO., PENNA
SCALE 1"=100'
J. S. McCoy
CIVIL & SURVEY ENGINEER
ANDREWS, PA.