


LEGEND

DATE	SURVEY BY
SEPT. 1953	E.J. TAYLOR
NOV. 1956	E.J. TAYLOR
AUG. 7, 1962.	William A. Thistlethwaite 77100
March 20, 1963	William A. Thistlethwaite
Feb. 26, 1964	William A. Thistlethwaite
Dec. 14, 1964	William A. Thistlethwaite
MAY 2, 1966	William A. Thistlethwaite
March 3, 1967	William A. Thistlethwaite
January 21, 1968	William A. Thistlethwaite
FEBRUARY 3, 1969	William A. Thistlethwaite
JANUARY 27, 1970	William A. Thistlethwaite
MAY 1, 1971	William A. Thistlethwaite

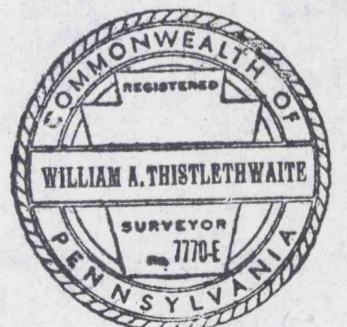

GAPEN MINE No 3
 DUNKARD TWP. GREENE, CO. PA.
 SCALE 1"=100ft. DATE SEE LEGEND
 VINCENT BLOUT OPERATOR
 UNIONTOWN, PA.

#1075
 7-21-69
 CC.