


JOSEPH WALBECK

WM REYNOLDS  
HEIRS

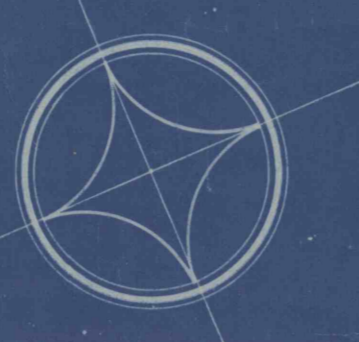

GARFIELD FIRE CLAY CO

S.M. LICHENFELT  
66.97 ACRES

HARRY CLINE  
974 ACRES

GARFIELD FIRE CLAY CO

TO BE RESERVED BY GARFIELD FIRE CLAY CO  
174 ACRES

GARFIELD FIRE CLAY CO  
TO  
GARFIELD SMOKELESS COAL CO  
696 ACRES

SLYNN

MRS REYNOLDS

LESTER LICHENFELT  
STREET

GEO BRENLINGER



GARFIELD SMOKELESS COAL CO.  
MAP OF  
"E" SEAM WORKINGS  
LOCATED IN  
WEST WHEATFIELD TWP. INDIANA, PENNA.  
Scale-1"=100' AB Grichton Dec. 1917  
Civil & Mng Engr  
Johnstown, Penna.

*W. L. Grichton*

CE-1  
84

1101  
1101  
1101