

HENRY W. RAU

VICTOR B. FULLER

AL & R. J. RUPP

JAY R. BOWSER
82.23 ACRES
UPPER FREEPORT COAL

Worked Out


GAS WELL
SURF. ELEV. 11428.8
B.M. ON TOP OF SURFACE
ELEV. 11420.17
#3

GAS WELL
SURFACE ELEV. 1171.01
B.M. ON TOP OF SURFACE
ELEV. 1176.74

Coal Area
Mining Next 6 Months
Permit Area
Mined Out
No Dwellings
Date August 22, 1968 to February 22, 1969

MINE REPORTED CLOSED
per TELEPHONE 12-11-68 - S.E.C. T.S.

CHERRY RUN FUEL CO.
GARRETT'S RUN MINE
MANOR TWP. - ARMSTRONG CO. - PENNA.
SCALE 1 INCH = 100 FEET - SEPT. 21, 1965
ORIGINAL SURVEY BY R.B. SHANNON, ASSC.
LESTER W. CLARK FIELD ENGR.
INDIANA, PA.
Graft Engineering Co.
Elizaville, Pa.

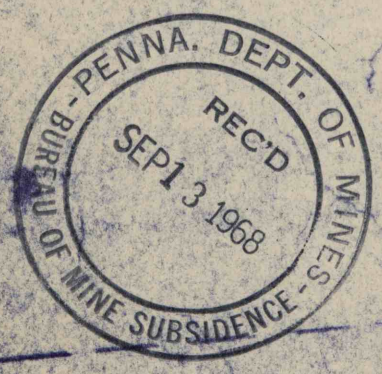

#1080
7-27-69

ANDREW W. PAPCIAK

WEST PENN POWER CO. TRANSMISSION LINE

JAY R. BOWSER

WILBER BOWSER

N 36° 5' E

N 35° 22' 10" E

1168.88

1475.44

N 68° 13' 20" W

S 66° 05' 20" E

25 1/2 BARRIER

2121.51

TOWNSHIP ROUTE 46

E 27 GAS LINE

25 1/2 BARRIER

2 GAS LINE

GAS WELL

OLD DRIFTS

7-30-63

7-26-62

7-26-62

7-30-66

7-30-66

