
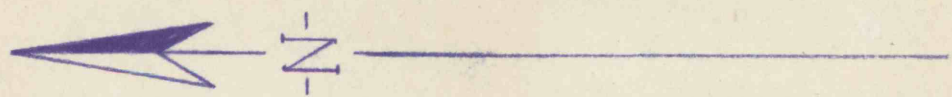


RACHEL BISHOP

CLARK SMITH

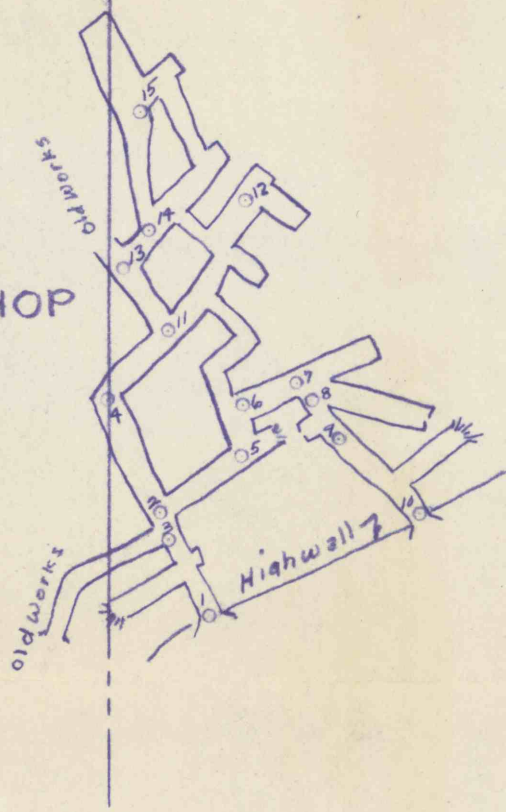

MINE MAP
GLENN GASTON
 COAL MINE

Canoe Township, Indiana County, Pa.
 Scale 1"=100' Nov. 3, 1958
 Walter J. Zimmerman Surveyor Engineer Punxsutawney, Pa.

12th District
 1957

#1083
 7-22-99
 C.C.