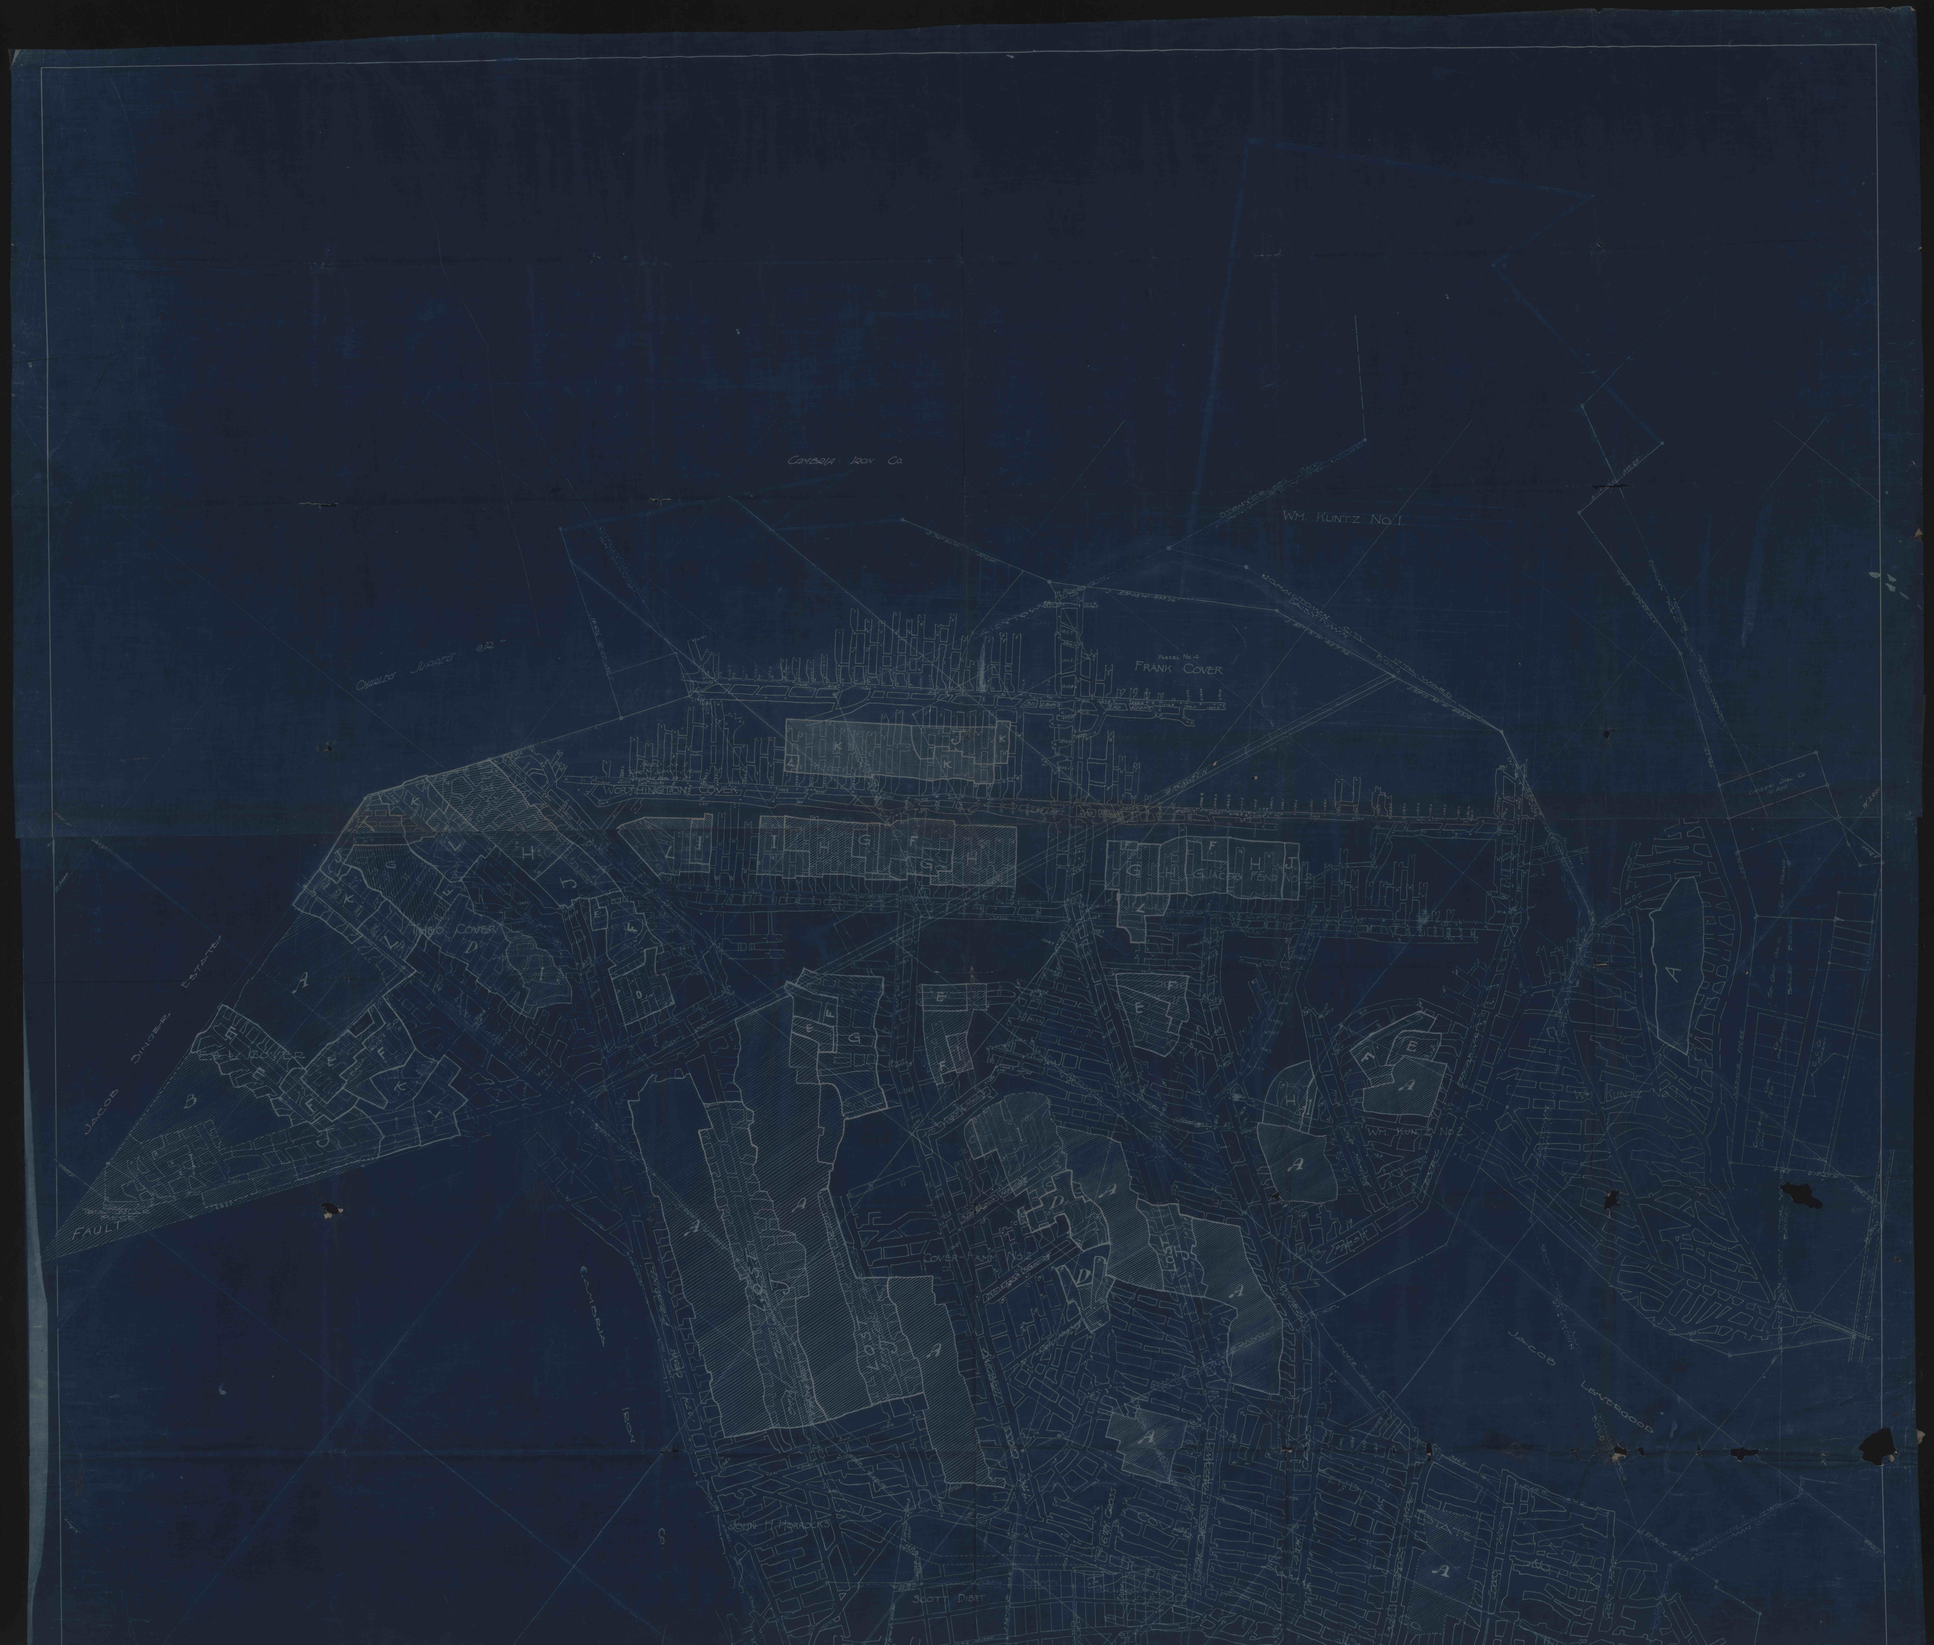

Cambria Iron Co.
Wm. Kuntz No. 1
Frank Cover
Worthington Cover
Jacob Dinger Estate
Fault
Cambria Iron
Jacob Lewergood
Scott Dist.