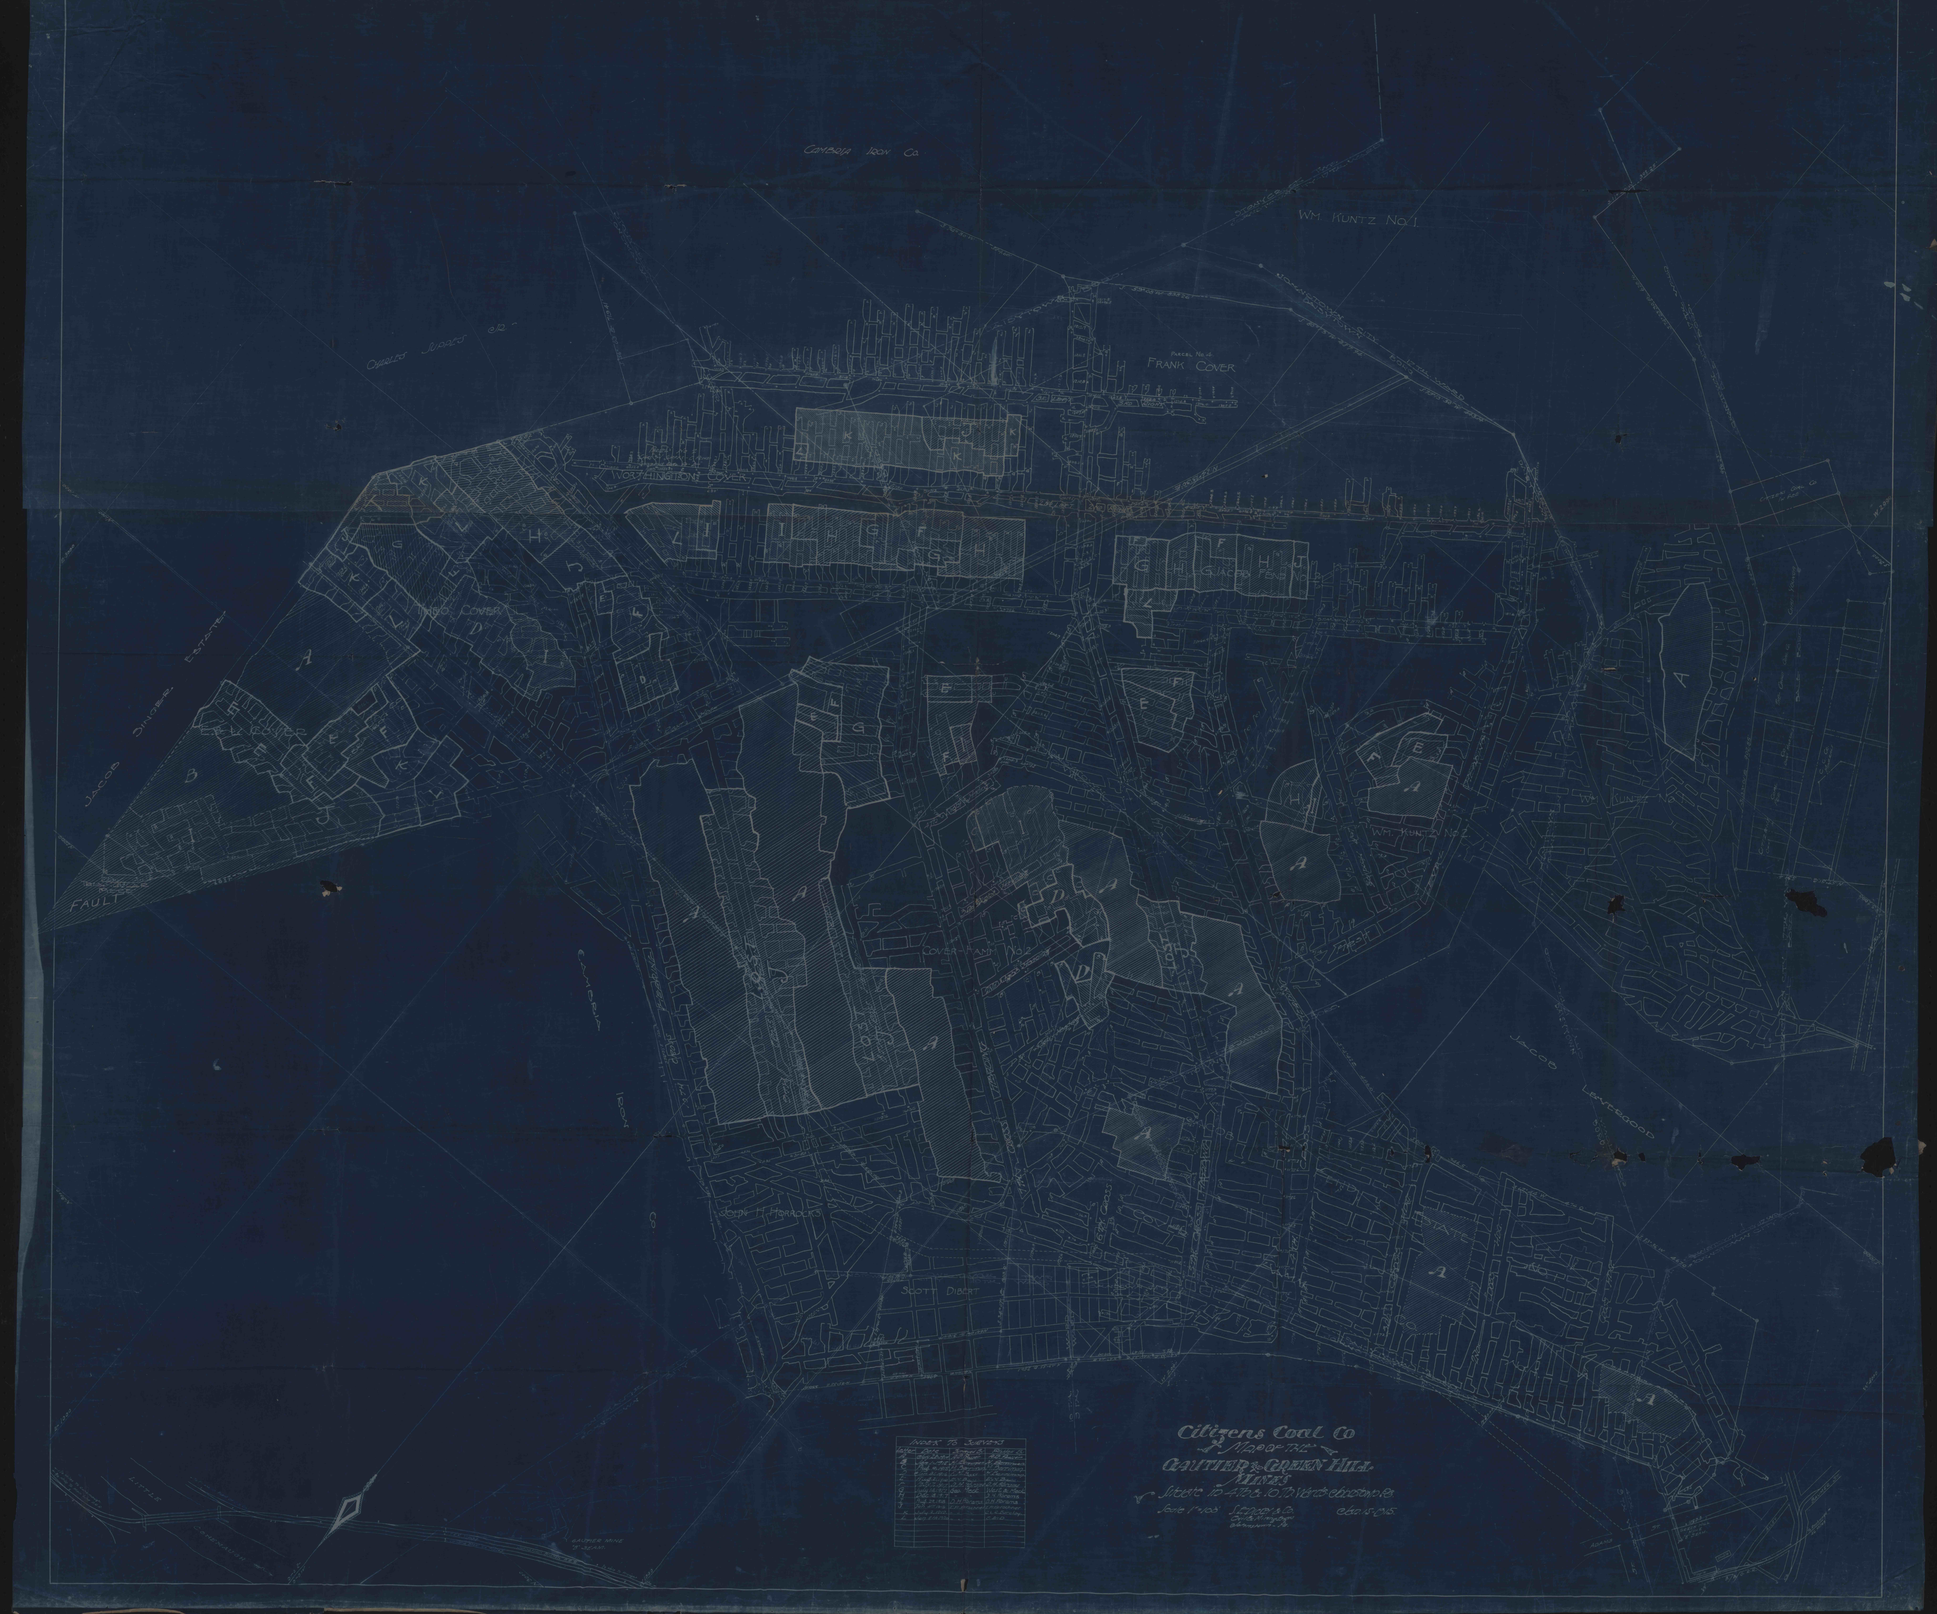
Cambria Iron Co.
Wm. Kuntz No. 1
Frank Cover
Jacob Dinger Estate
Fault
Cambria Iron
Jacob Lewergood
Scott Dibert
Index to Surveys
Citizens Coal Co
Map of the
Gautier & Green Hill
Mines
Scale 1" = 100'
Sanger & Co.
Civil Engineers
