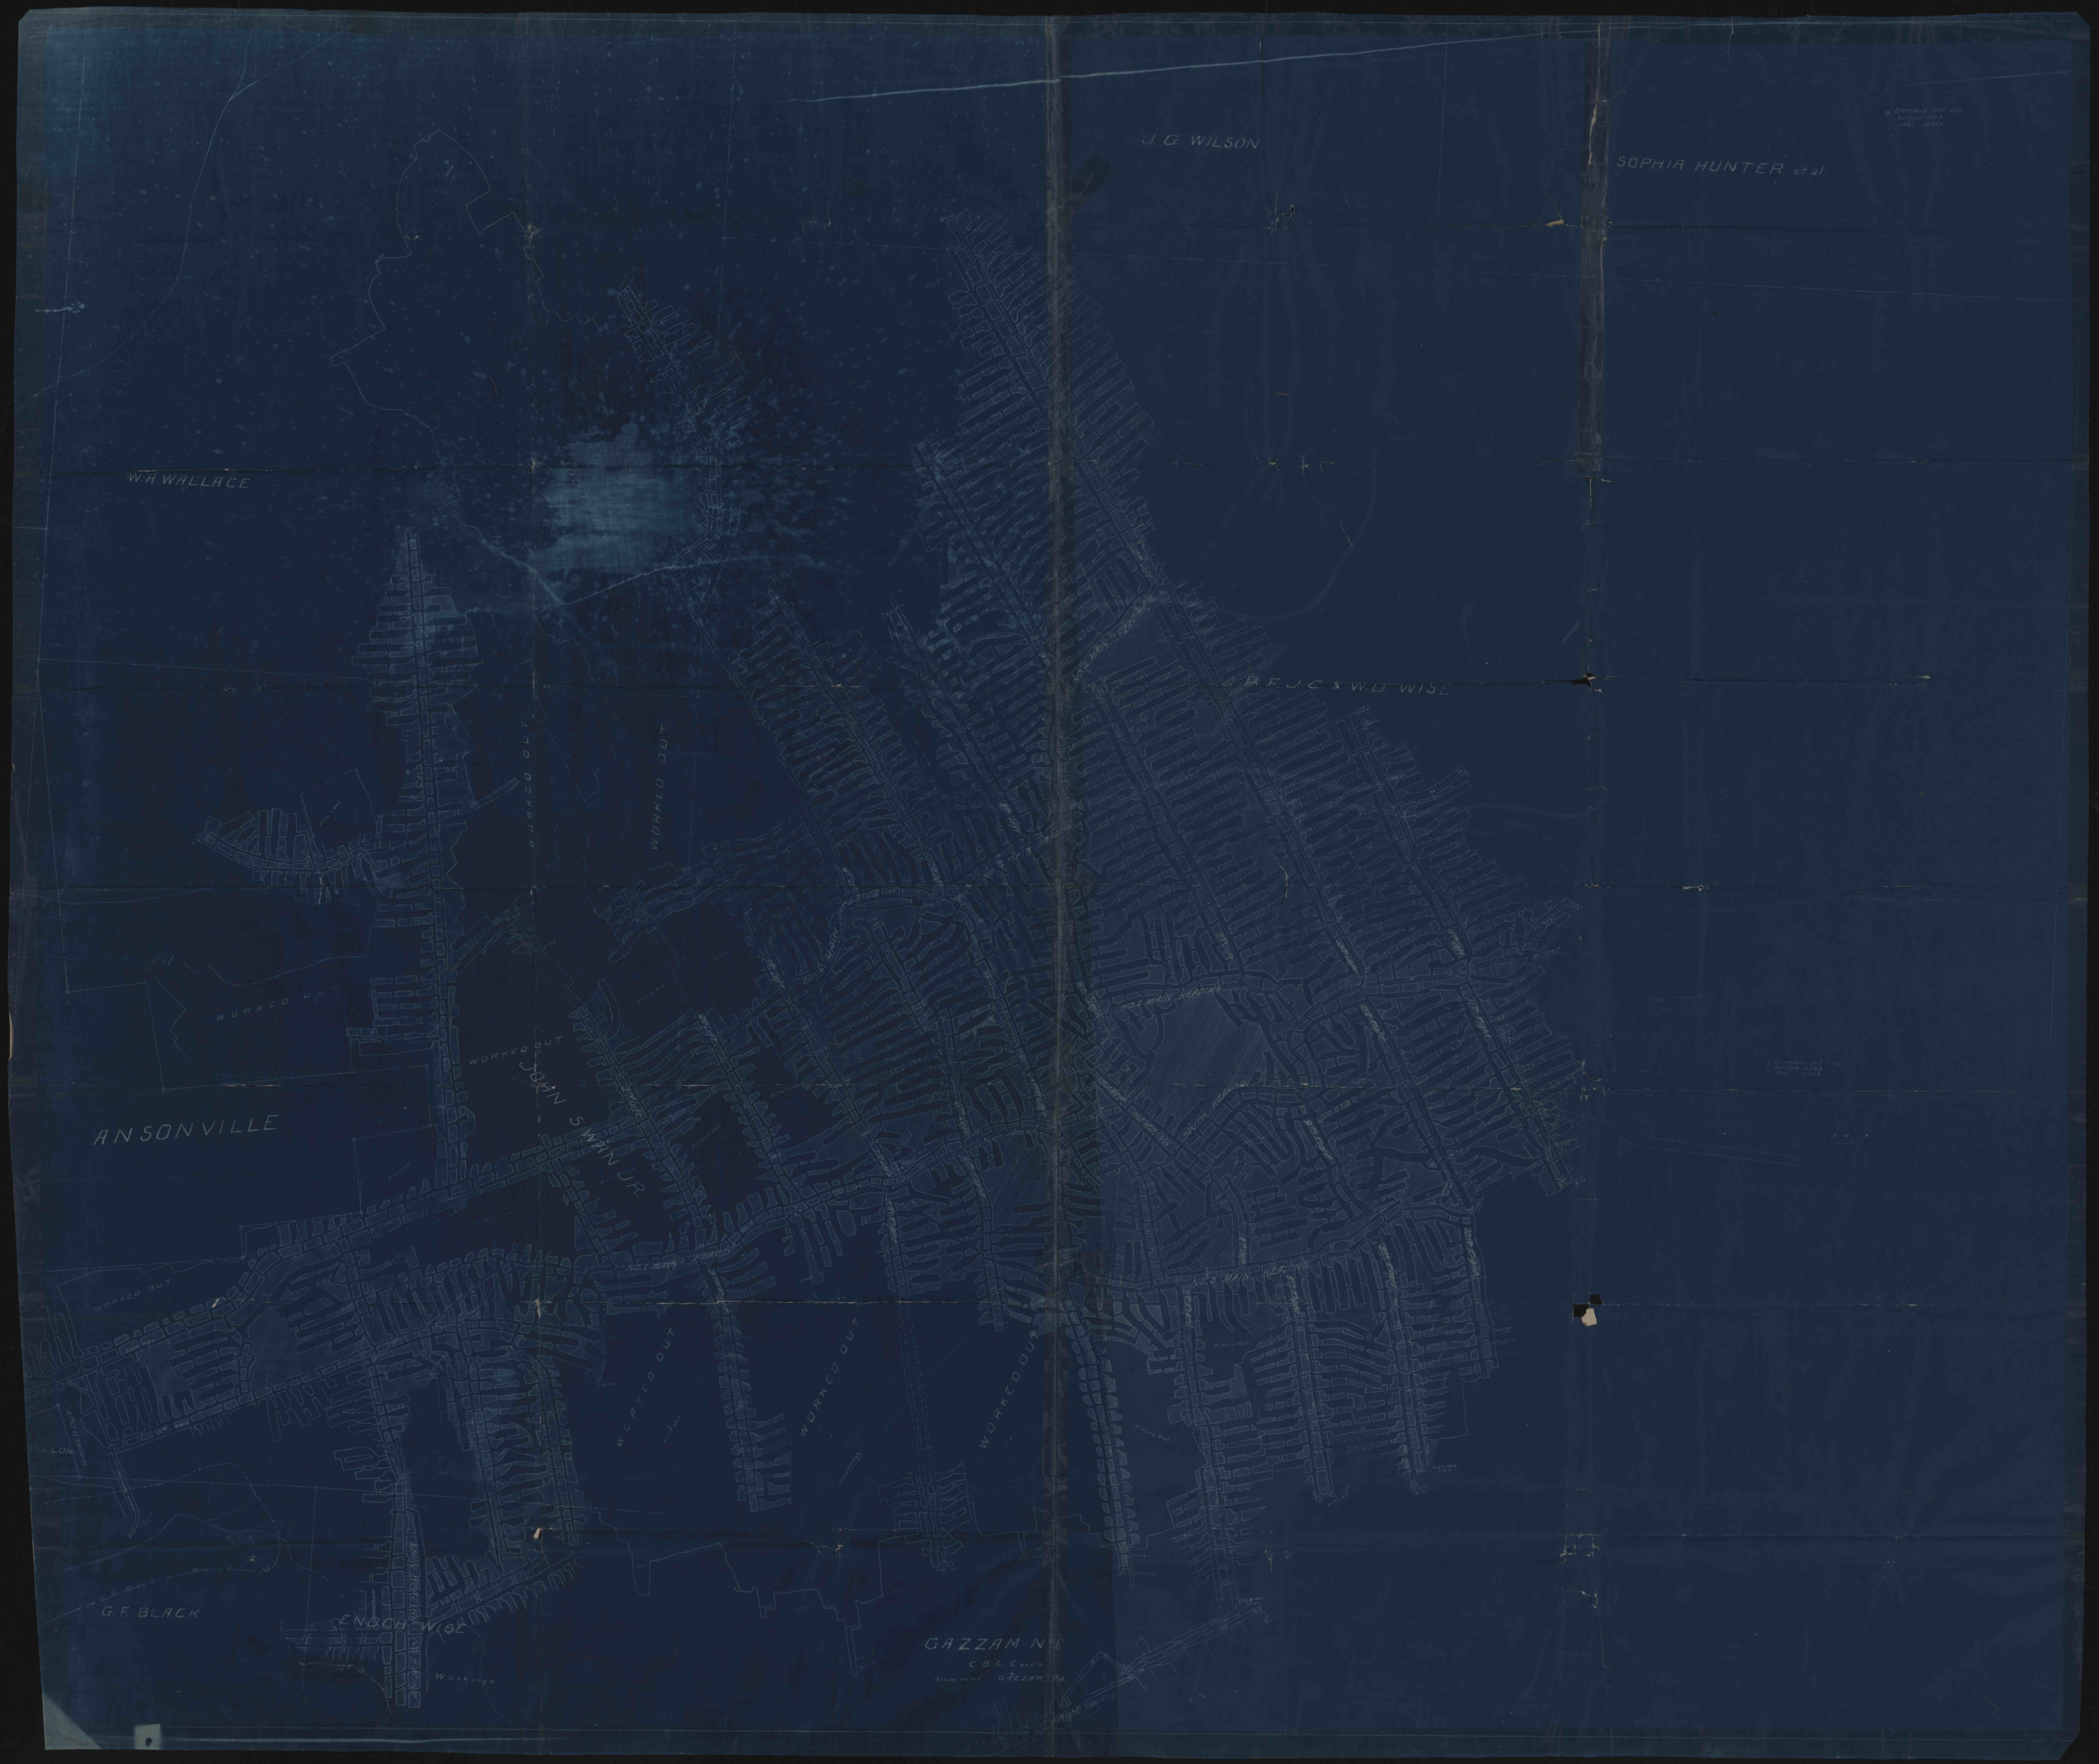
J. G. WILSON
SOPHIA HUNTER et al.
W. A. WALLACE
R. F. J. C. & W. D. WISE
WORKED OUT
WORKED OUT
WORKED OUT
WORKED OUT
JOHN SWAN JR.
ANSONVILLE
WORKED OUT
WORKED OUT
WORKED OUT
WORKED OUT
G. F. BLACK
ENOCH WISE
GAZZAM No 1
C. B. C. Corp'n.
GAZZAM, PA.