MAP OF
GILLHALL MINE

OPERATED BY

D & D COAL CO.

BRUCTON, ALLEGHENY COUNTY, PA.

SCALE 1"=100' JAN. 3, 1935

DAVID H. ABRAMS
Reg. Professional Engineer
Connellsburg, Pa.

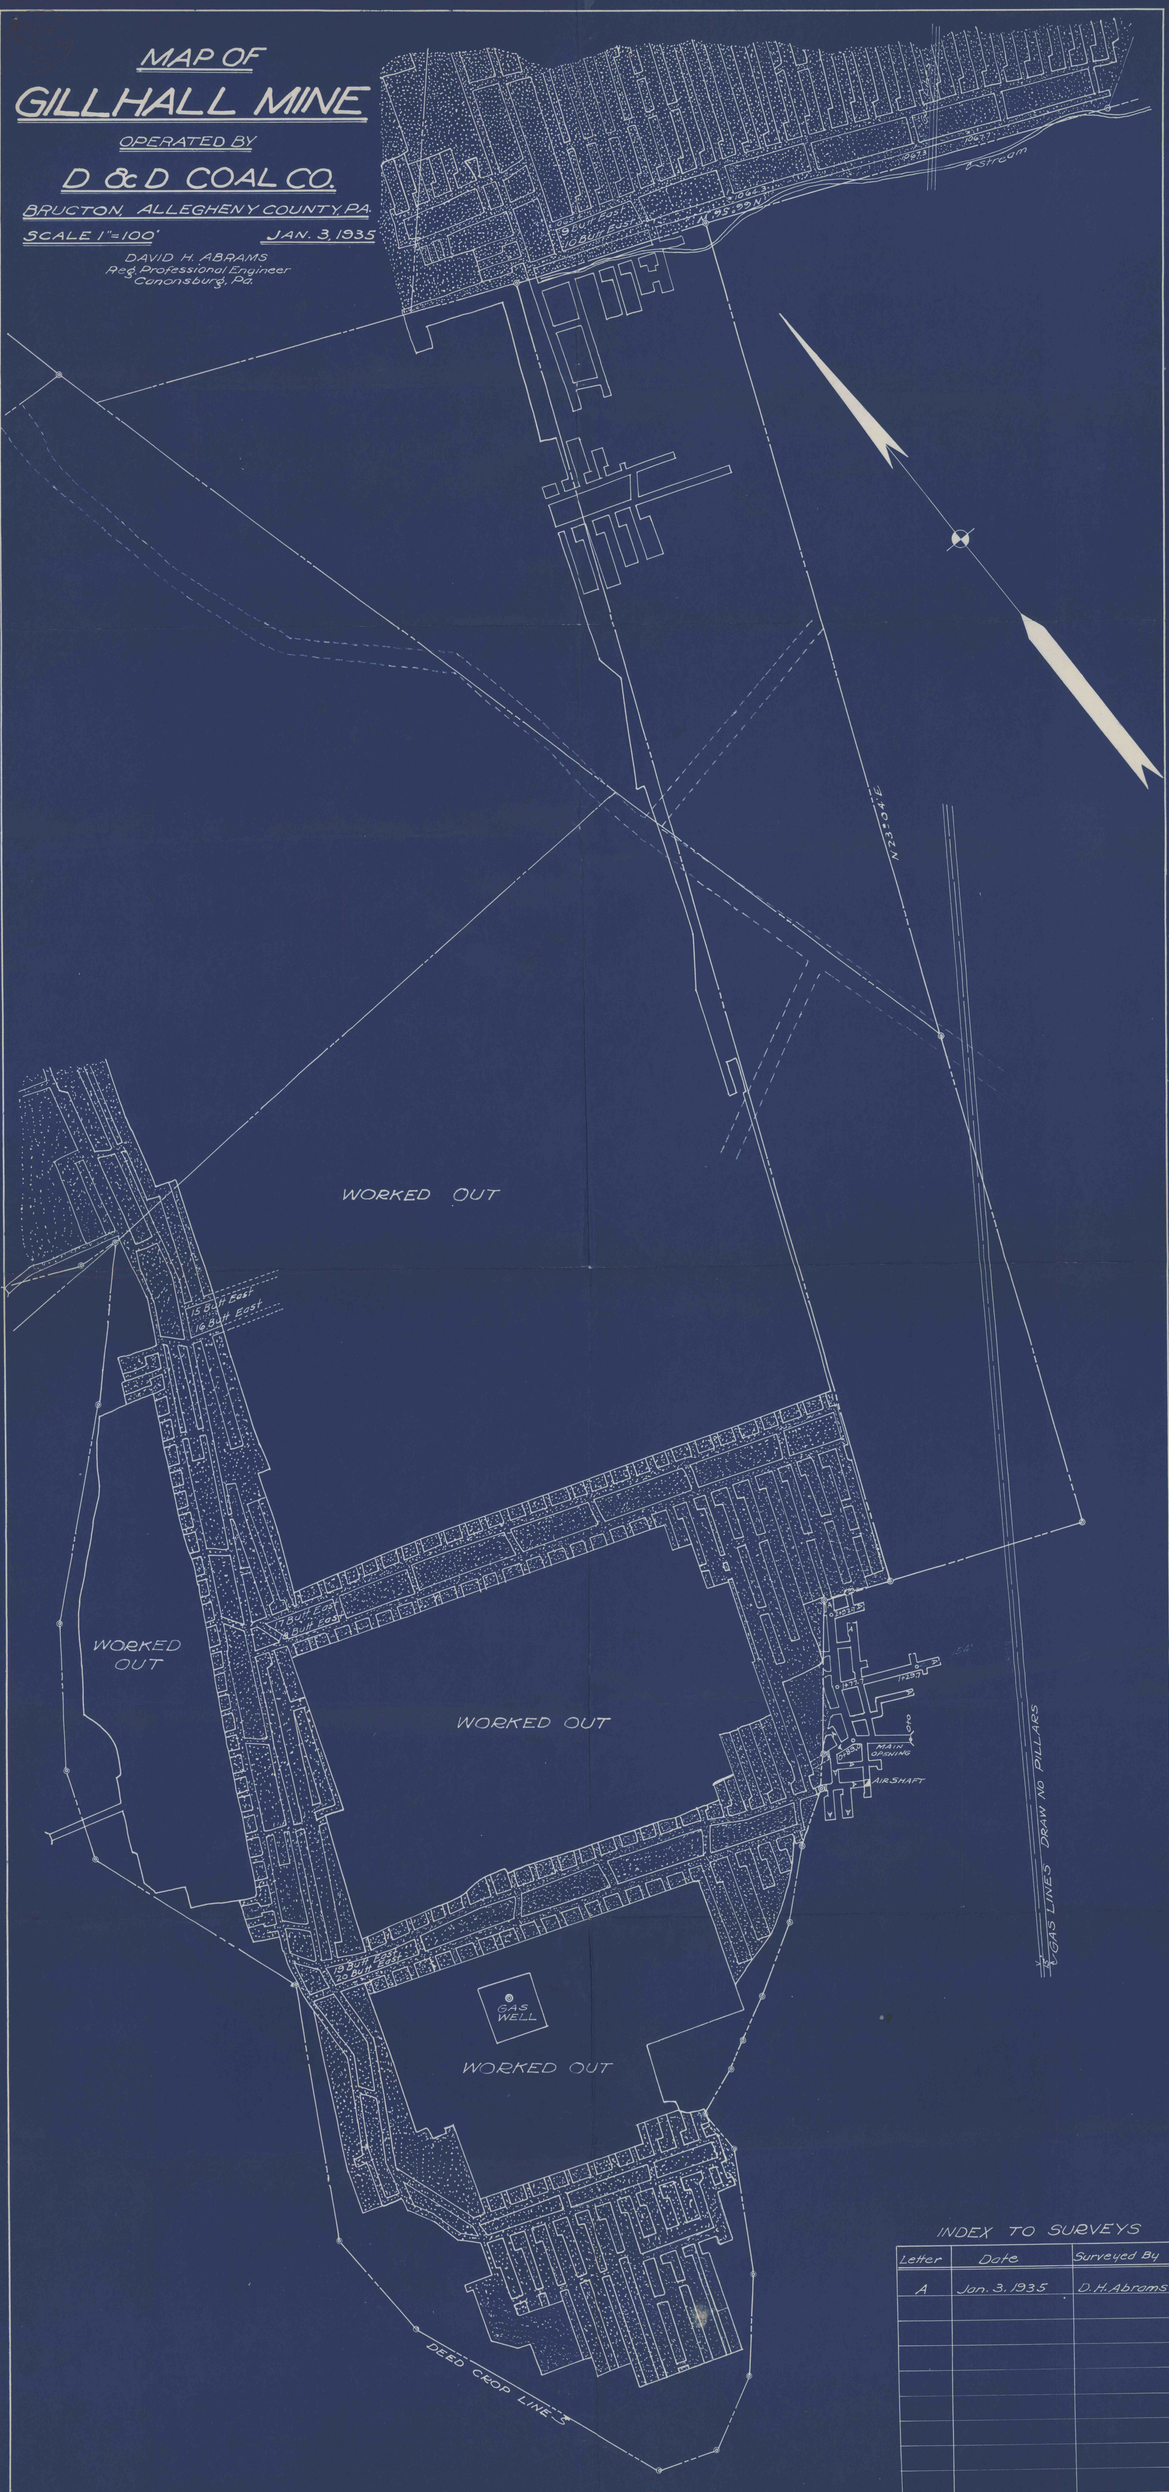

INDEX TO SURVEYS

Letter	Date	Surveyed By
A	Jan. 3, 1935	D. H. Abrams