


296 SHOAF NO. 2

298

297

305

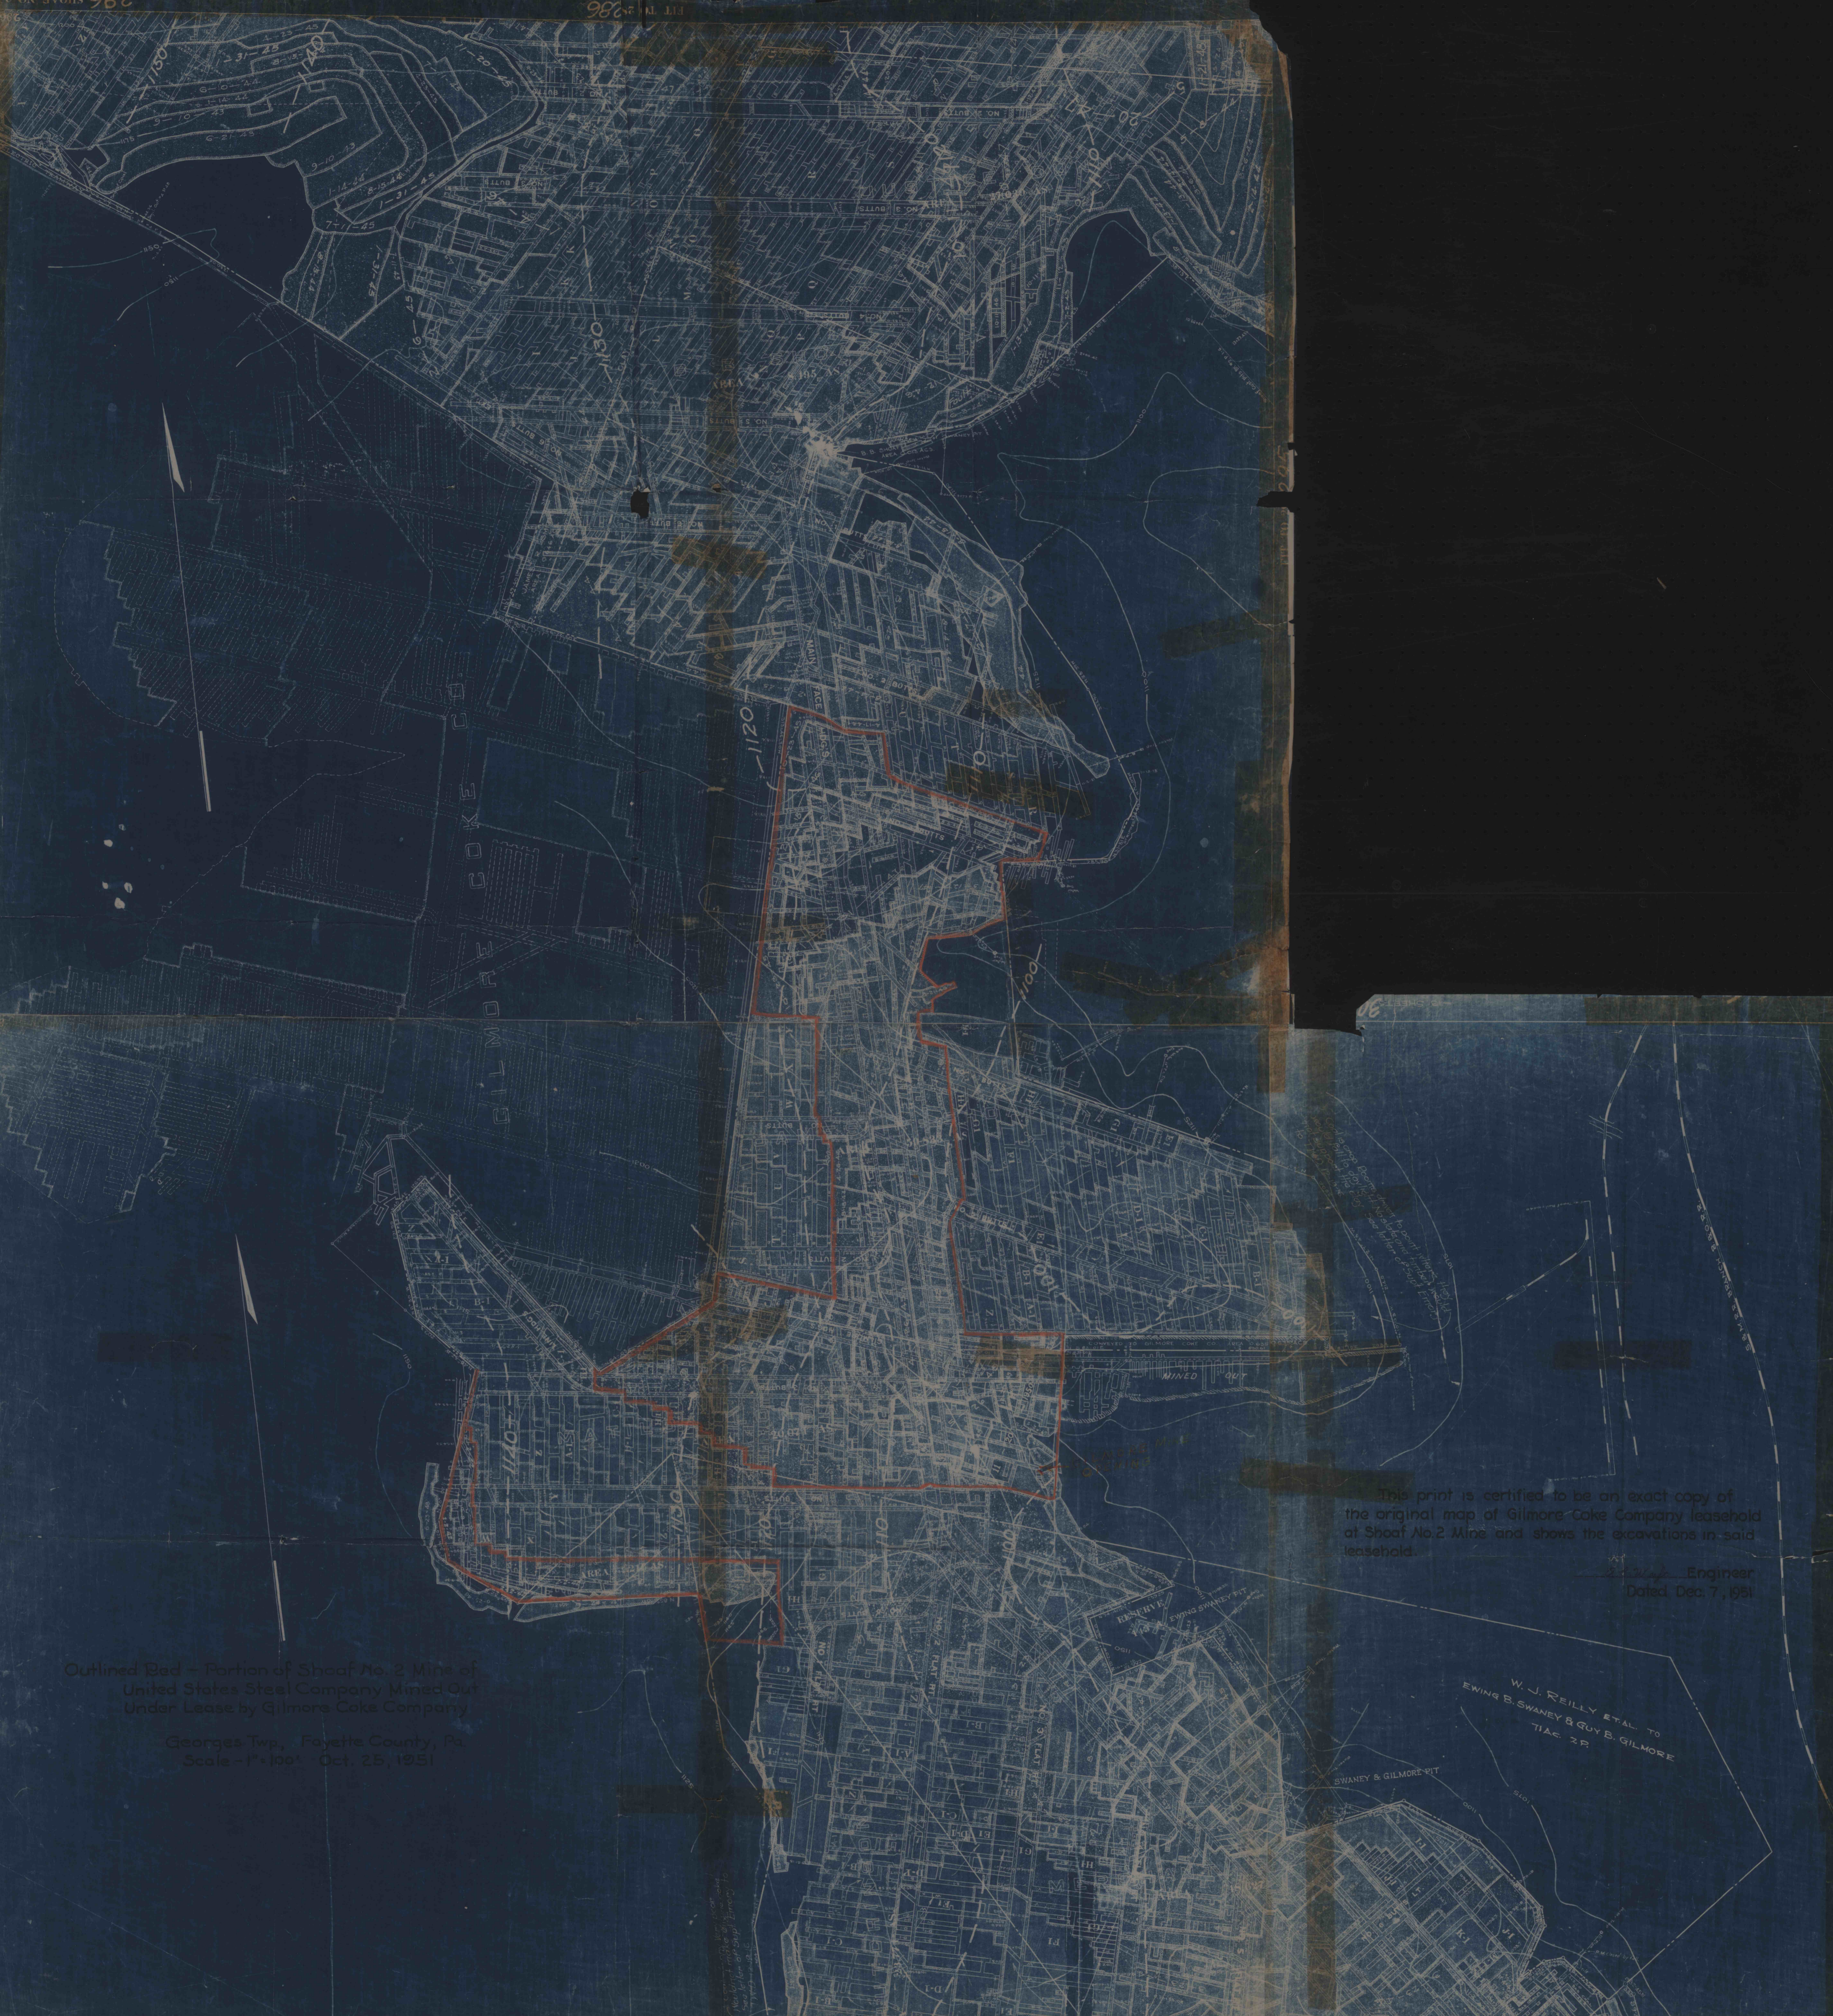

Outlined Bed - Portion of Shoaf No. 2 Mine of
 United States Steel Company Mined Out
 Under Lease by Gilmore Coke Company
 Georges Twp., Fayette County, Pa.
 Scale - 1" = 100' Oct. 25, 1951

This print is certified to be an exact copy of
 the original map of Gilmore Coke Company leasehold
 at Shoaf No. 2 Mine and shows the excavations in said
 leasehold.

Engineer
 Dated Dec 7, 1951

W. J. REILLY ET AL. TO
 EWING B. SWANEY & GUY B. GILMORE
 T1A6 2P

310

304 SHOAF NO. 2