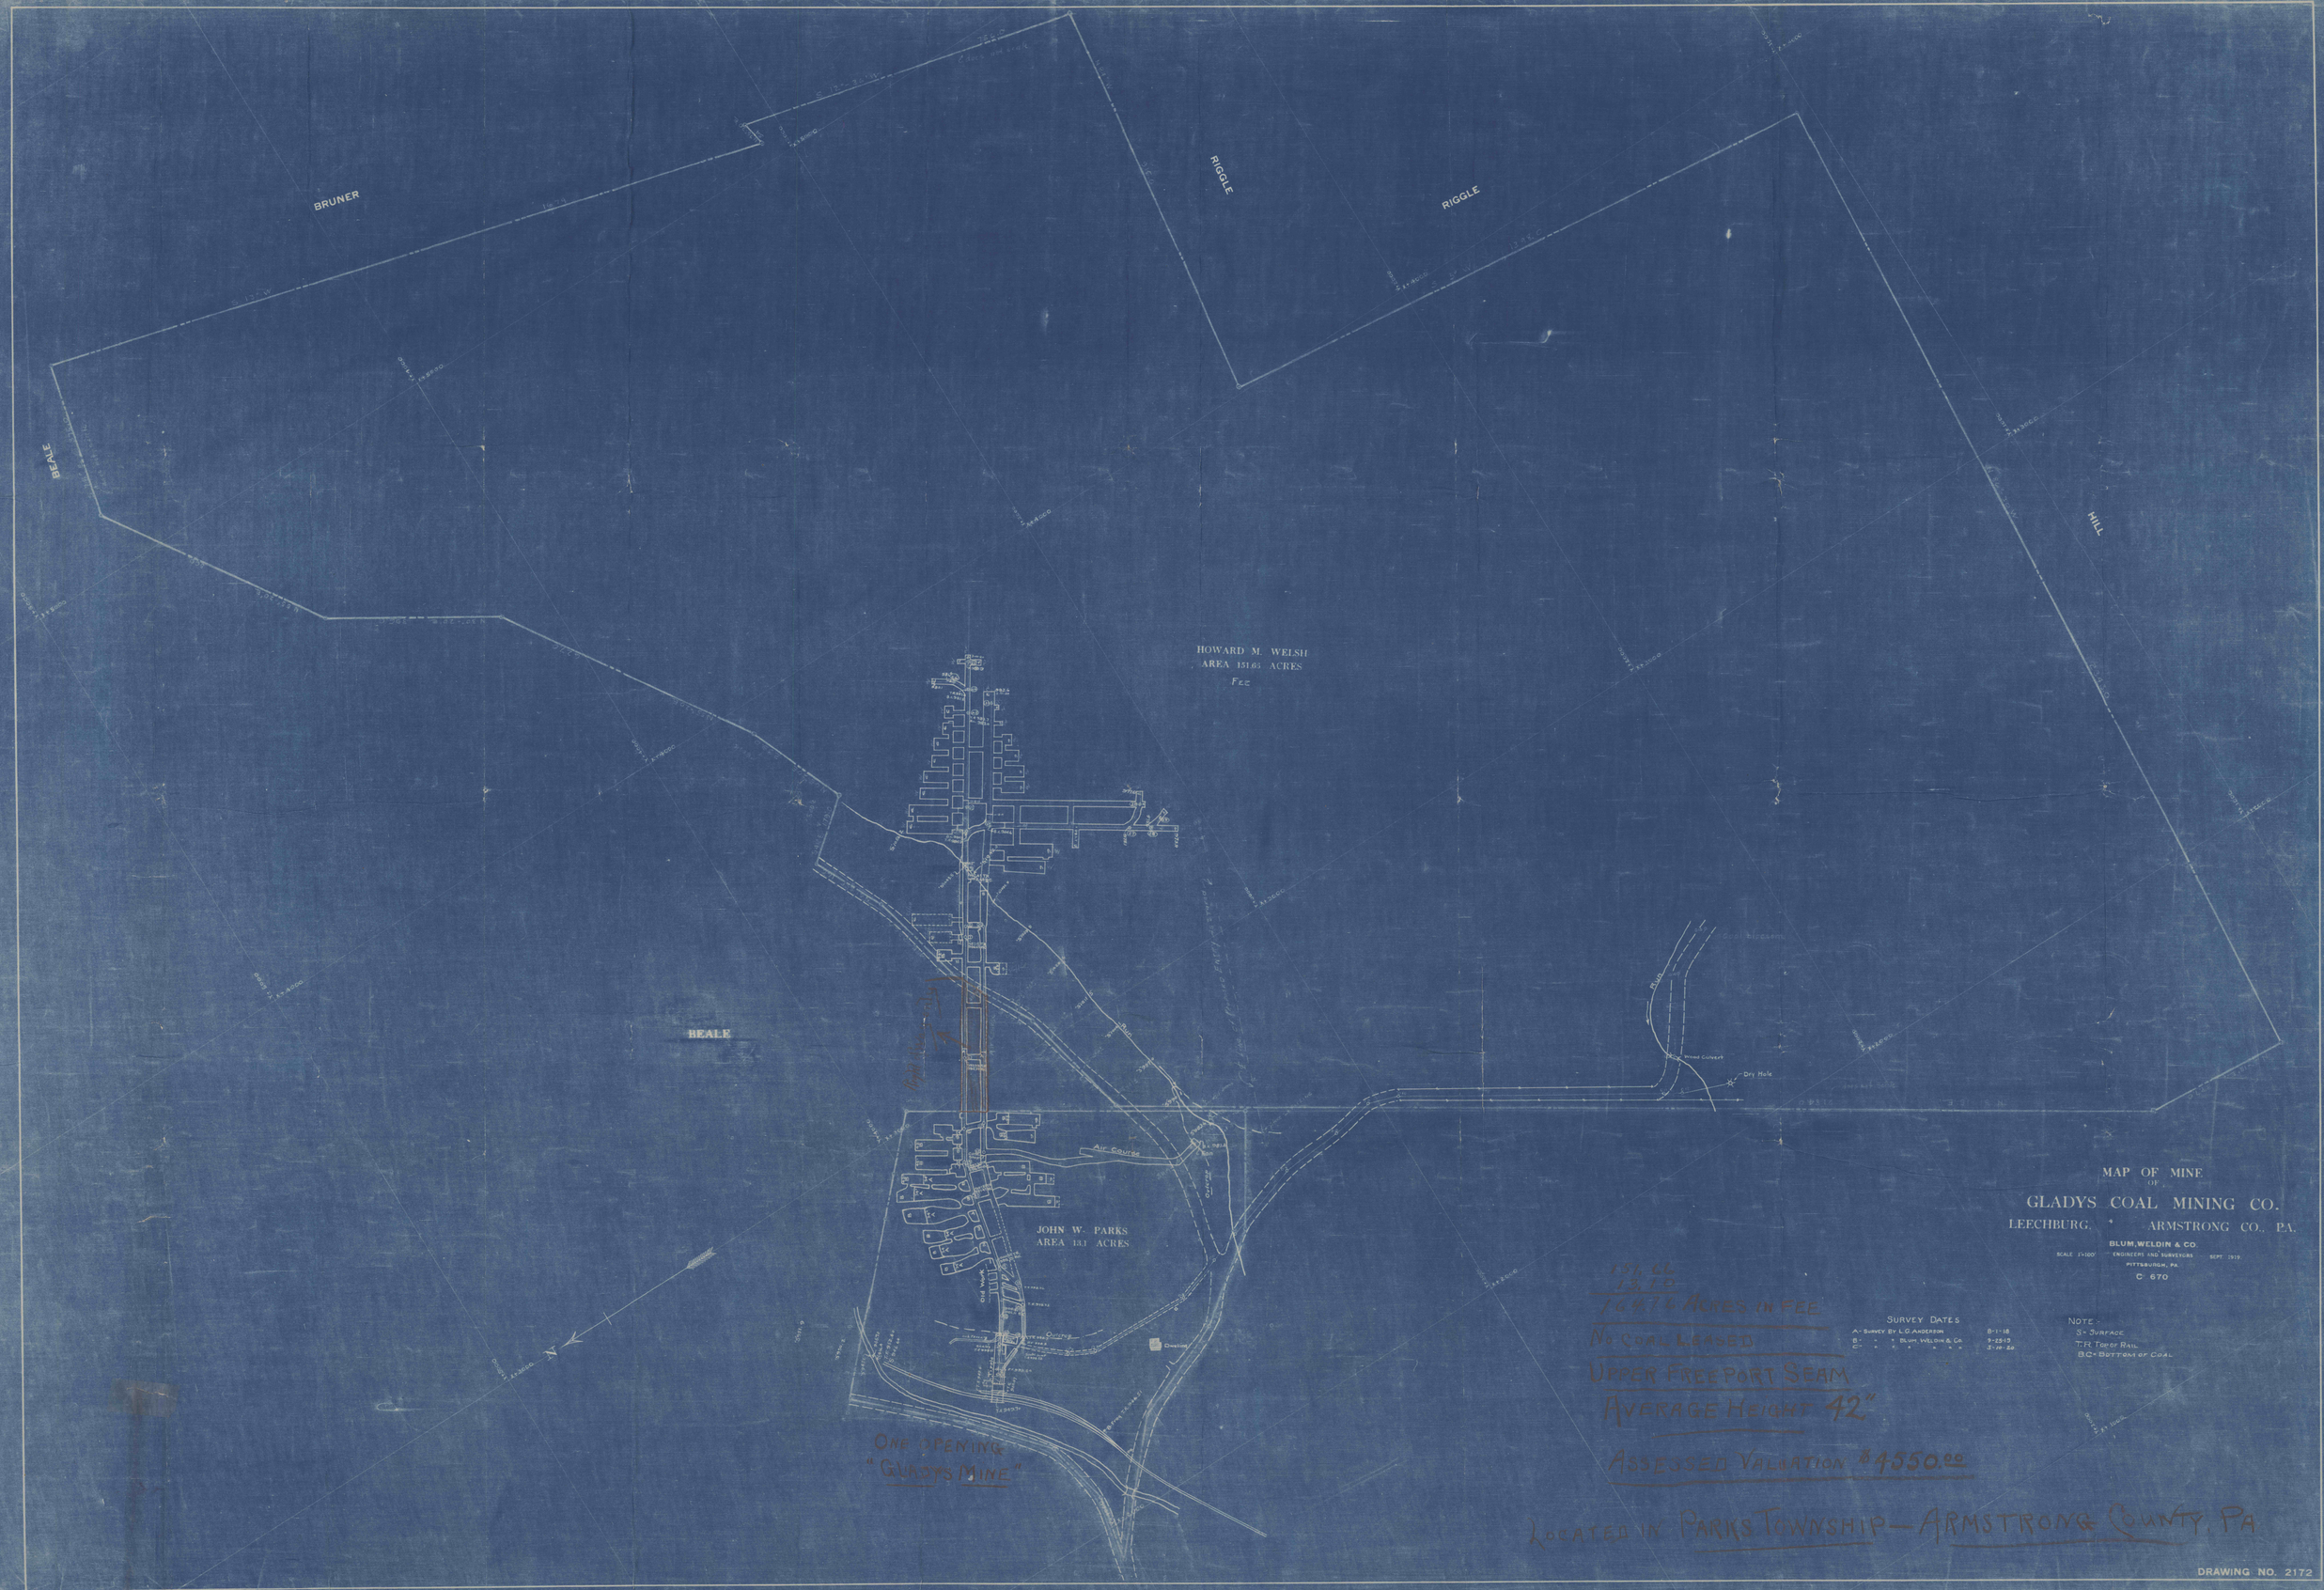
BRUNER
RIGGLE
RIGGLE
BEALE
HILL
HOWARD M. WELSH
AREA 151.65 ACRES
Fee
BEALE
JOHN W. PARKS
AREA 13.1 ACRES
Air Course
Dry Hole
Wood Culvert
Run
Old Work
Outcrop
Dwelling
N
MAP OF MINE
OF
GLADYS COAL MINING CO.
LEECHBURG, ARMSTRONG CO., PA.
BLUM, WELDIN & CO.
SCALE 1"=100'
ENGINEERS AND SURVEYORS
SEPT. 1919.
PITTSBURGH, PA.
C 670
SURVEY DATES
A- SURVEY BY L.G. ANDERSON 8-1-18
B- " " BLUM, WELDIN & CO. 9-25-19
C- " " " " " " 3-20-20
NOTE:-
S= SURFACE
T.R. TOP OF RAIL
B.C.= BOTTOM OF COAL
137.66
13.70
164.76 ACRES IN FEE
NO COAL LEASED
UPPER FREEPORT SEAM
AVERAGE HEIGHT 42"
ASSESSED VALUATION $4550.00
LOCATED IN PARKS TOWNSHIP — ARMSTRONG COUNTY, PA
ONE OPENING
"GLADYS MINE"
DRAWING NO. 2172