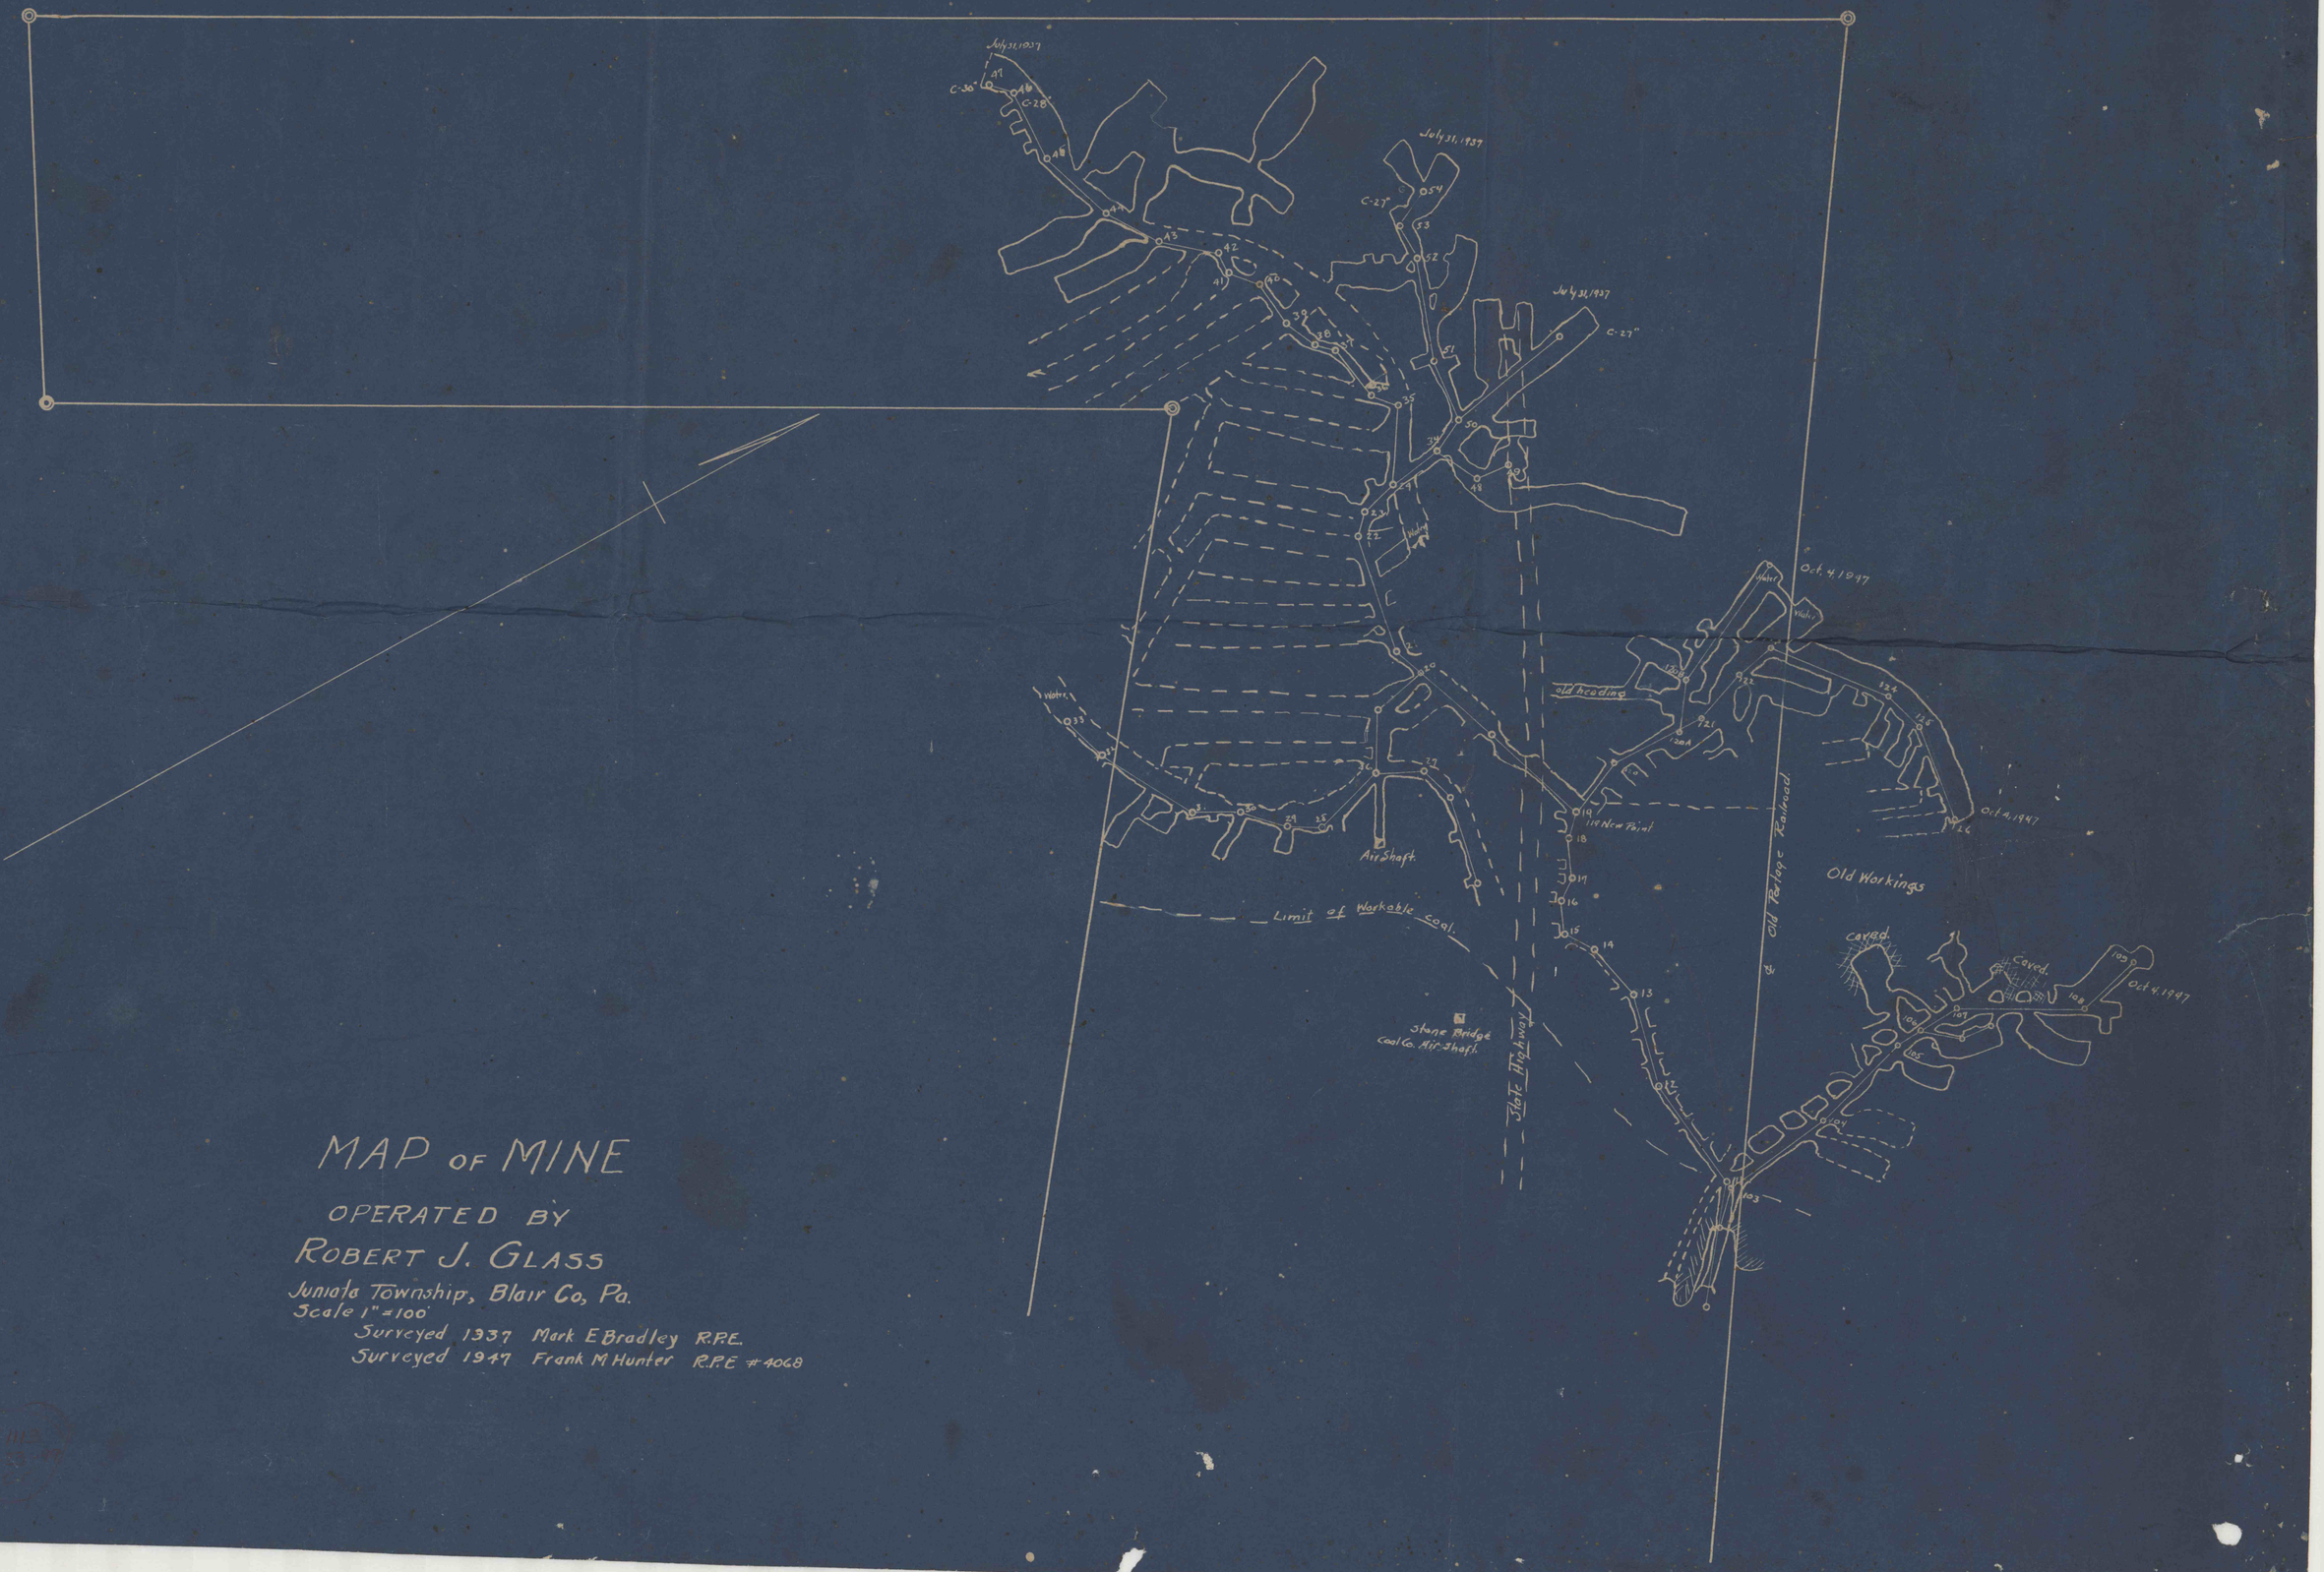

MAP OF MINE

OPERATED BY

ROBERT J. GLASS

Juniata Township, Blair Co, Pa.

Scale 1" = 100'

Surveyed 1937 Mark E Bradley R.P.E.

Surveyed 1947 Frank M Hunter R.P.E. #4068