JOSHUA SMITH
137 A[illegible]

JOHN WHITMER
367 A[illegible]

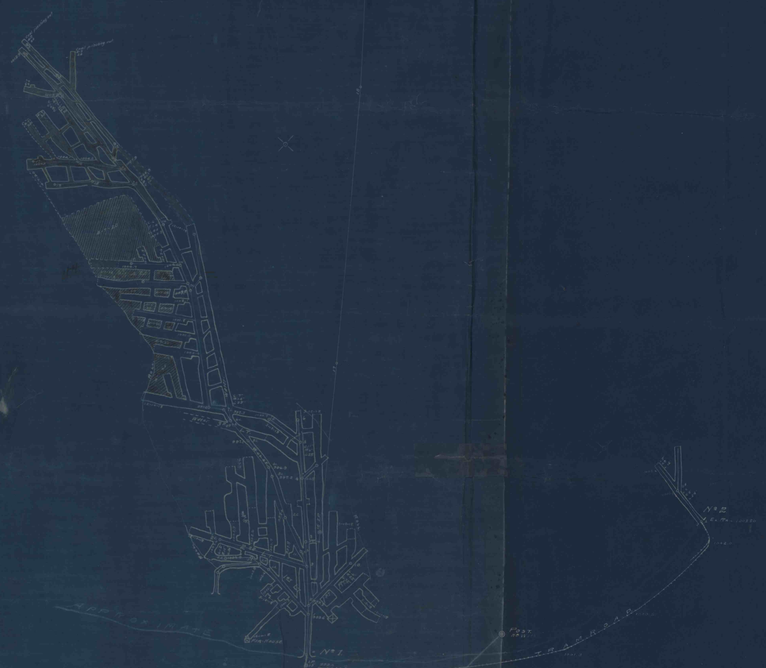

GLENBROOK COLLIERIES CO.

MAP OF MINES

NEAR IRVONA, CLEARFIELD CO., PA.

SCALE 1"100'

CLEARFIELD PA
DEC-28-1918

OFFICE OF E.W.HESS
ENGINEER

SURVEYED MAR-13, 1918.
RE-SURVEYED DEC. 11-12, 1918.
SURVEYED APR 4-17-1920