


PENNSYLVANIA COAL & COKE CORP.

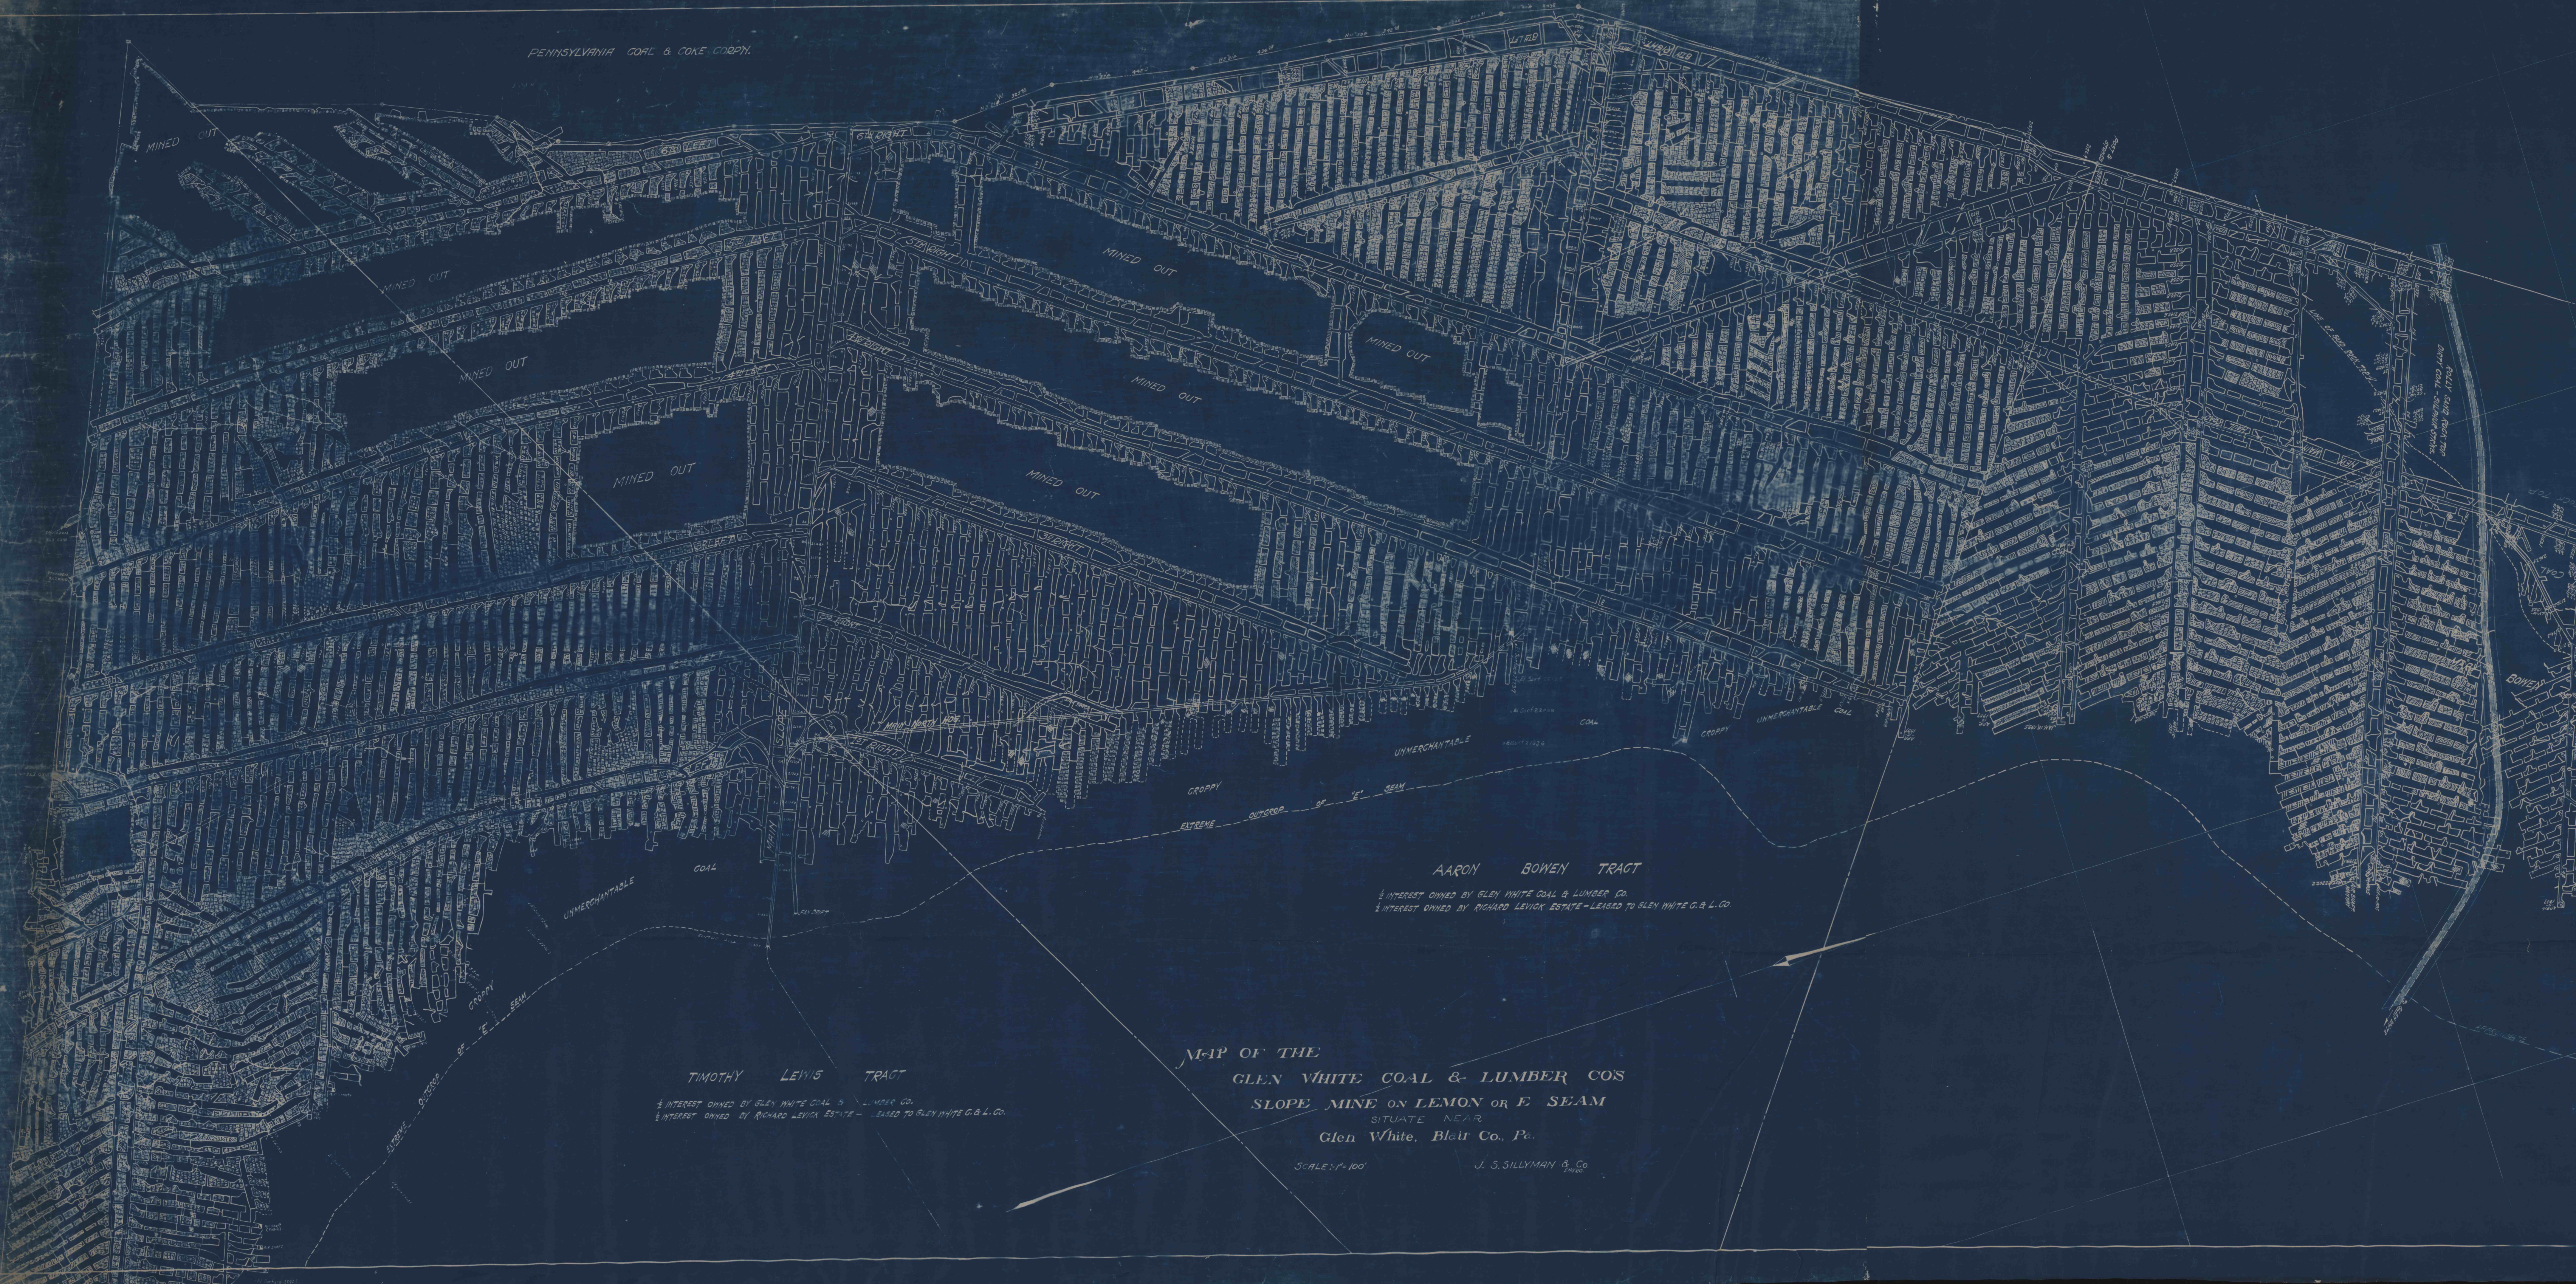

TIMOTHY LEWIS TRACT  
 1/2 INTEREST OWNED BY GLEN WHITE COAL & LUMBER CO.  
 1/2 INTEREST OWNED BY RICHARD LEWIS ESTATE - LEASED TO GLEN WHITE C. & L. CO.

AARON BOWEN TRACT  
 1/2 INTEREST OWNED BY GLEN WHITE COAL & LUMBER CO.  
 1/2 INTEREST OWNED BY RICHARD LEWIS ESTATE - LEASED TO GLEN WHITE C. & L. CO.

MAP OF THE  
 GLEN WHITE COAL & LUMBER COS  
 SLOPE MINE ON LEMON OR F SEAM  
 SITUATE NEAR  
 Glen White, Blair Co., Pa.

SCALE: 1" = 100' J. S. SILLYMAN & Co. ENG'RS