



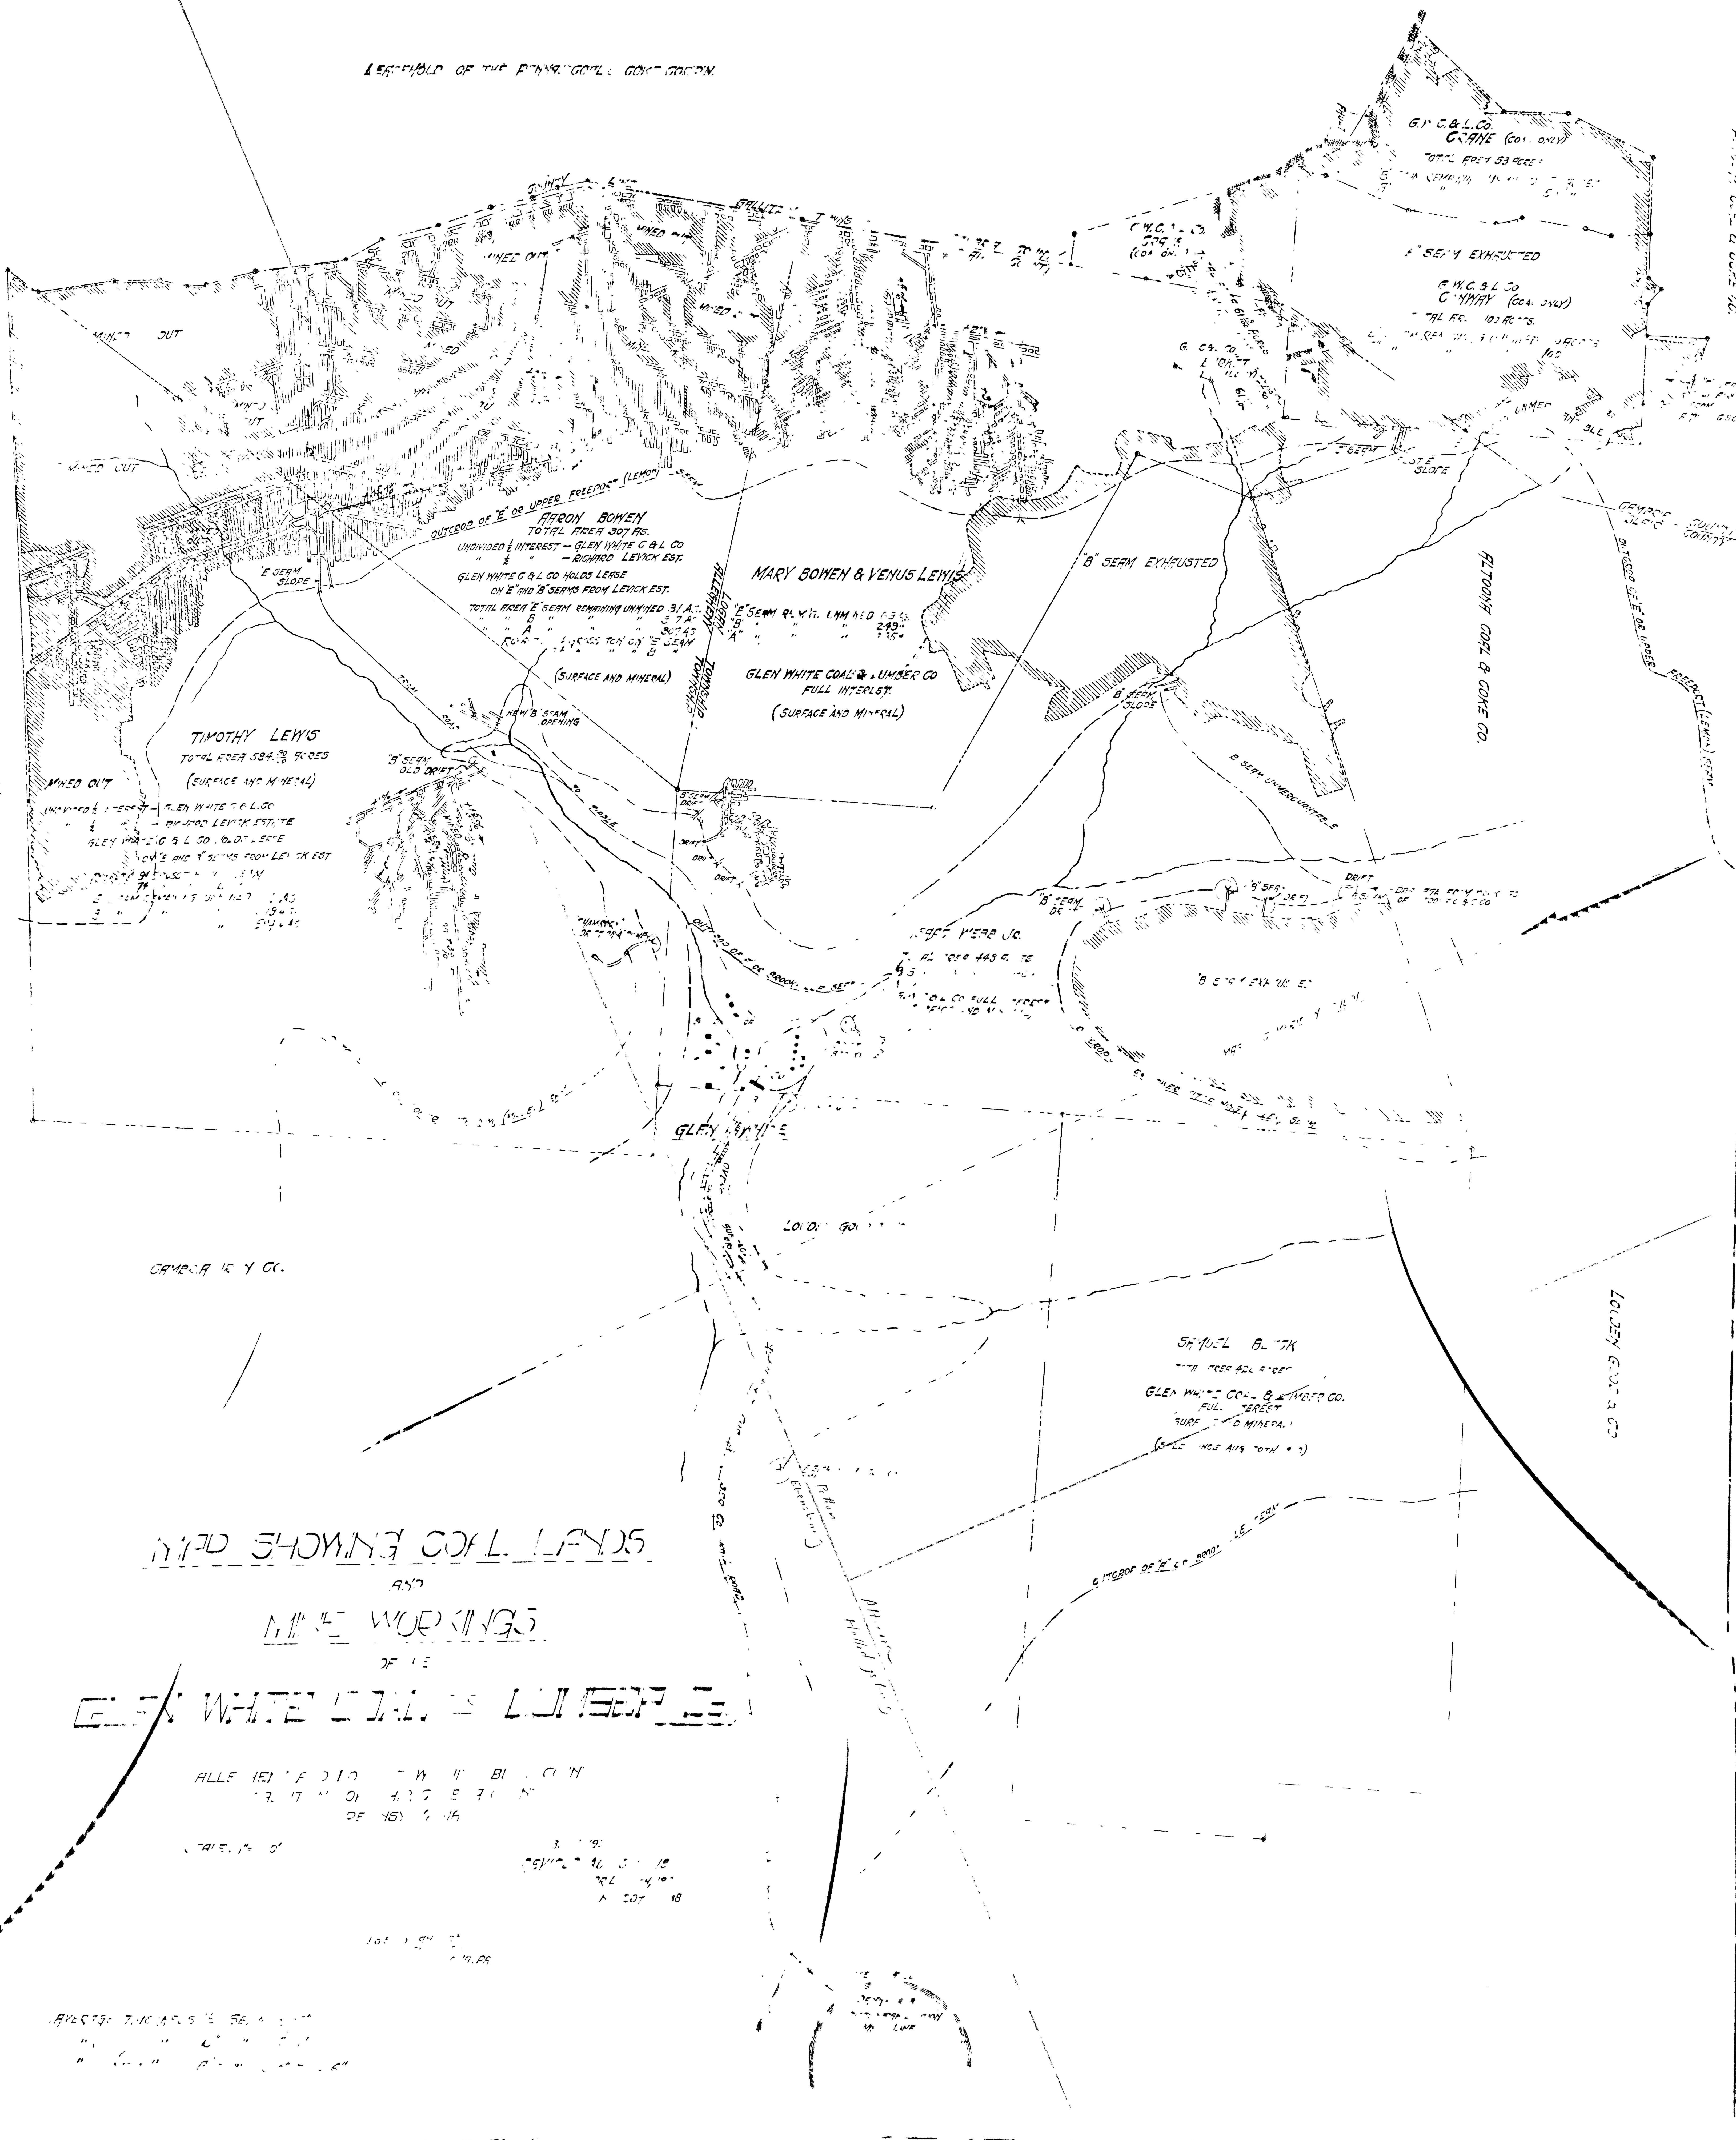



ALLF 15) F D I O W H B L C N
7 7 M O A P E T N
DE 15) S HA


3. '91
 15112 16 5 10
 22 4 10
 1 207 18

100 1 24 7

" " " " "