


9079
9079

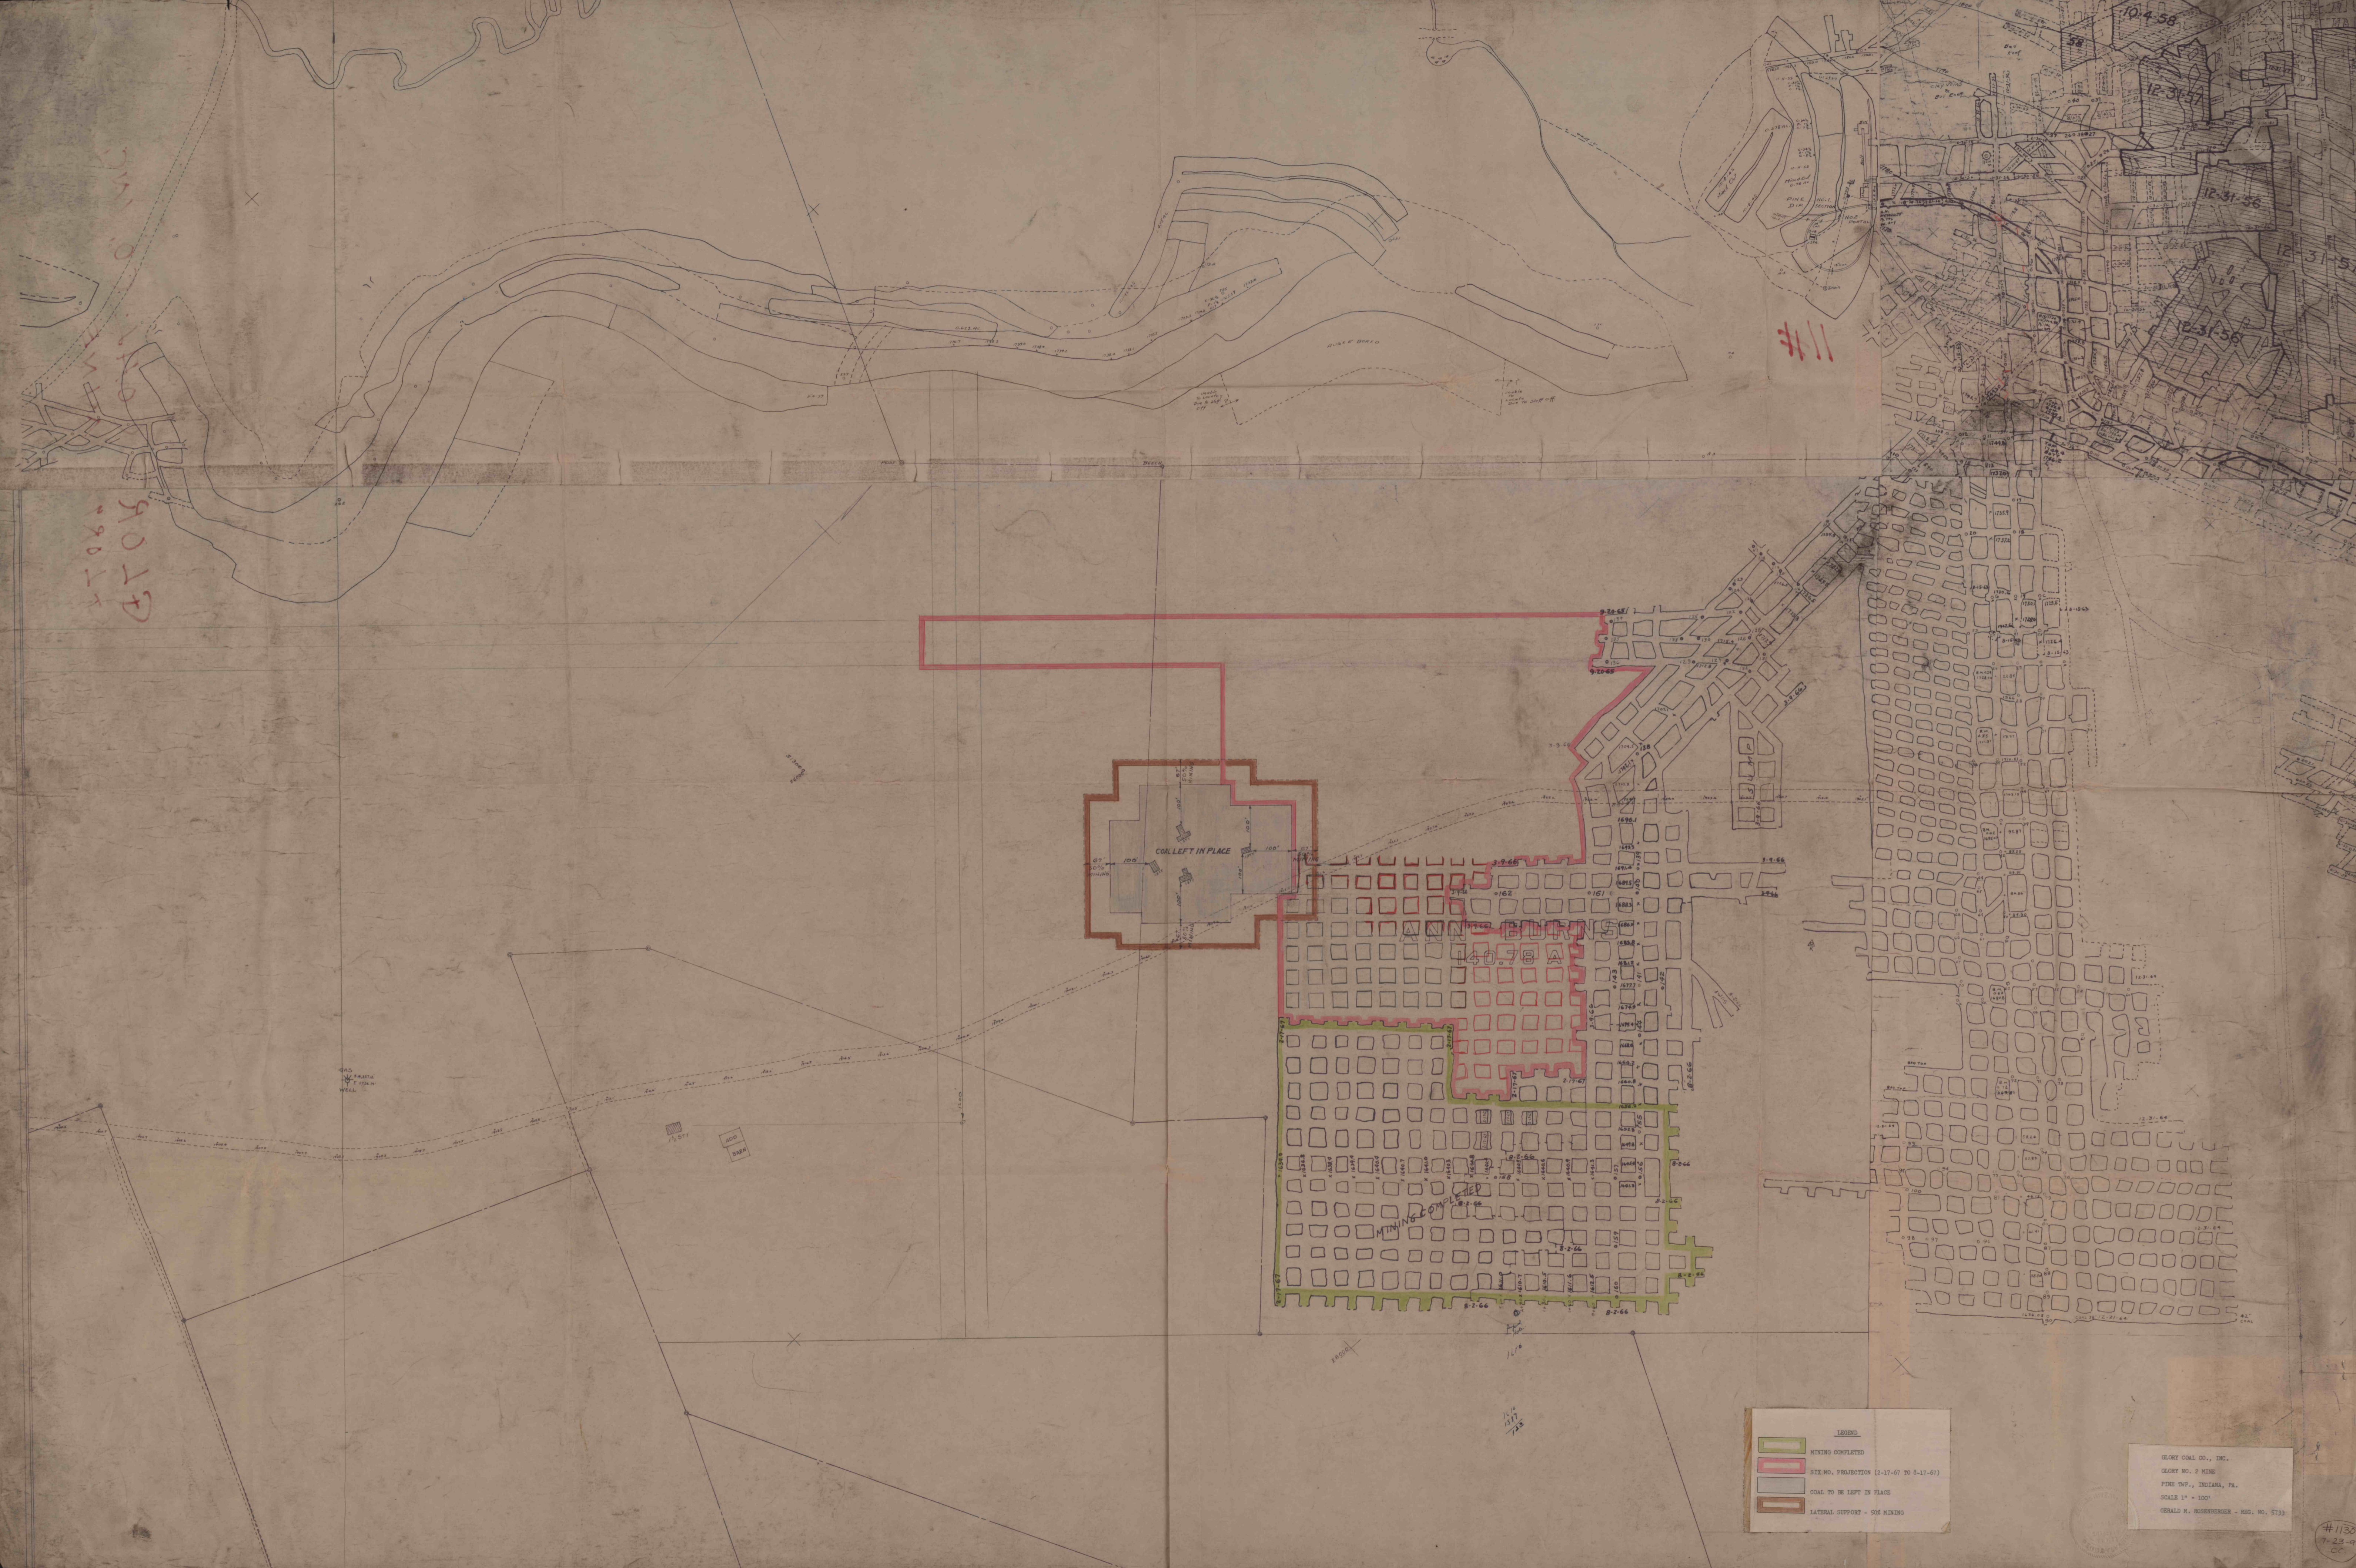

LEGEND

	MINING COMPLETED
	SECTION PRODUCTION (2-17-51 TO 8-17-51)
	COAL TO BE LEFT IN PLACE
	LATERAL SUPPORT - 505 MINING

GLORY COAL CO., INC.
GLORY NO. 2 MINE
FINE TWP., BRITAIN, PA.
SCALE 1" = 100'
GERALD H. ROSENBERGER - SURV. NO. 5133

#1130
7-23-49
CC