

Green Glen Corp.
Warr. 3578

James C. Munn

731
Cle 245

4767
Cle 251 P

N722 A
Cle 238
Mining 12000

740
Cle 262

N725
Cle 237 P
Mining 10000

4738
Cle 234
Mining 10000

4726
Cle 276
Mining 7500

4767
Cle 249
Mining 4000

Pa. Dept. of Forest & Waters
Warr. 20000

Green Glen Corp.

Penfield

Coal


and

Coke

Mining Previously Completed
Aug. 27, 1967

READY

JEWEL

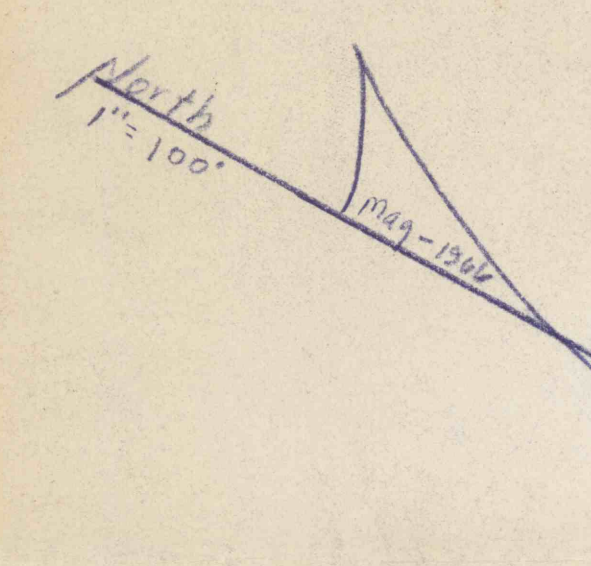

PERMIT 73-1
Glen Irvan Corp.
Moose Run Mine
GOBLERS KNOB #1
JAMES STOKER - ENGINEER
HUSTON TWP., CLEARFIELD CO., PA.

LEGEND
Contemplated Mining Area
Mining Completed Area

Scale: 1/4" = 100 FT
August 19, 1968
Clearfield, PA.

SCALE - 1/4" = 100 FT
August 19, 1968
Clearfield, PA.
SHEET 1 of 2

Area held checked to creek for Old gas wells. May 8, 1968