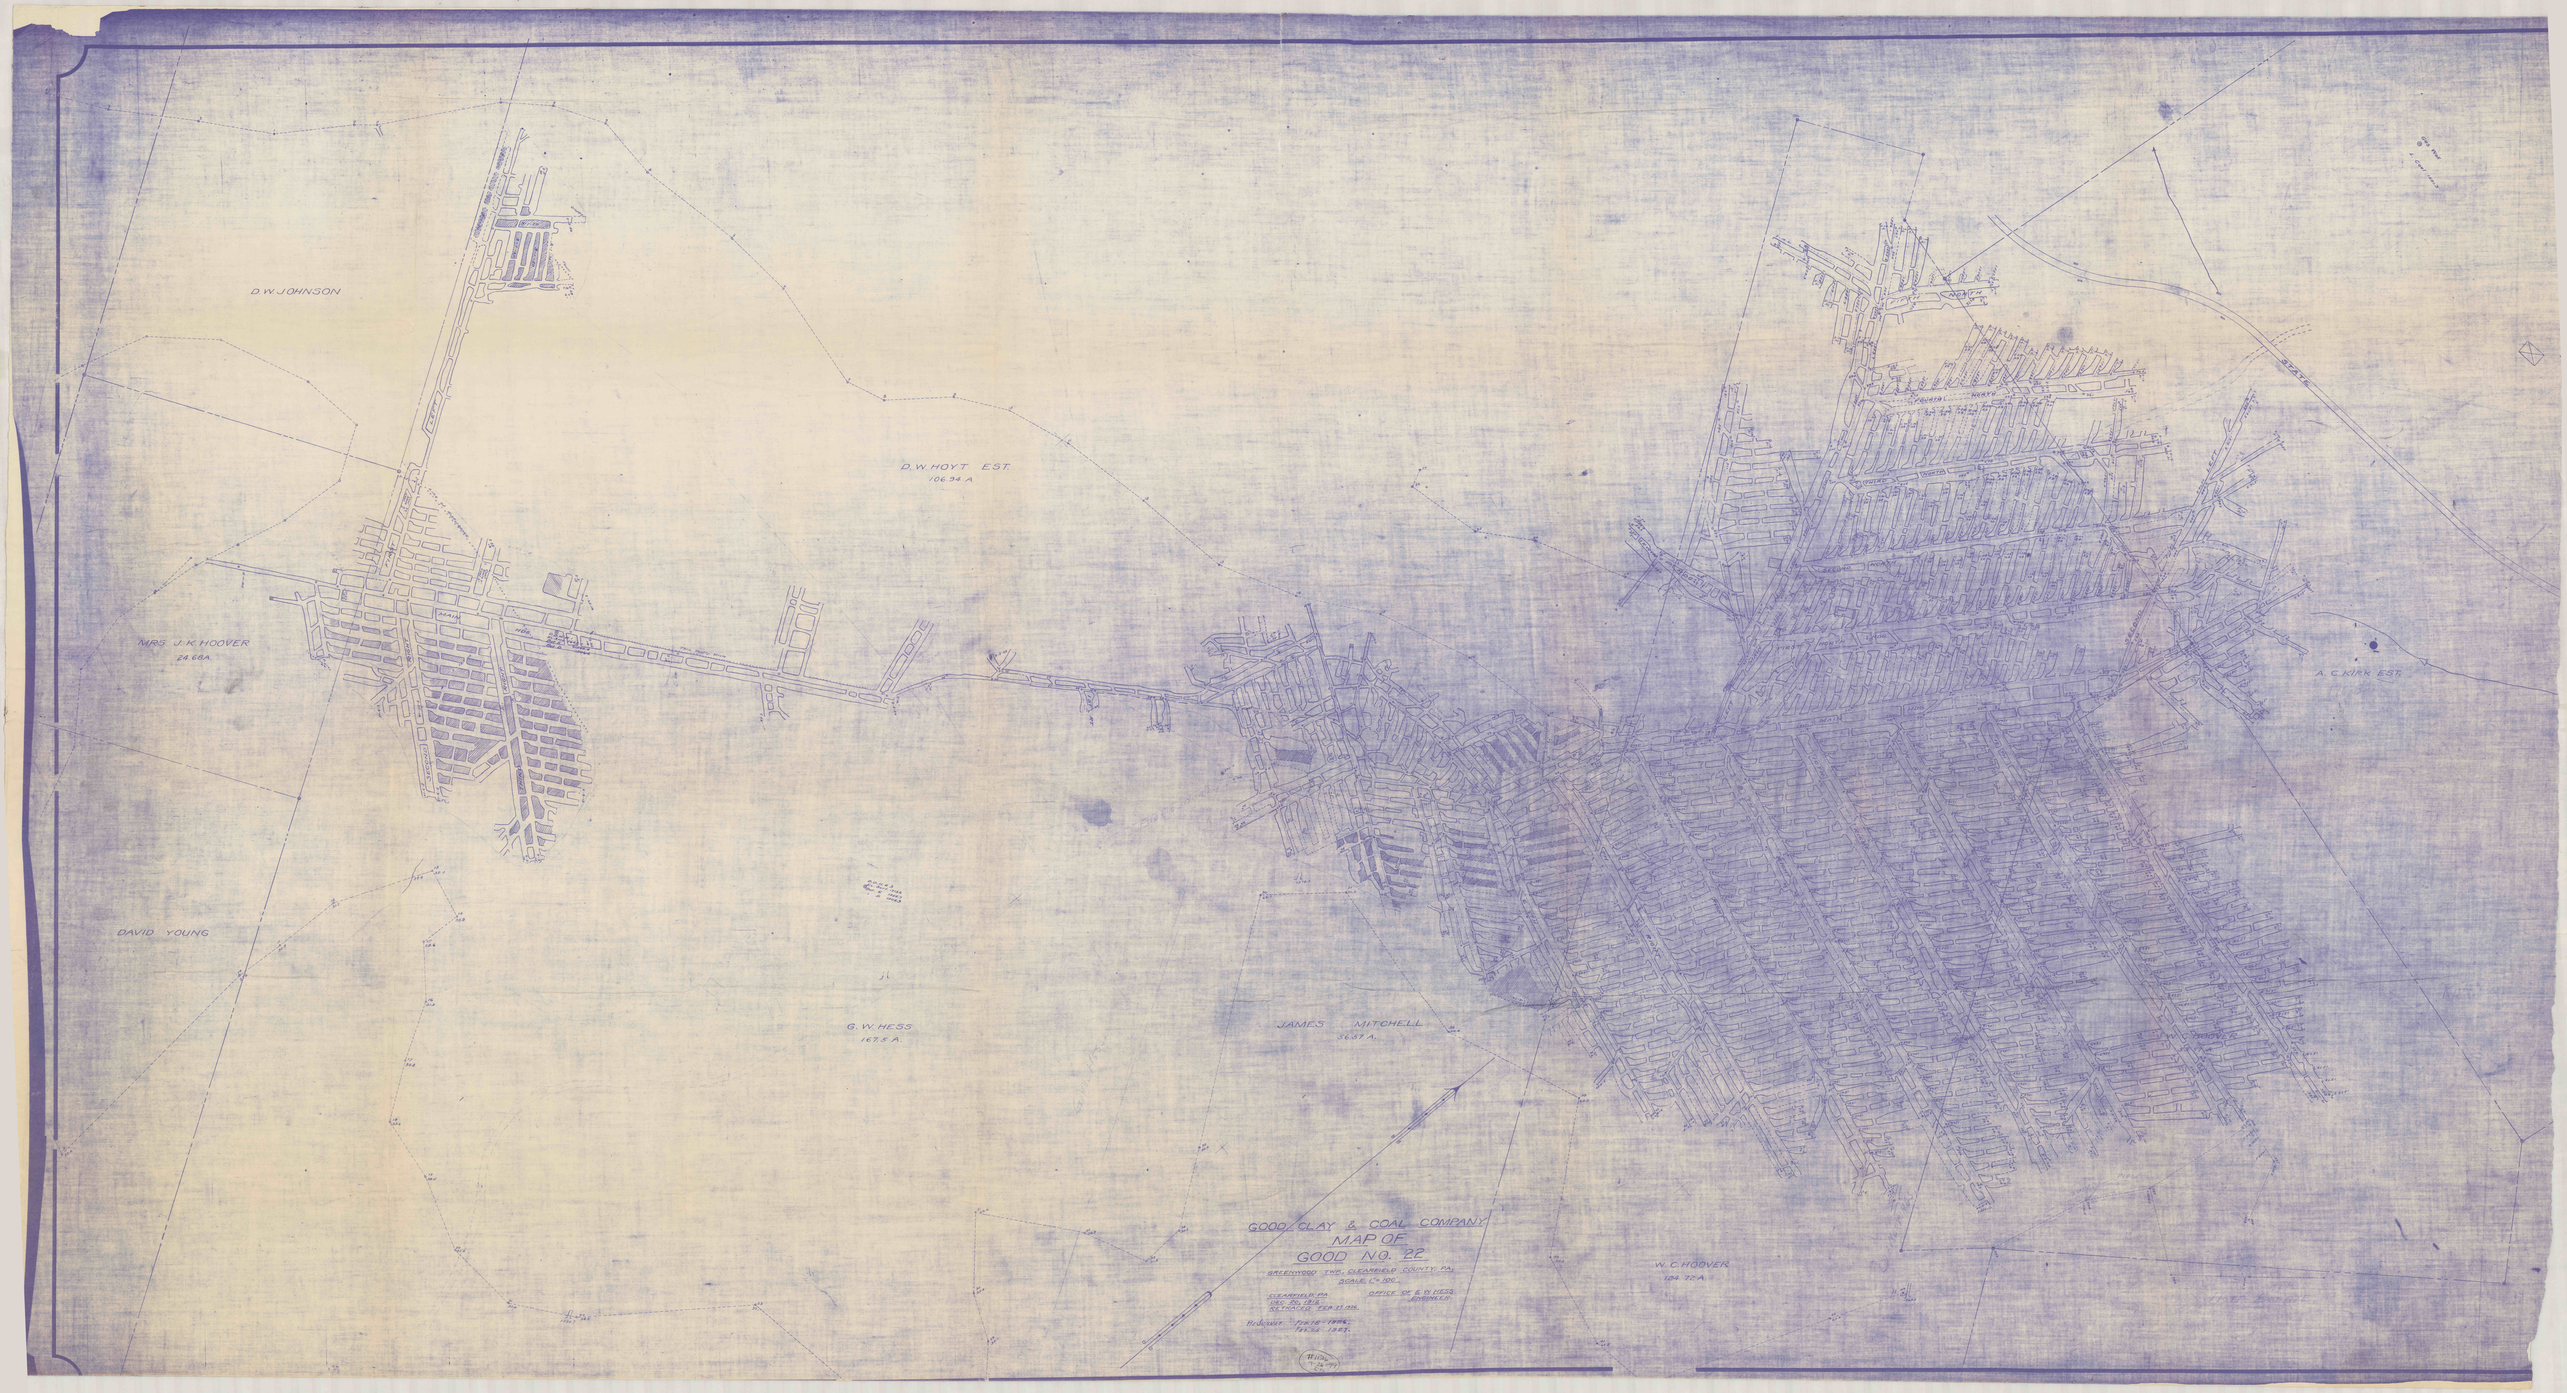
D.W. JOHNSON
D.W. HOYT EST.
106.94 A.
MRS. J.K. HOOVER
24.68A.
DAVID YOUNG
G.W. HESS
167.5 A.
JAMES MITCHELL
36.57 A.
W.C. HOOVER
134.72 A.
A.C. KIRK EST.
GOOD CLAY & COAL COMPANY
MAP OF
GOOD NO. 22
GREENWOOD TWP. CLEARFIELD COUNTY, PA.
SCALE 1" = 200'
CLEARFIELD PA.
DEC. 20, 1918
OFFICE OF G.W. HESS
ENGINEER