


■ Mining - May 3, 1969 to November 3, 1969  
 ■ Mining Completed  
 Survey Date May 1, 1969

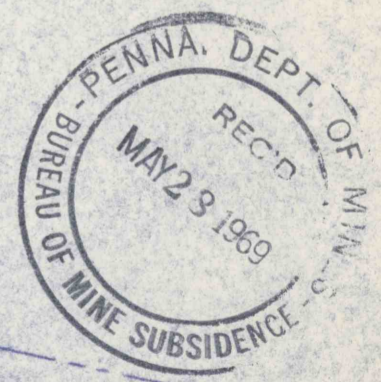

Lyda Coal Co.  
 Graff Nos. 1 & 2 Mines  
 Derry Twp., Westmoreland Co., Pa.  
 Scale 1"=100' June 16, 1966  
 Graff Engineering Co.  
 Blairsville, Pa.

2434  
 #1146  
 7-26-99  
 CC