

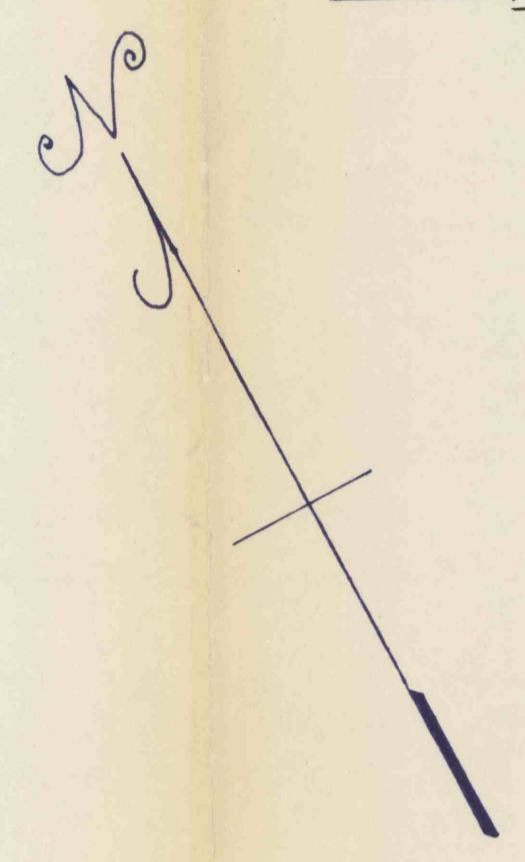


——— AREA TO BE MINED IN THE NEXT SIX MONTHS *to 8-28-68*  
 ——— AREA OF SURFACE LAND OVERLYING THE MINE  
 ——— AREA WHERE MINING OPERATIONS HAVE BEEN COMPLETED

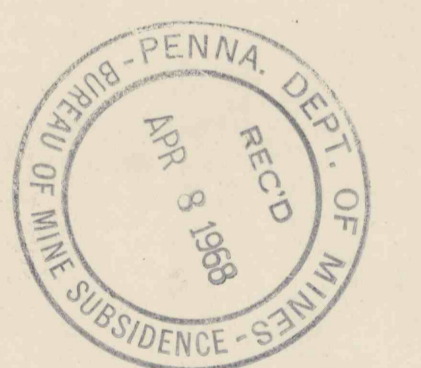

**FENUSH SURF. - C.B.C. CORP. COAL**

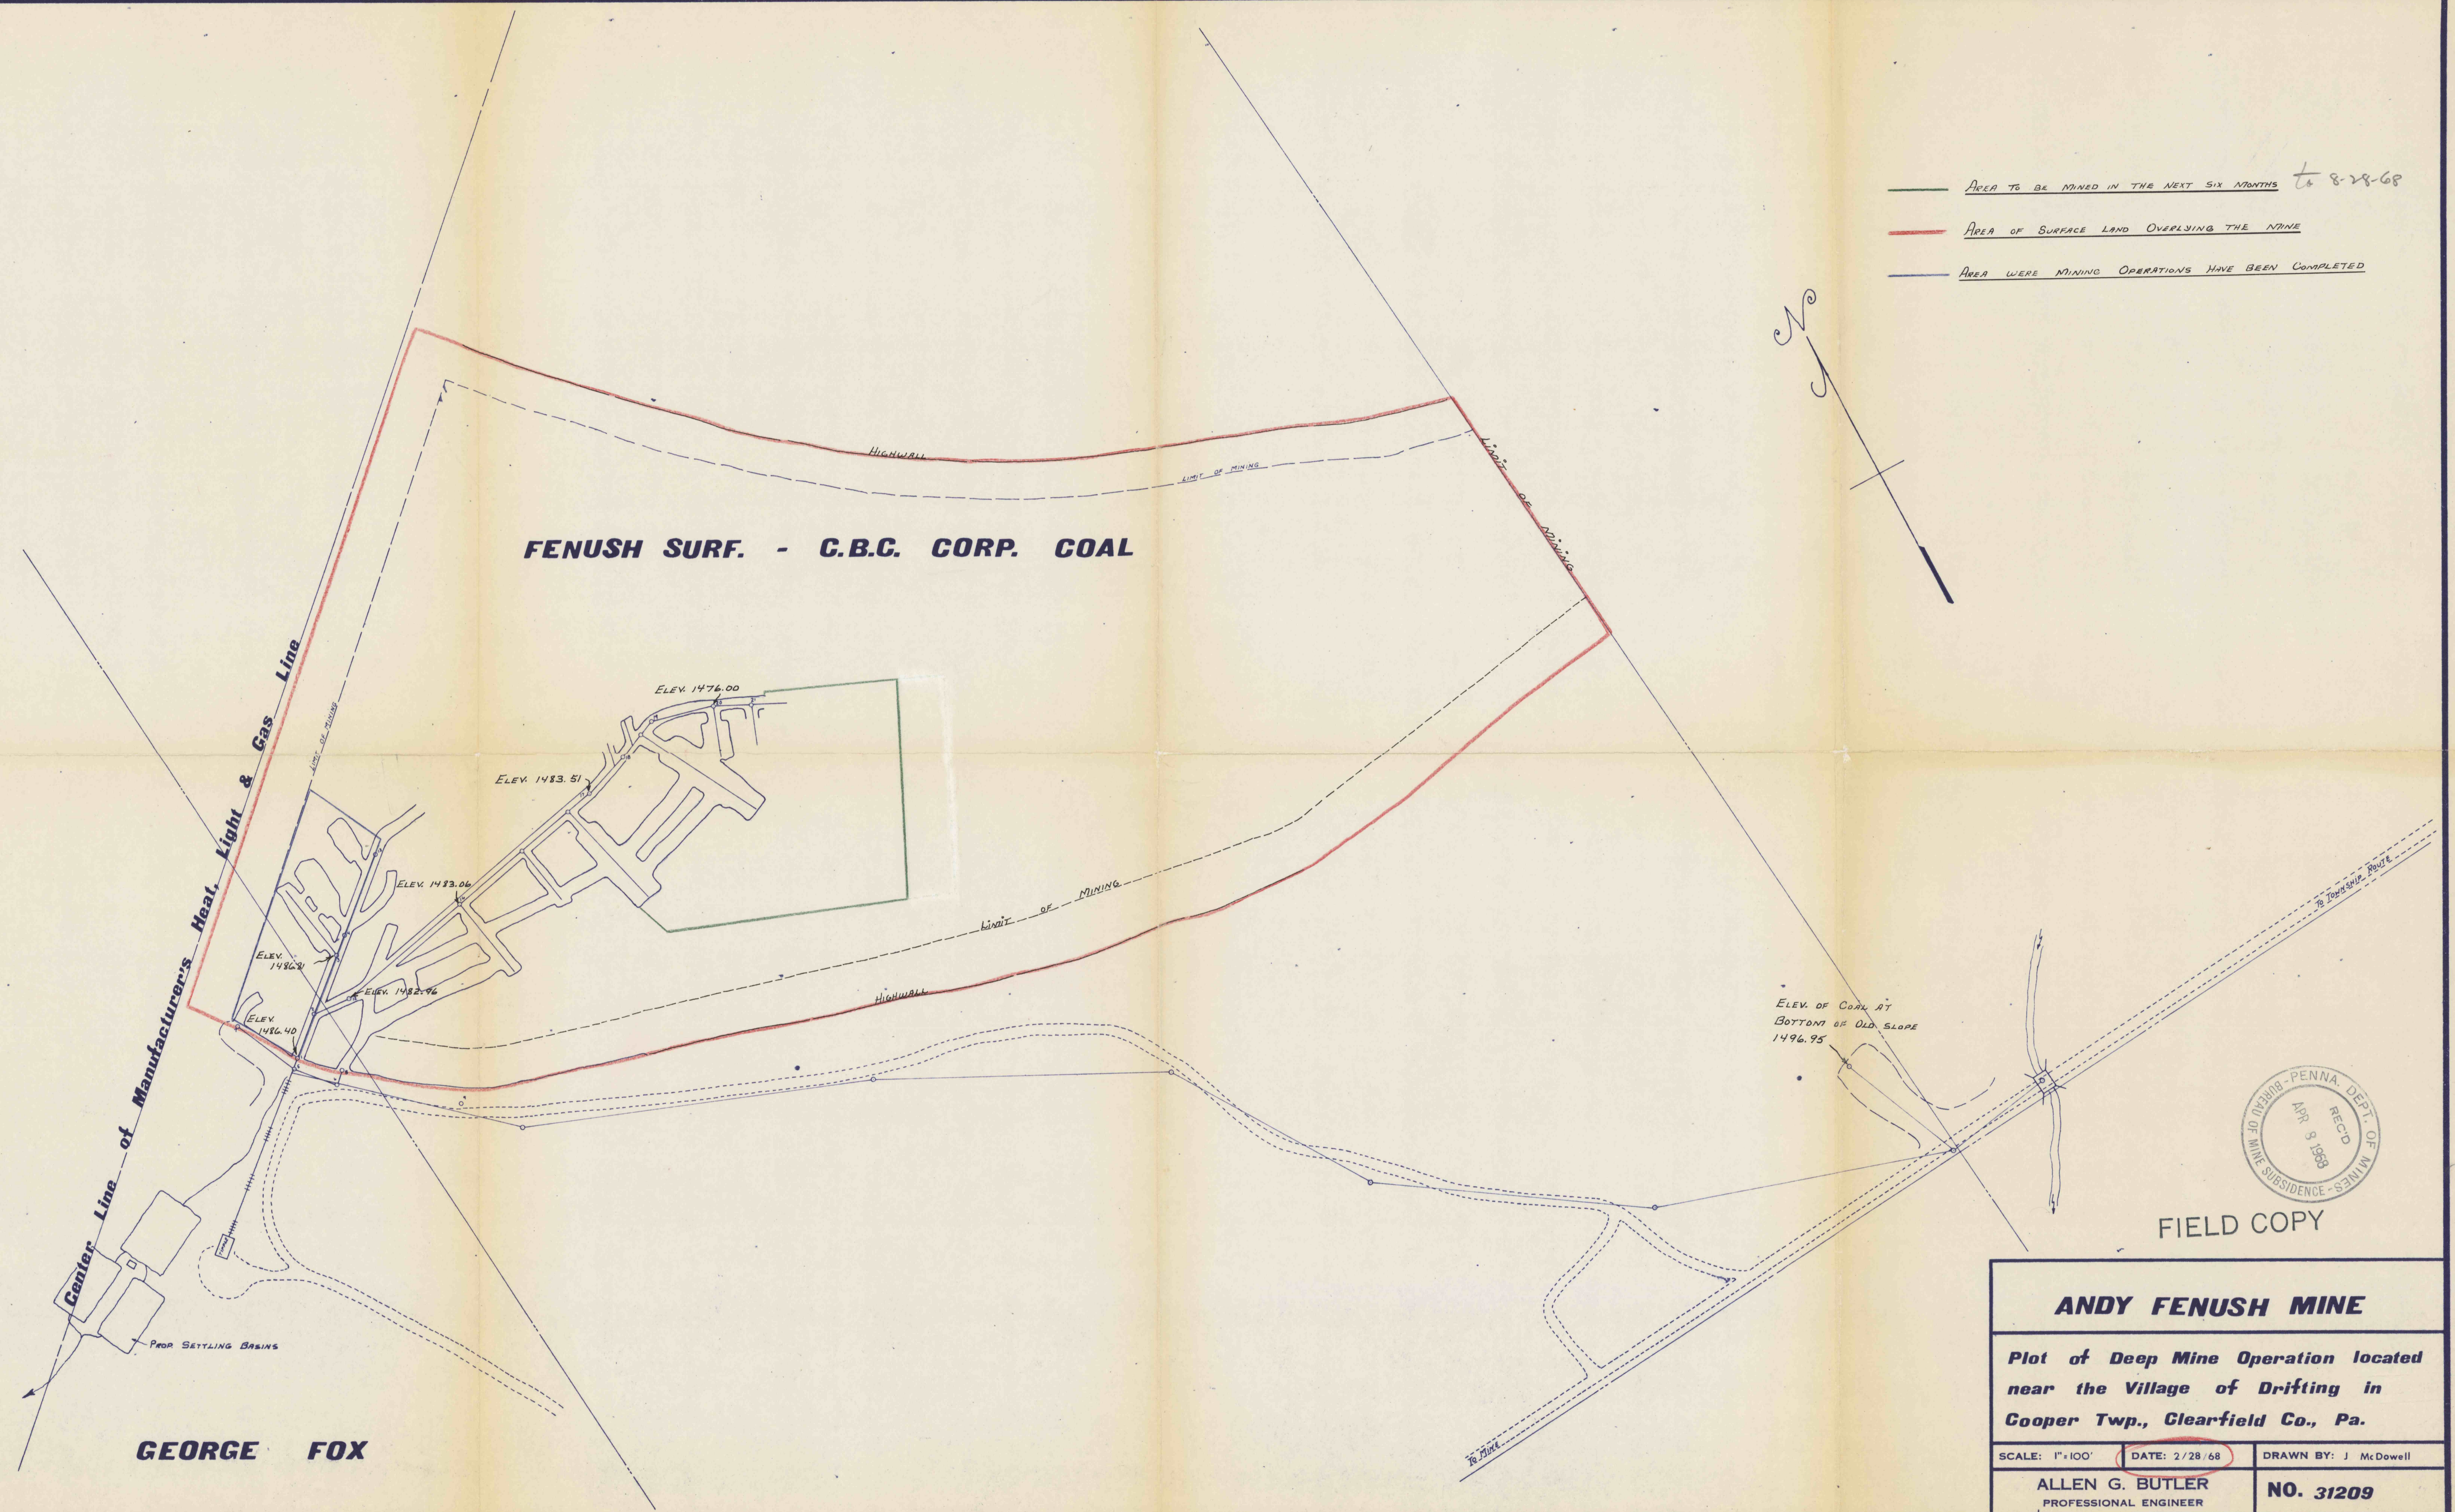

FIELD COPY

<b>ANDY FENUSH MINE</b>		
Plot of Deep Mine Operation located near the Village of Drifting in Cooper Twp., Clearfield Co., Pa.		
SCALE: 1"=100'	DATE: 2/28/68	DRAWN BY: J. McDowell
ALLEN G. BUTLER PROFESSIONAL ENGINEER		NO. 31209

**GEORGE FOX**