



Wm. JOHNSON ESTATE

FLAT RUN 5TH LEFT  
 WORKED OUT  
 FORCEY-SCHOONOVER ESTATE

WORKED OUT

WORKED OUT

WORKED OUT

WORKED OUT

FORCEY-SCHOONOVER ESTATE  
 WORKED OUT

WORKED OUT


WORKED OUT

OLD

GREEN VALLEY B MINE

PROPOSED NEW DRIPT

HIGHWALL STRIPPING

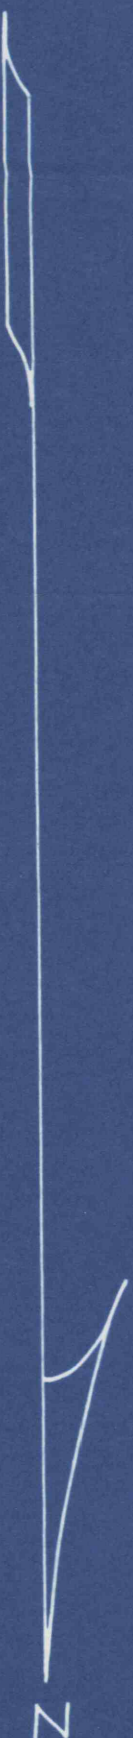

— MAP SHOWING PORTIONS OF FLAT RUN & GREEN VALLEY MINES —  
 — OPERATED BY L. & E. COAL COMPANY —  
 — GRAHAM TOWNSHIP CLEARFIELD COUNTY PENNSYLVANIA —  
 — SCALE 1" = 100' — OCT. 3, 1957 —  
 — BERNARD LUCAS ASSOC. —

#1155  
 7-26-57