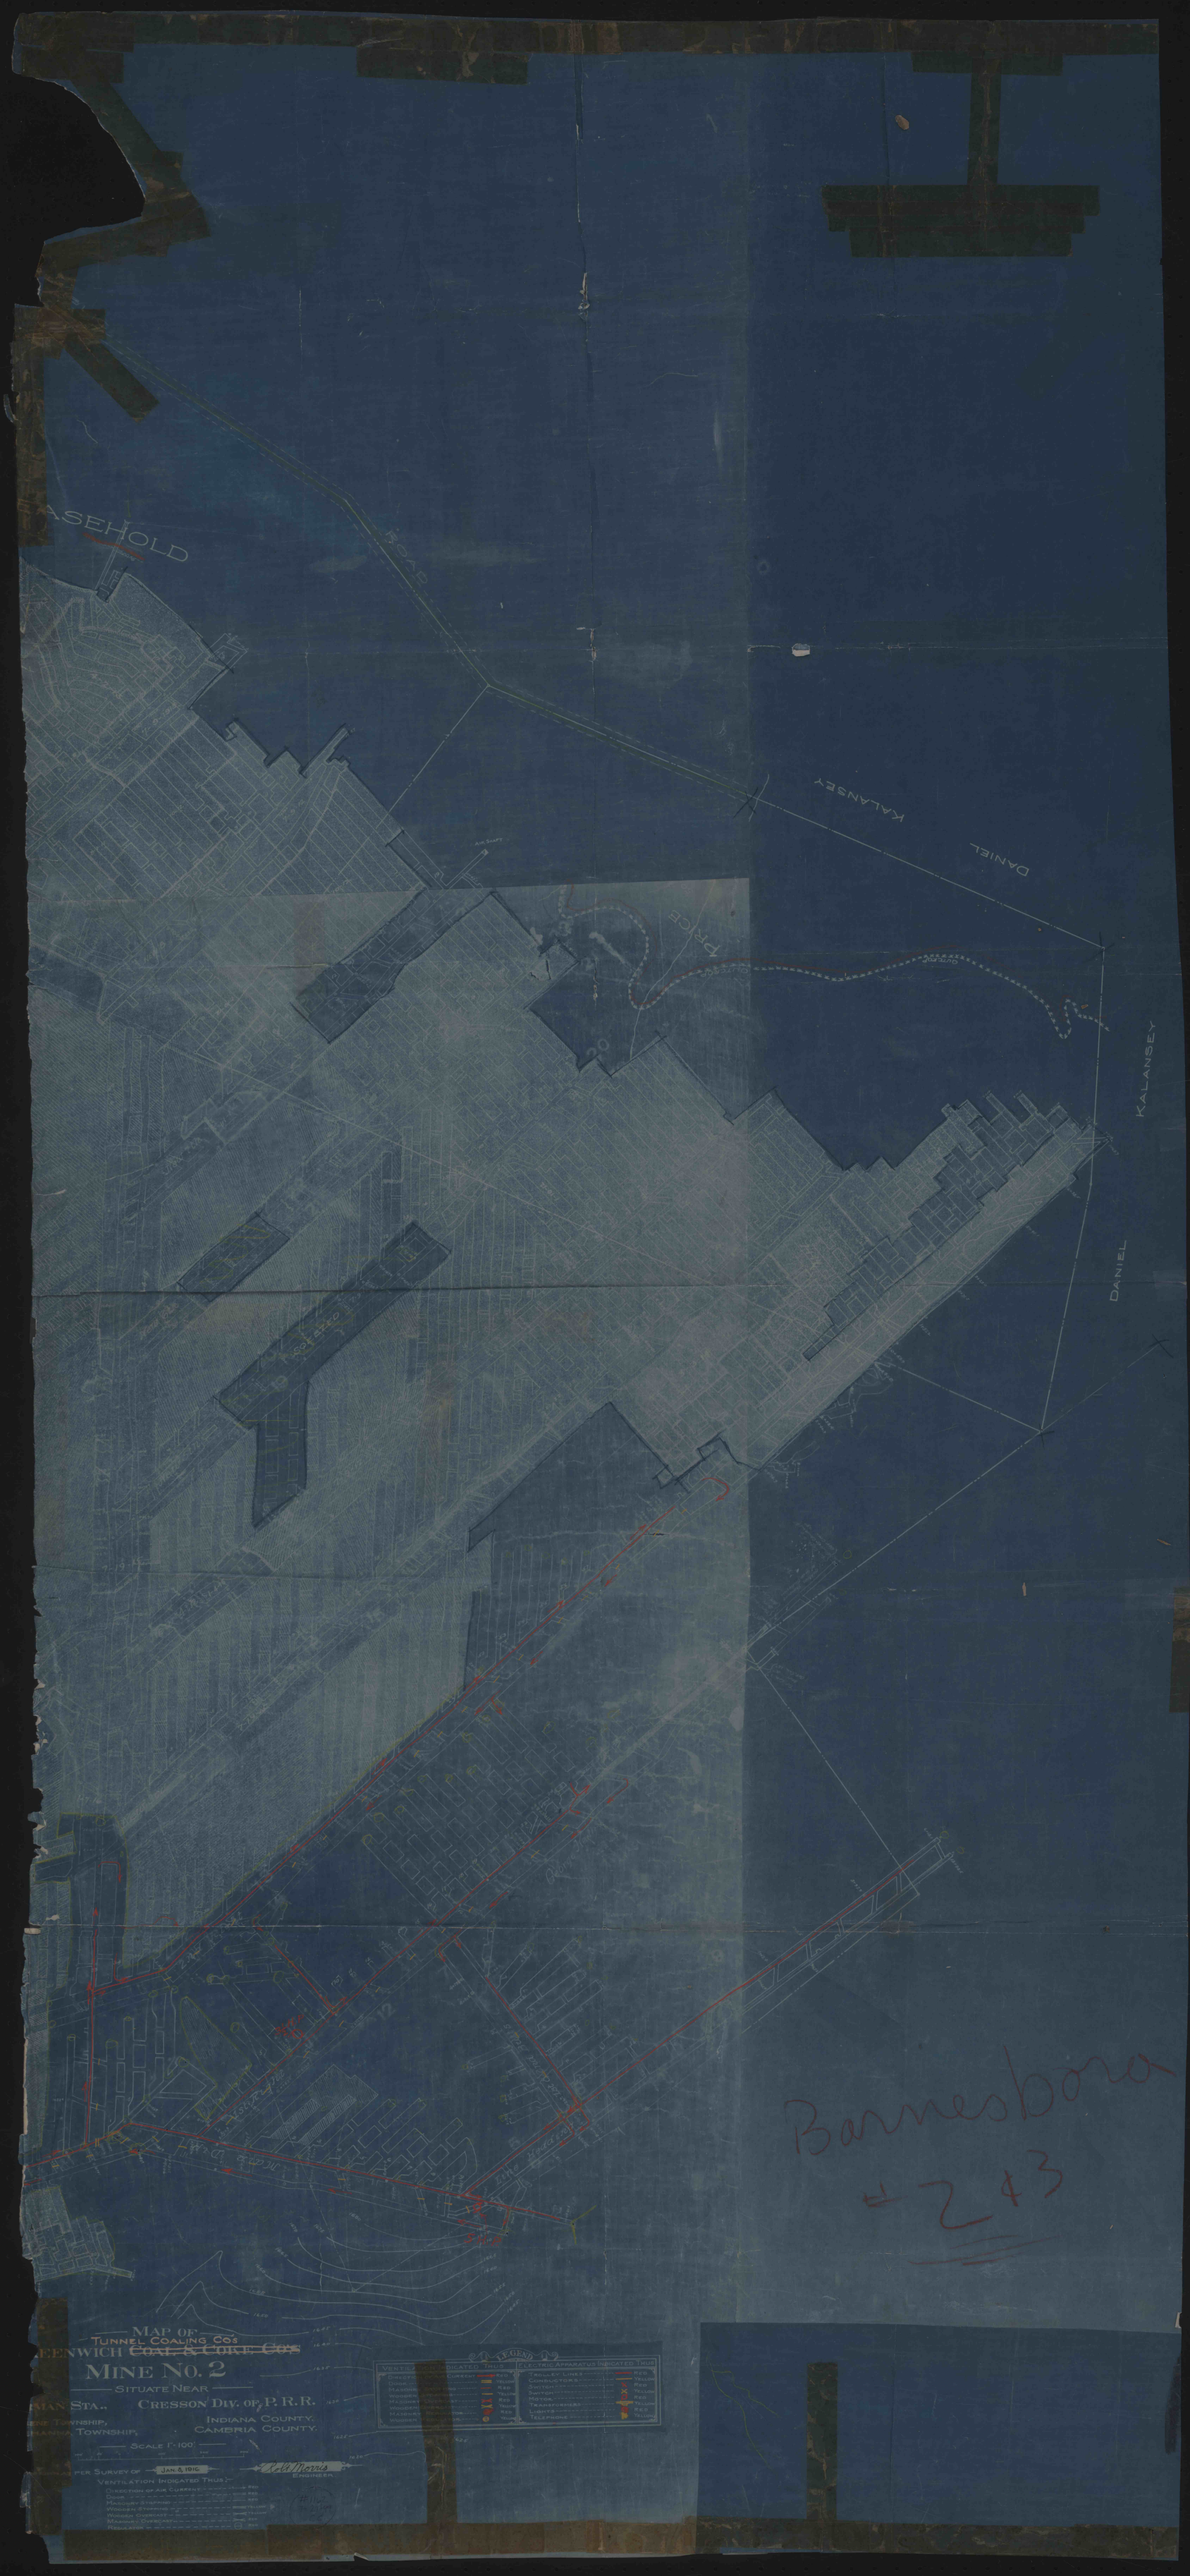

ASEHOLD
ROAD
KALANSEY
DANIEL
PRICE
KALANSEY
DANIEL
MAP OF
TUNNEL COALING CO'S
EENWICH ~~COAL & COKE CO'S~~
MINE NO. 2
SITUATE NEAR
MAN STA., CRESSON DIV. OF P. R. R.
INDIANA COUNTY.
CAMBRIA COUNTY.
SCALE 1"=100'
JAN. 6 1916
Ed. Morris
ENGINEER
VENTILATION INDICATED THUS:-
LEGEND
Barnesboro
#2 & 3