


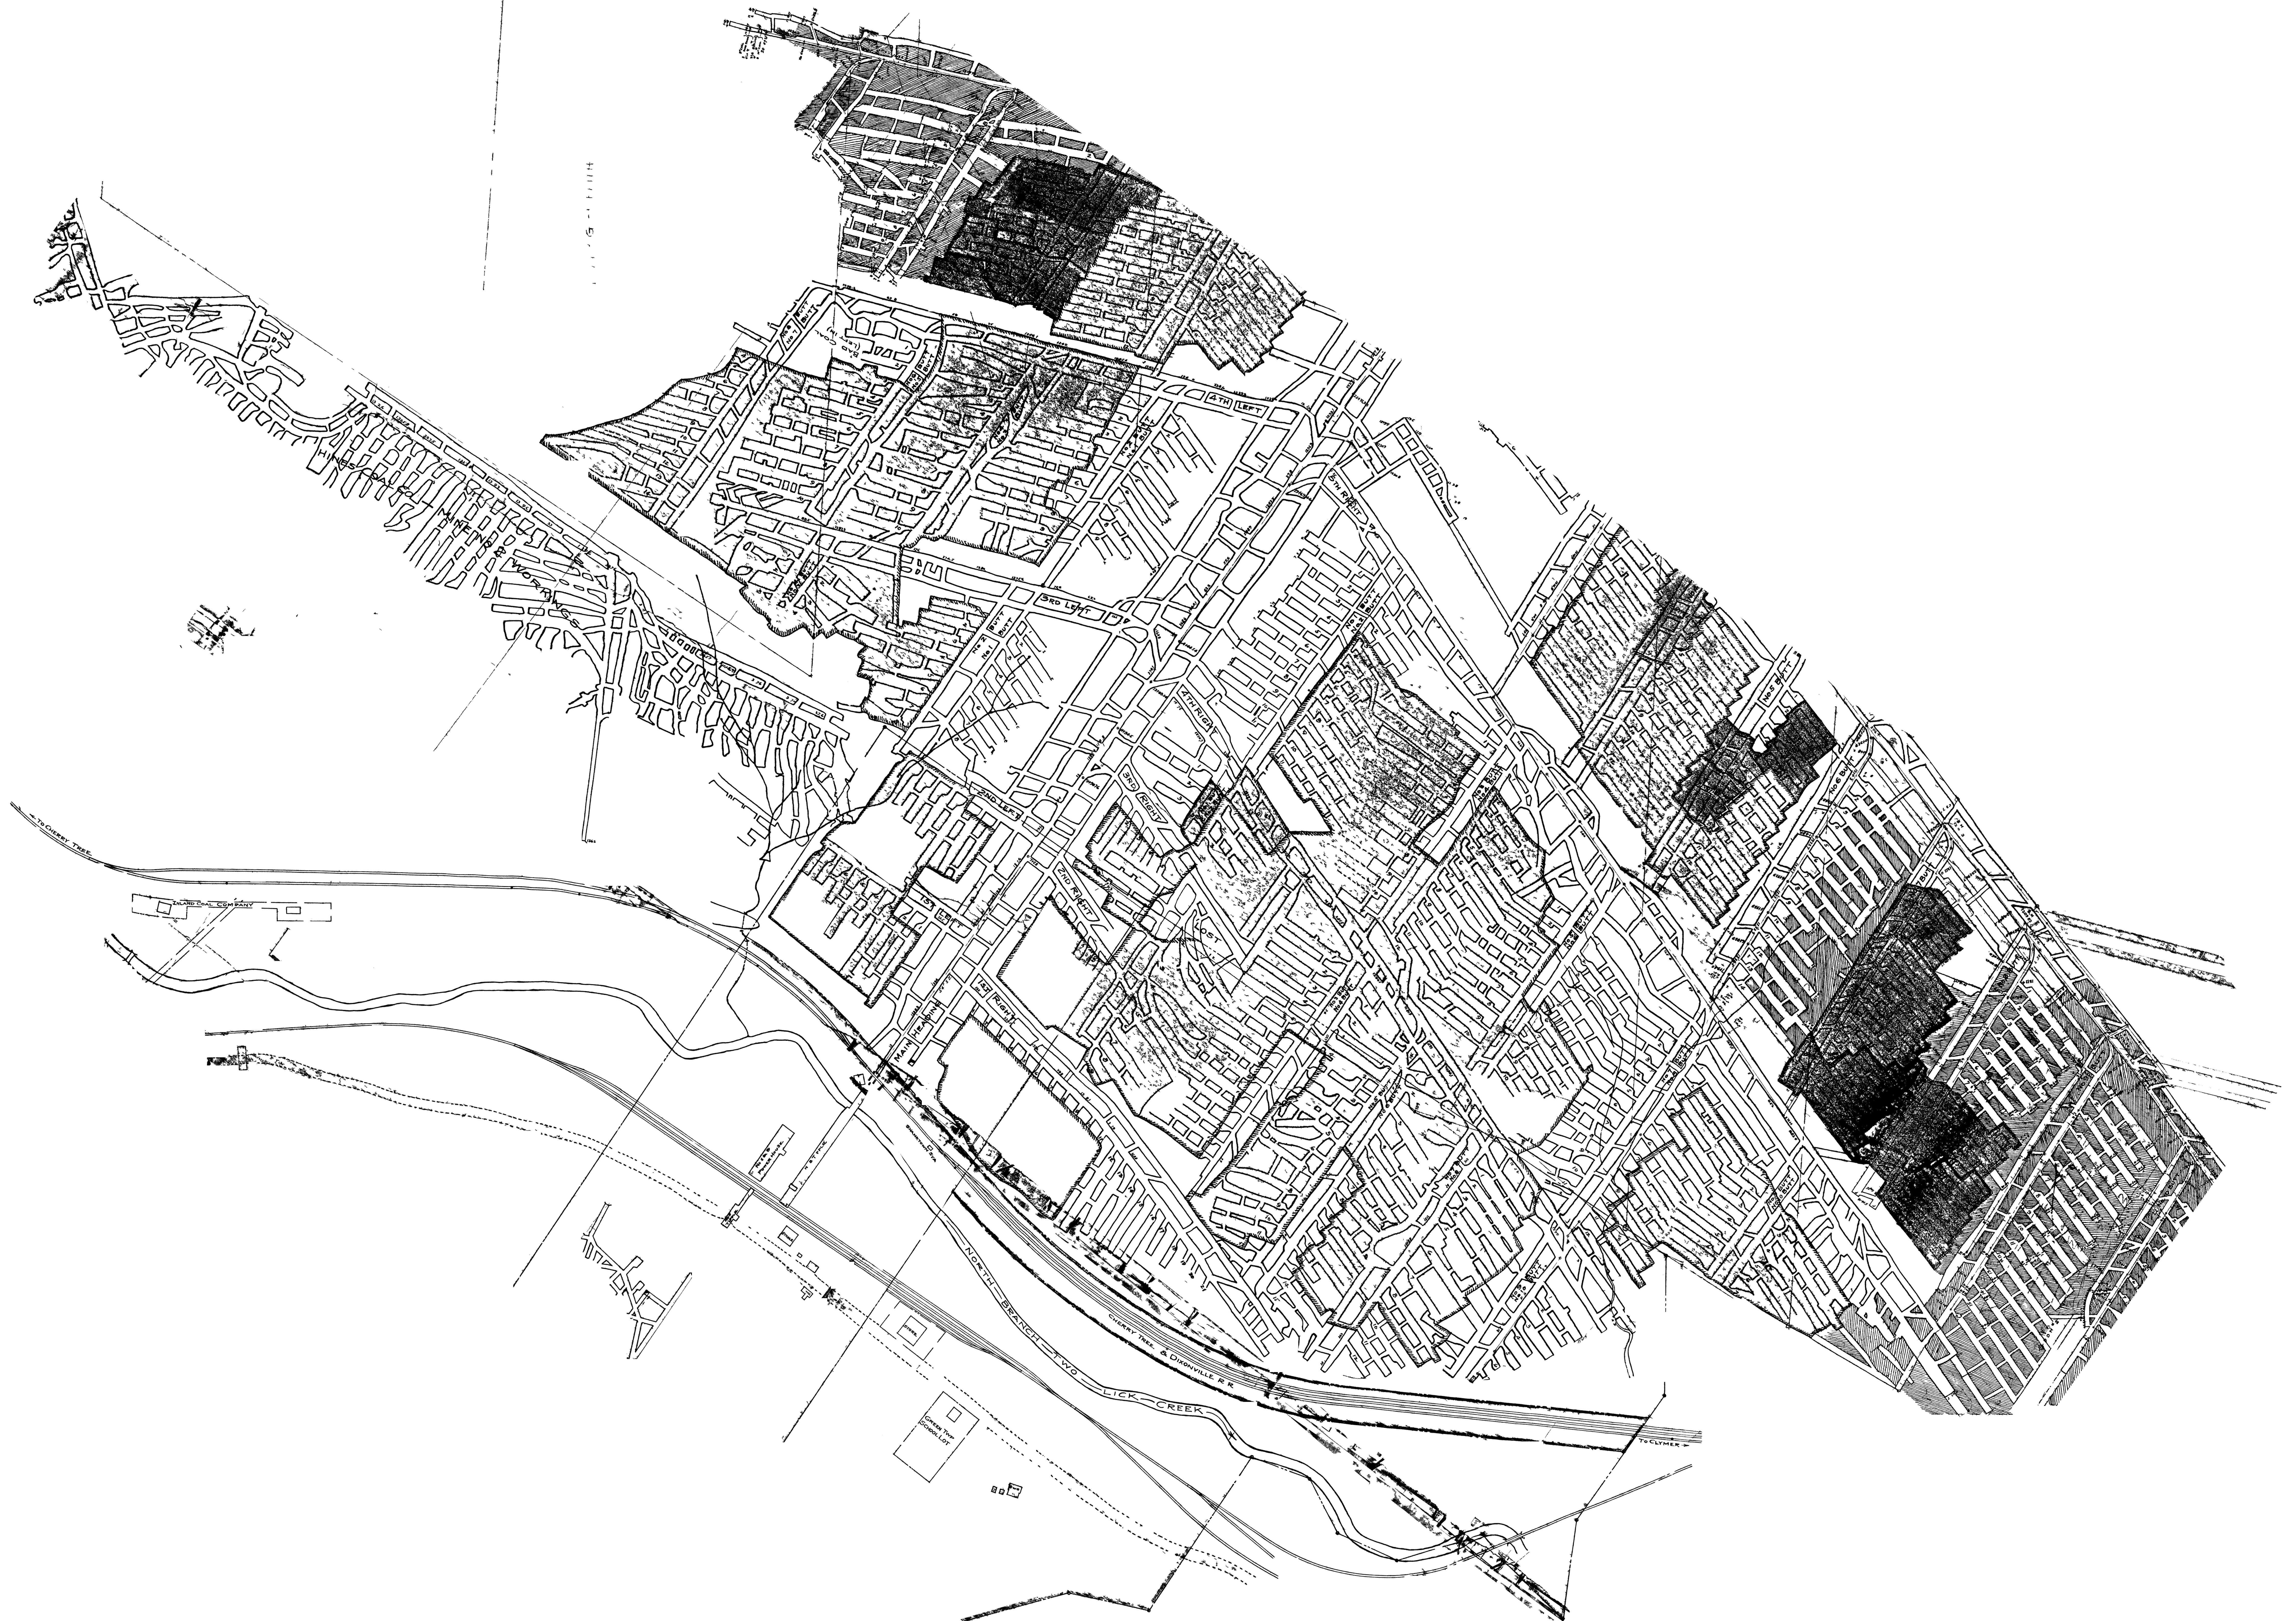

MAP OF
GREENVILLE
SITUATE AT
CHERRY TREE & DIXON ST.
Greene Township,
Indiana
SCALE 1/4" = 100 FT.
Map prepared by the State of
Indiana