

BERWIND CORP.
COAL & SURFACE


TR. 705
BERWIND CORP.
COAL & SURFACE

← To WINDSOR

TR. 750
BEN GAW REALTY INC. SURFACE
BERWIND CORP. COAL

- LEGEND**
- No ADDITIONAL MINING IN THIS AREA
 - LEASE LINE
 - MINING ADVANCED TO FEB-28-68

Map Showing Mine Workings
C' Seam Lease No 212
Grela Coal Co.
Paint Twp, Somerset Co., Pa.
1" = 100' 13 Nov. 1961
R. W. Maloy, Cert. E.I.T. Rev. 20 Dec. 1963
(Formerly Cominsky Coal Co.)

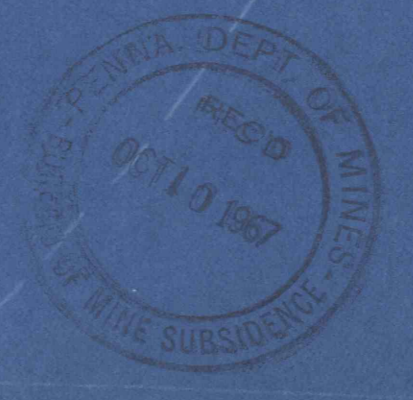

FIELD COPY

#1165
11-27-61
R.W.M.