McKnight Heirs

Northwest Mining + Exchange Co

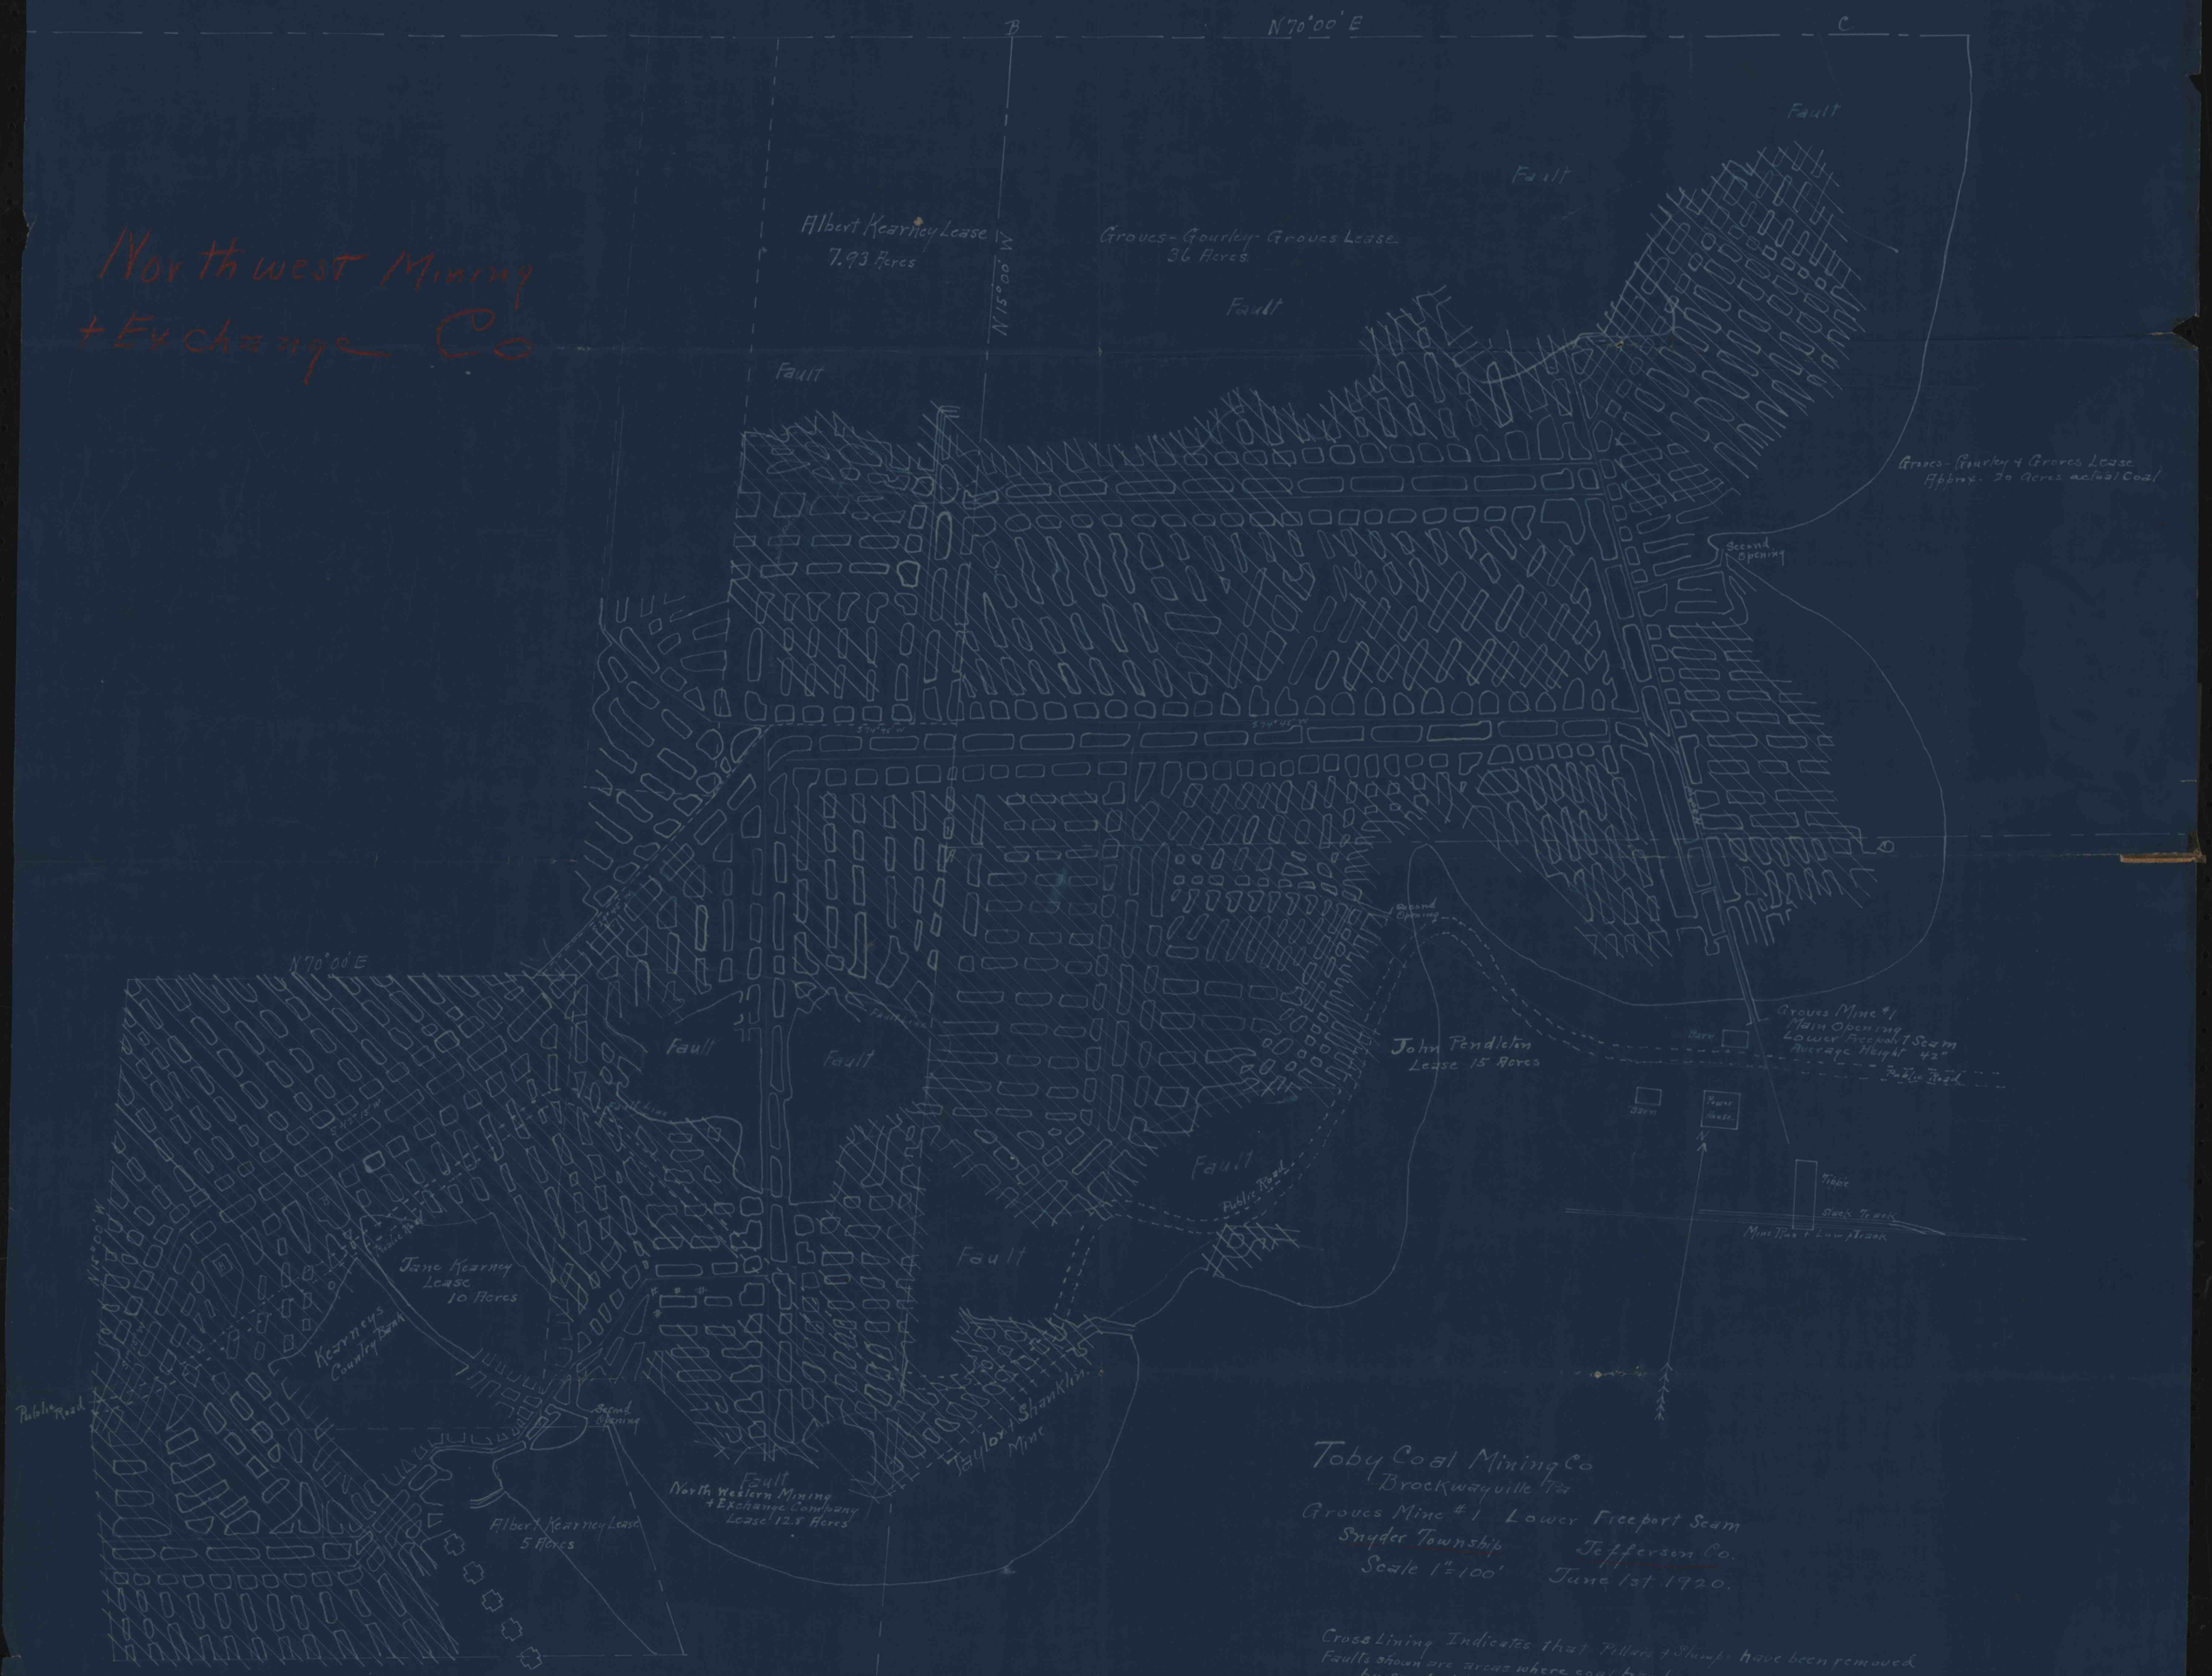

Toby Coal Mining Co
Brockwayville Pa.
Groves Mine #1 Lower Freeport Seam
Snyder Township Jefferson Co.
Scale 1" = 100' June 1st 1920.

Cross Lining Indicates that Pillars & Stumps have been removed
Faults shown are areas where coal has been washed out and replaced by sandstone: This causes thinning of coal seam and some times entire removal. They are not true geological faults.