


McKnight Heirs.

Rochester + Pittsburg Coal + Iron Company

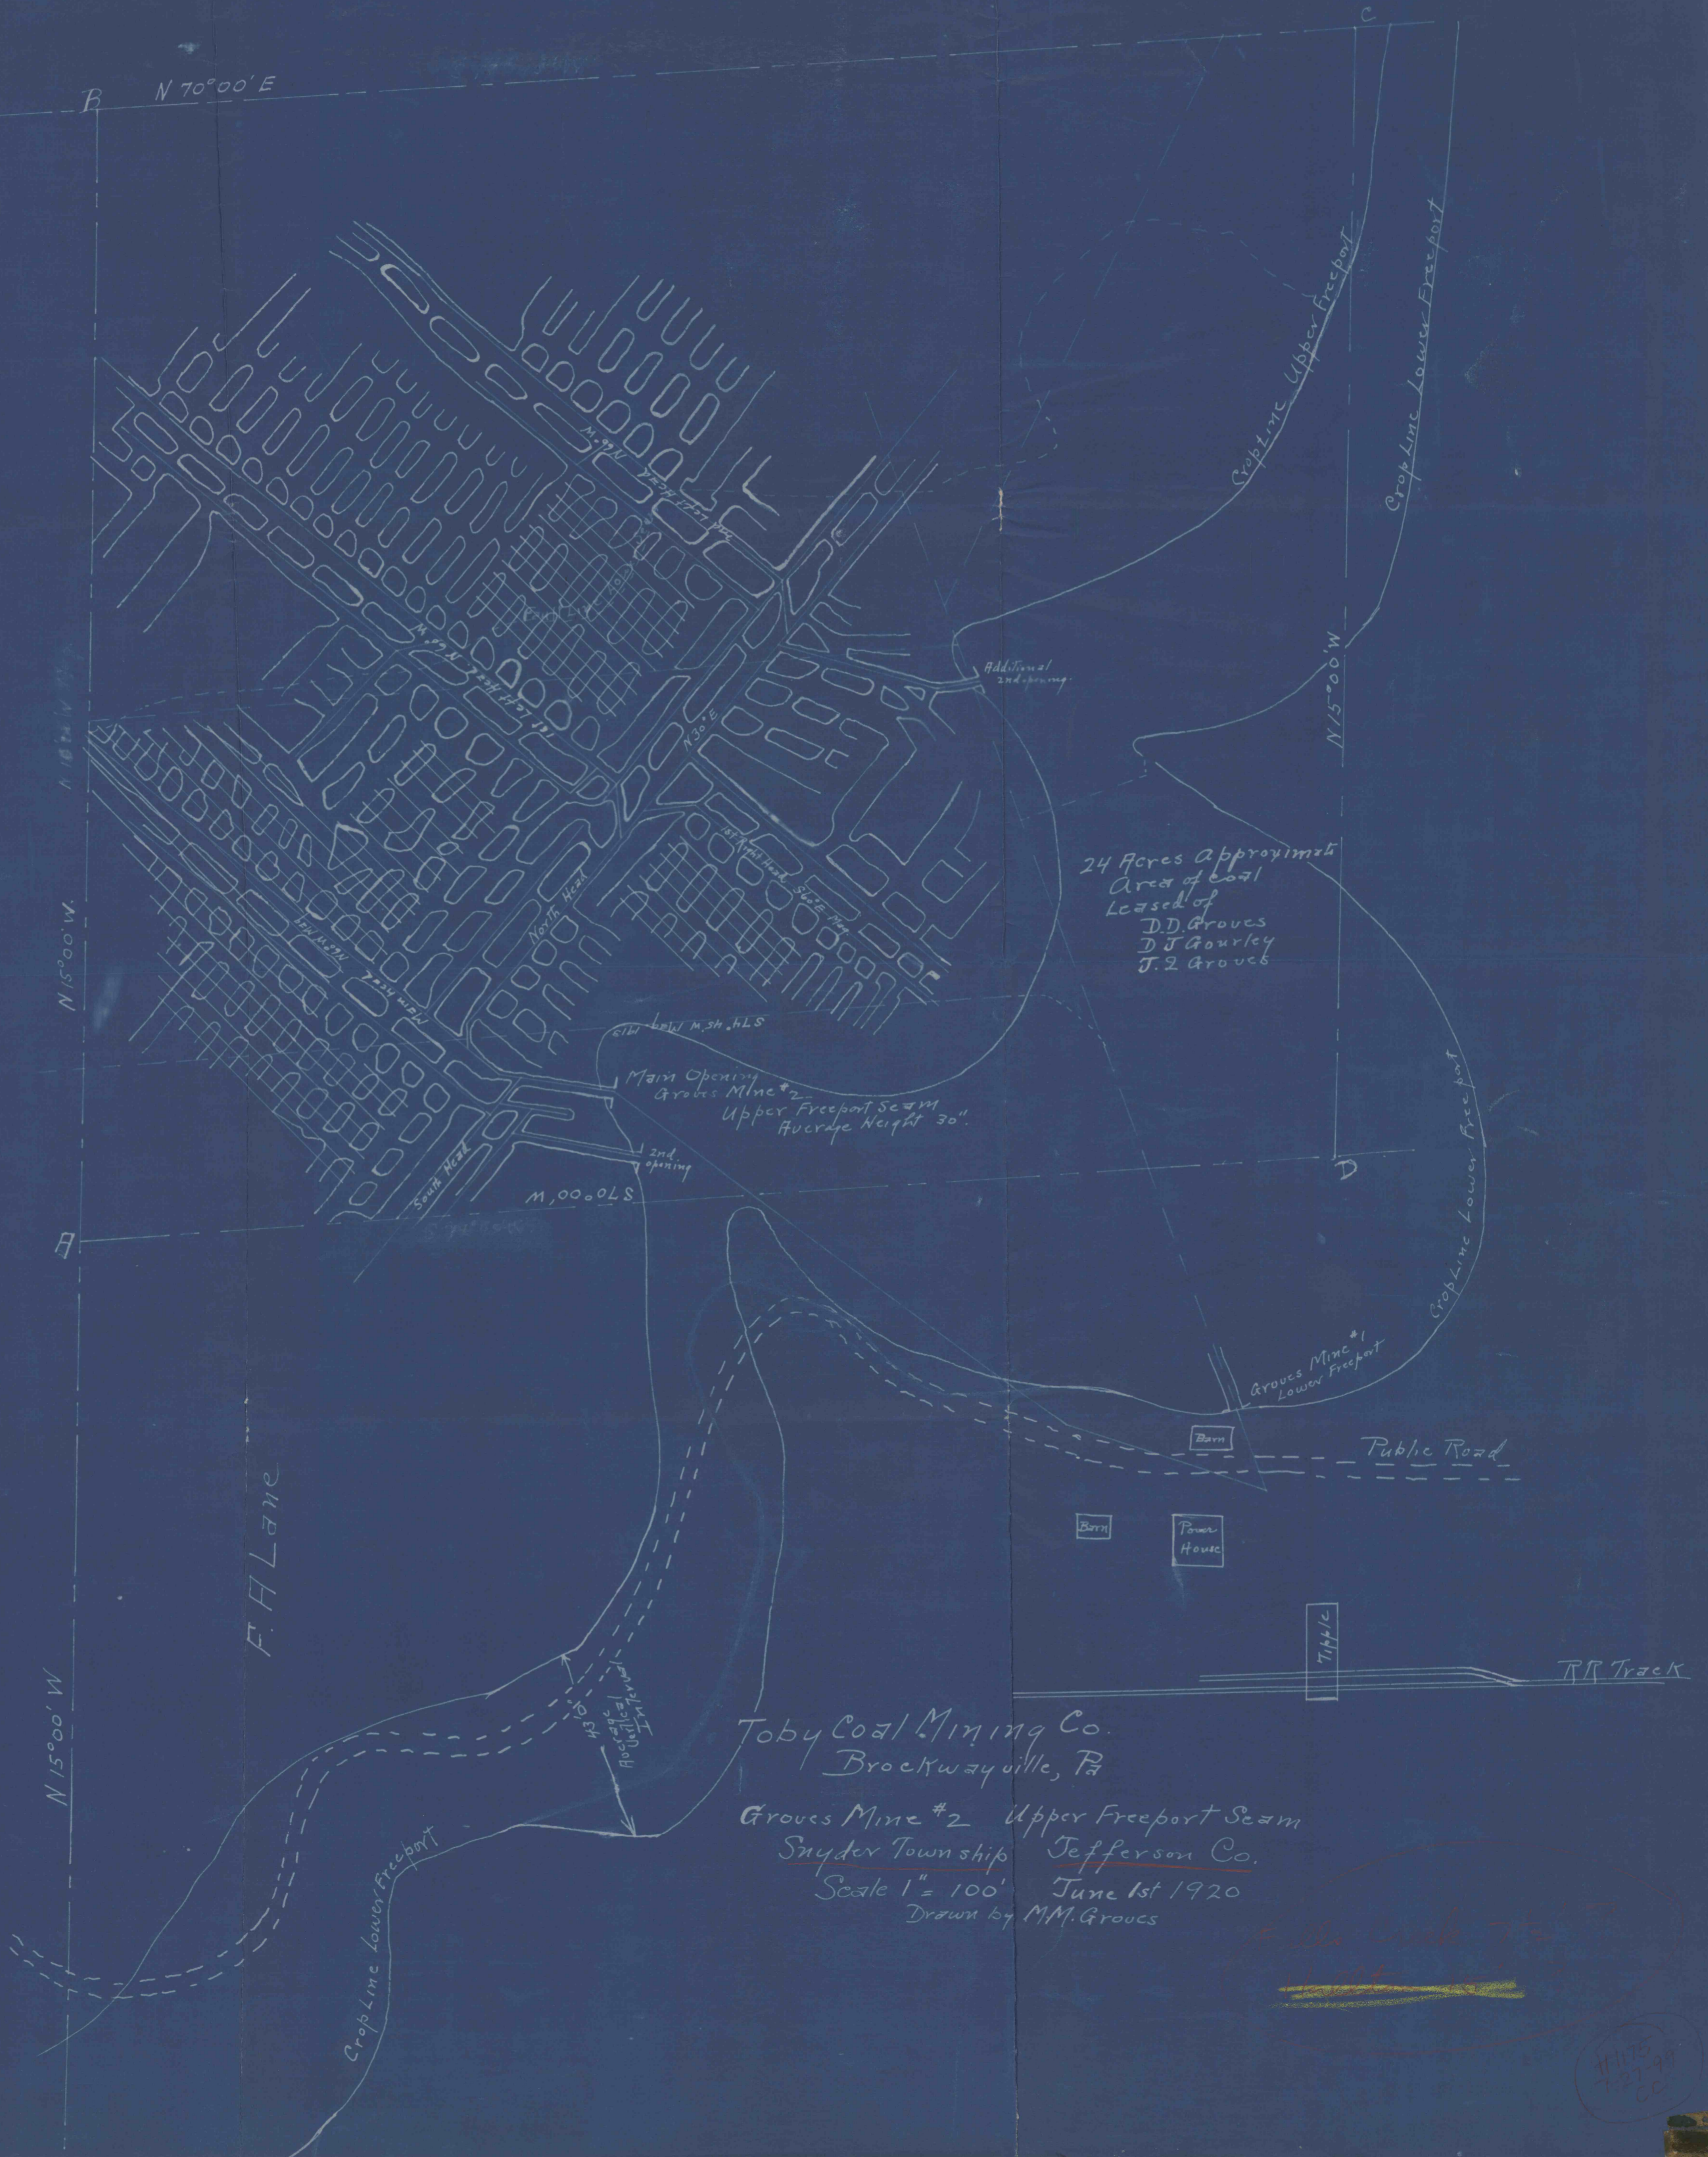

24 Acres Approximately
 Area of coal
 Leased of
 D.D. Groves
 D.J. Gourley
 J. Z. Groves

Toby Coal Mining Co.
 Brockwayville, Pa

Groves Mine #2 Upper Freeport Seam
 Snyder Township Jefferson Co.
 Scale 1" = 100' June 1st 1920
 Drawn by M.M. Groves

W 1125
 7-27-27
 CC