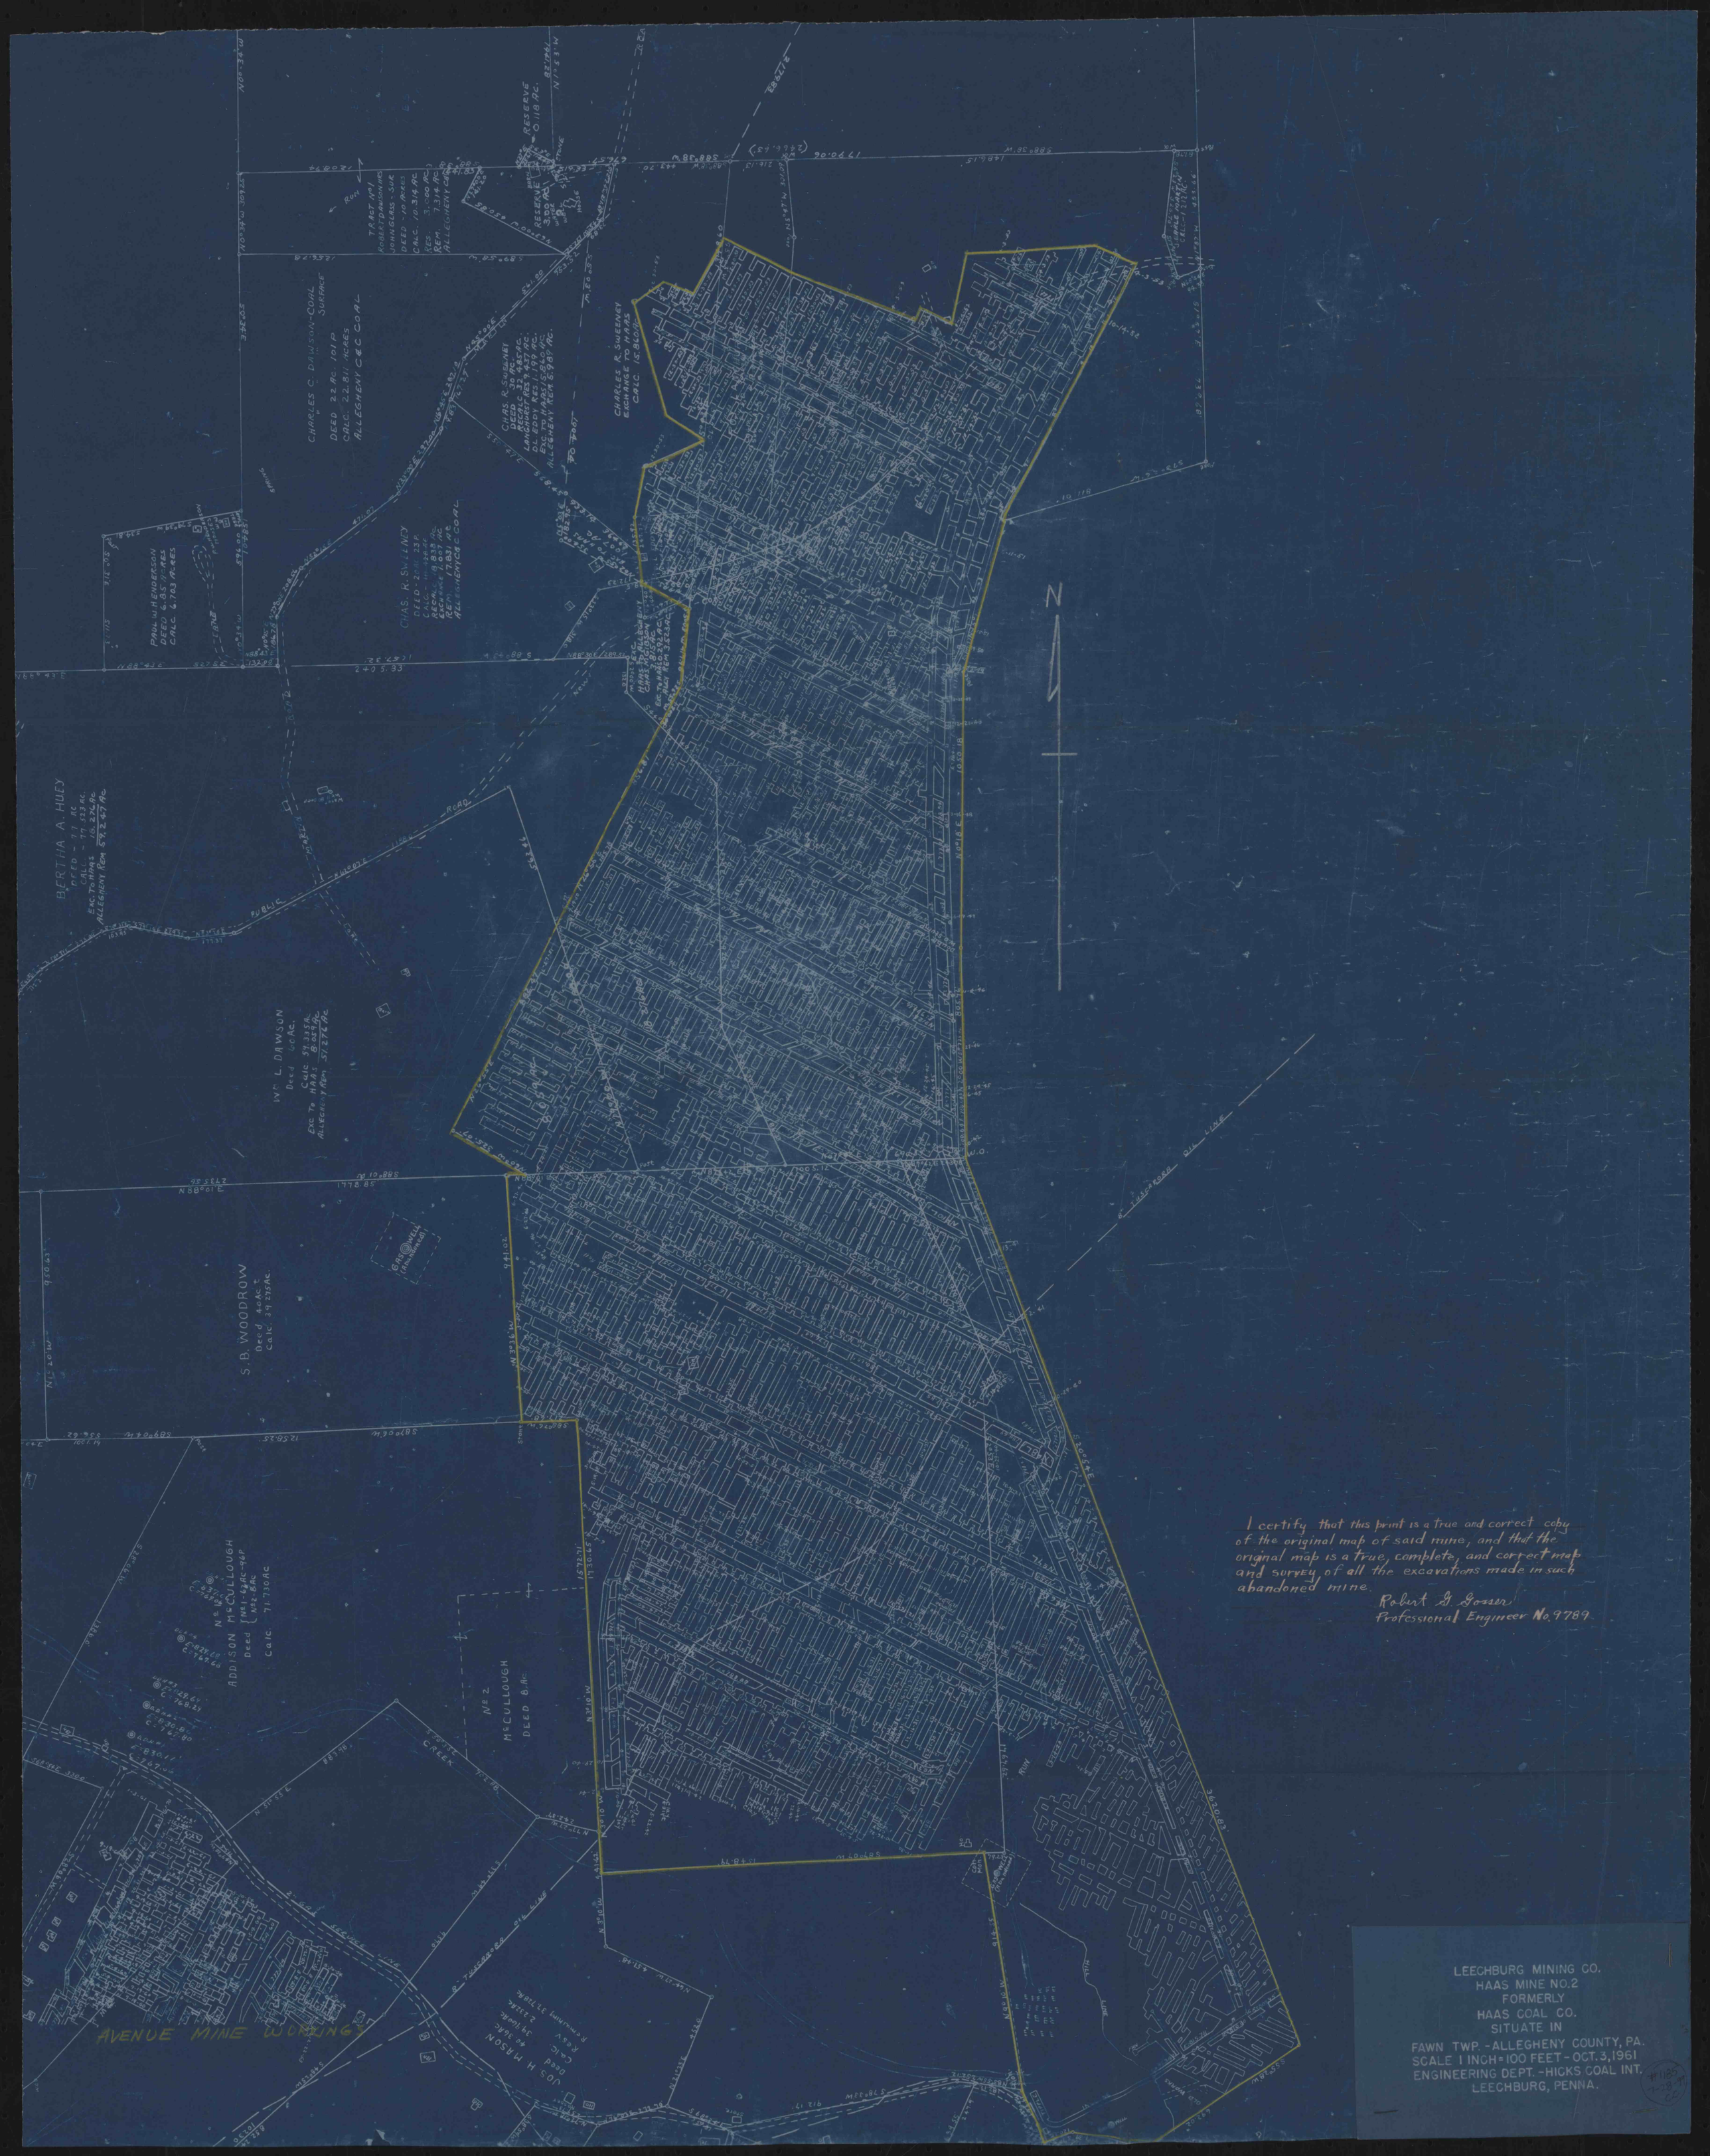
CHARLES C. DAWSON-COAL SURFACE
DEED 22 Ac. 101 P.
CALC. 22.811 ACRES
ALLEGHENY C&C COAL
TRACT No1
ROBERT DAWSON HEIRS
JOHN GLASS - SUR
DEED - 10 ACRES
CALC. 10.314 AC
RES. 3.000 AC.
REM. 7.314 AC
ALLEGHENY C&C COAL
RESERVE 0.118 AC.
RESERVE 3.00 AC.
CHAS. R. SWEENEY
DEED 30 AC.
RESRVE 3.00 AC.
LAUGHURST RES 9.447 AC.
D.L. EDDY RES 1.199 AC.
EXC. TO HAAS 5.860 AC.
ALLEGHENY REM 6.984 AC.
CHARLES R. SWEENEY
EXCHANGE TO HAAS
CALC 15.860 AC.
CHAS. R. SWEENEY
DEED - 2nd 23 P.
CALC. 11.439 AC.
RESRVE 9.838 AC.
EXCHANGE 1.607 AC.
REM. 17.831 AC.
ALLEGHENY C&C COAL
PAUL W. HENDERSON
DEED 6.85 ACRES
CALC. 6.703 ACRES
BERTHA A. HUEY
DEED - 77 AC
CALC. - 77.523 AC.
EXC. TO HAAS 18.276 AC.
ALLEGHENY REM 59.247 AC
IVA L. DAWSON
Deed 60 AC.
Calc 59.335 AC.
EXC TO HAAS 8.059 AC.
ALLEGHENY REM 51.276 AC.
S.B. WOODROW
Deed 40 AC.t
Calc. 39.275AC.
GAS WELL (Abandoned)
ADDISON McCULLOUGH
Deed No1-64 AC-96 P
No2-8 AC
Calc. 71.730 Ac
No. 2 McCULLOUGH DEED 8 Ac.
JOS. H. MASON
Deed 40 AC.
Calc. 39.100 AC.
Resv. 2.212 AC.
Remaining 37.138 AC.
RUN
CREEK
PUBLIC ROAD
AVENUE MINE WORKINGS
8" TUSCAROORA OIL LINE
GAS WELL (Abandoned)
OIL WELLS
N 88°30 E 2689.52
N 88°43 E 2405.93
S 88°38 W 1778.85
S 89°04 W 1256.25
N 3°10 W 1730.65
N 3°10 W 941.02
N 3°10 W 1772.71
S 89°07 W 1048.79
S 78°33 W 912.17
S 55°28 E 3620.83
N 10°53 W 821.96
N 0°18 E 1030.18
N 0°34 W 1269.74
S 88°38 W 1790.06
N 15°47 W 301.00
S 88°30 E 1778.85
N 88°30 E 2689.52
N 3°10 W 1772.71
N 3°10 W 1730.65
S 89°07 W 1048.79
S 78°33 W 912.17
S 55°28 E 3620.83
N 0°18 E 1030.18
N 10°53 W 821.96
N 0°34 W 1269.74
S 88°38 W 1790.06
N 15°47 W 301.00
N
I certify that this print is a true and correct copy of the original map of said mine, and that the original map is a true, complete, and correct map and survey of all the excavations made in such abandoned mine.
Robert D. Gosser
Professional Engineer No. 9789
LEECHBURG MINING CO.
HAAS MINE NO.2
FORMERLY
HAAS COAL CO.
SITUATE IN
FAWN TWP. - ALLEGHENY COUNTY, PA.
SCALE 1 INCH = 100 FEET - OCT. 3, 1961
ENGINEERING DEPT. - HICKS COAL INT.
LEECHBURG, PENNA.
#1185
7-28-71
22