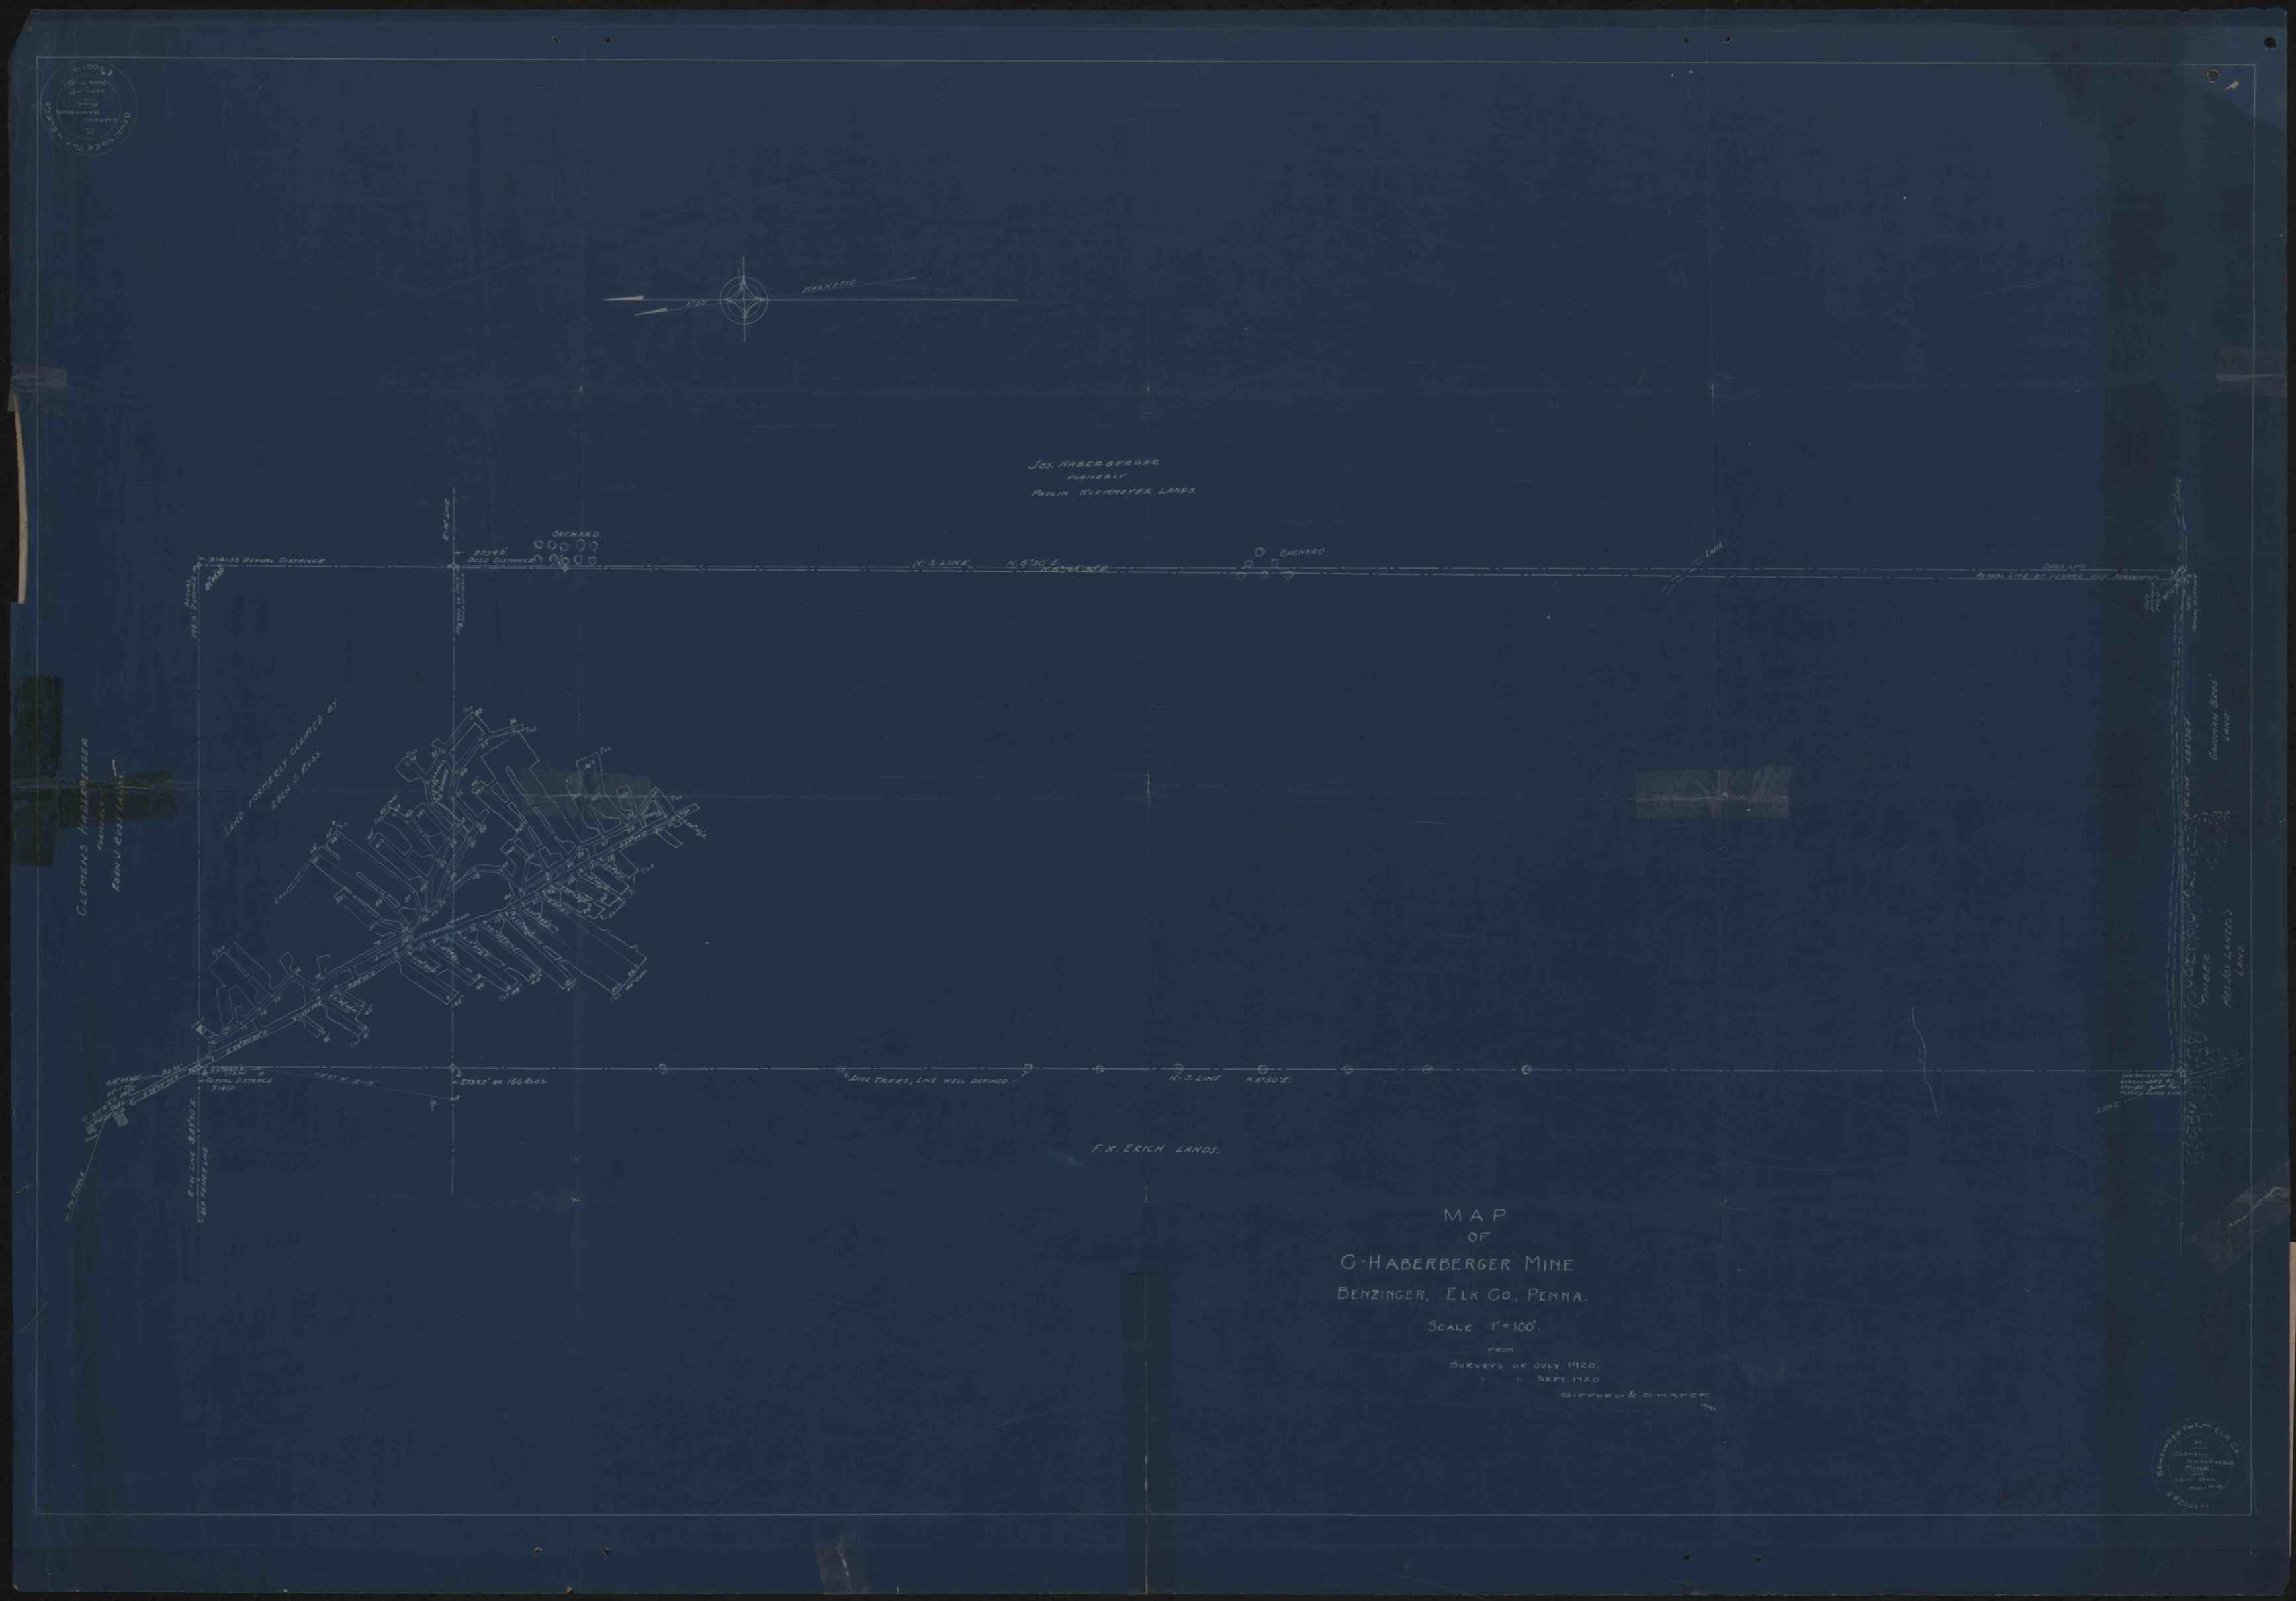
MAGNETIC
JOS. HABERBERGER
FORMERLY
PAULIN KLEMMEYER LANDS.
ORCHARD.
ORCHARD
N.-S. LINE
N. 6°30' E.
N. 6°45' 30" E.
DEED LINE
ACTUAL LINE BY FEUARE AND AGREEMENT
LAND FORMERLY CLAIMED BY
EBEN J. RUSS.
CLEMENS HABERBERGER
FORMERLY
EBEN J. RUSS LANDS
GAUSMAN BROS. LAND.
TIMBER
MRS. JOS. LANZEL'S LAND.
LINE TREES, LINE WELL DEFINED.
N.-S. LINE
N. 6°30' E.
F. X. ERICH LANDS.
MAP
OF
C-HABERBERGER MINE
BENZINGER, ELK CO., PENNA.
SCALE 1" = 100'.
FROM
SURVEYS OF JULY 1920.
" " SEPT. 1920
GIFFORD & SHAFER
BENZINGER TWP. — ELK CO.
CLEMENS HABERBERGER MINE.
SEPT. 1920.
E 82001-1