


**HANLEY COMPANY  
CLAY MINE --- 4A**  
SUMMERVILLE, JEFFERSON CO. PENNA.  
SCALE 1"=100' JULY 17, 1968

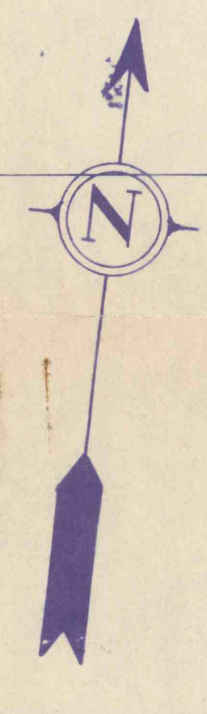

- LEGEND**
- TIMBERED
  - CAVED
  - PROPOSED MINING
  - (0000) TIME ROOF ELEVATION
  - 0000 SURFACE ELEVATION

REVISIONS	
N <sup>o</sup>	DATE
1	JULY 17, 1968
2	AUG 14, 1968
