


THOMAS PAY RESERVE  
25.0178 AC.

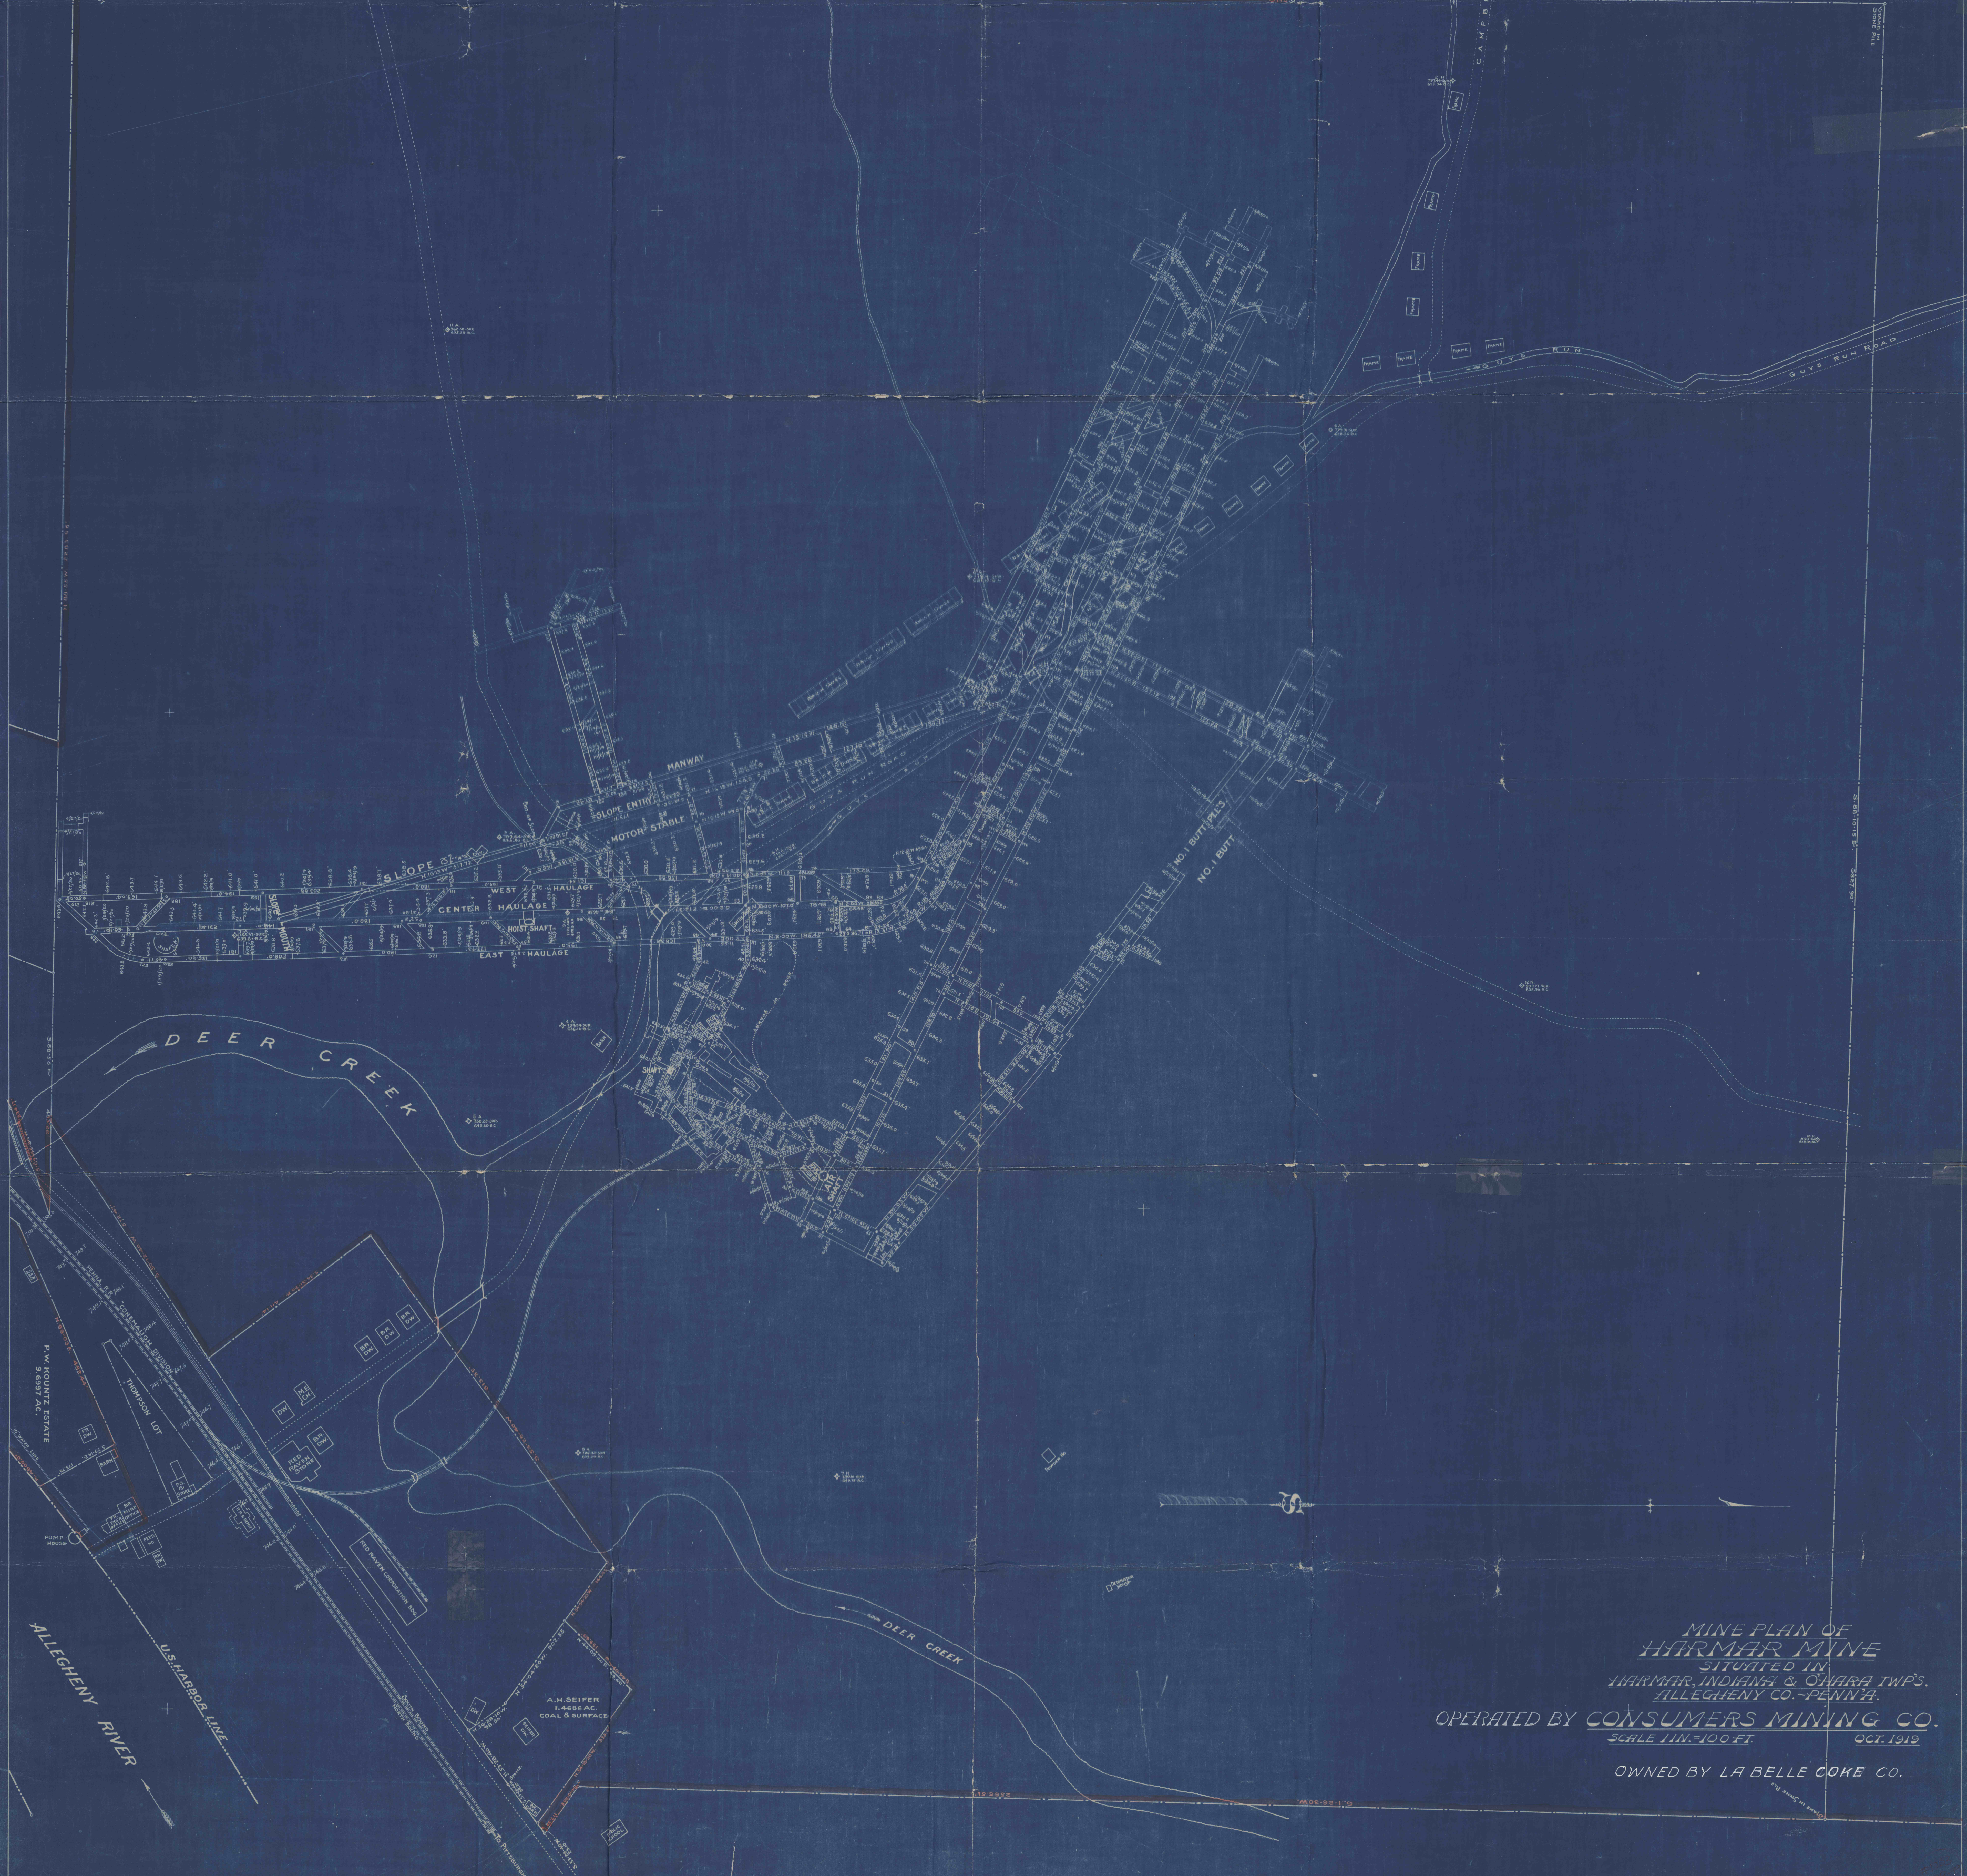

MINE PLAN OF  
HARMAR MINE  
SITUATED IN  
HARMAR, INDIANA & OSWEGO TWP'S,  
ALLEGHENY CO., PENN'A.  
OPERATED BY CONSUMERS MINING CO.  
SCALE 1/4" = 100 FT. OCT. 1919  
OWNED BY LA BELLE COKE CO.