


HARMON COAL CORPORATION  
MINE NO. 1  
REDBANK TOWNSHIP ARMSTRONG COUNTY  
PENNSYLVANIA  
JULY 1966  
P. 100

LEGEND  
□ MINING COMPLETED  
□ ACTIVE ENTRIES  
□ DRAWN STAMPS

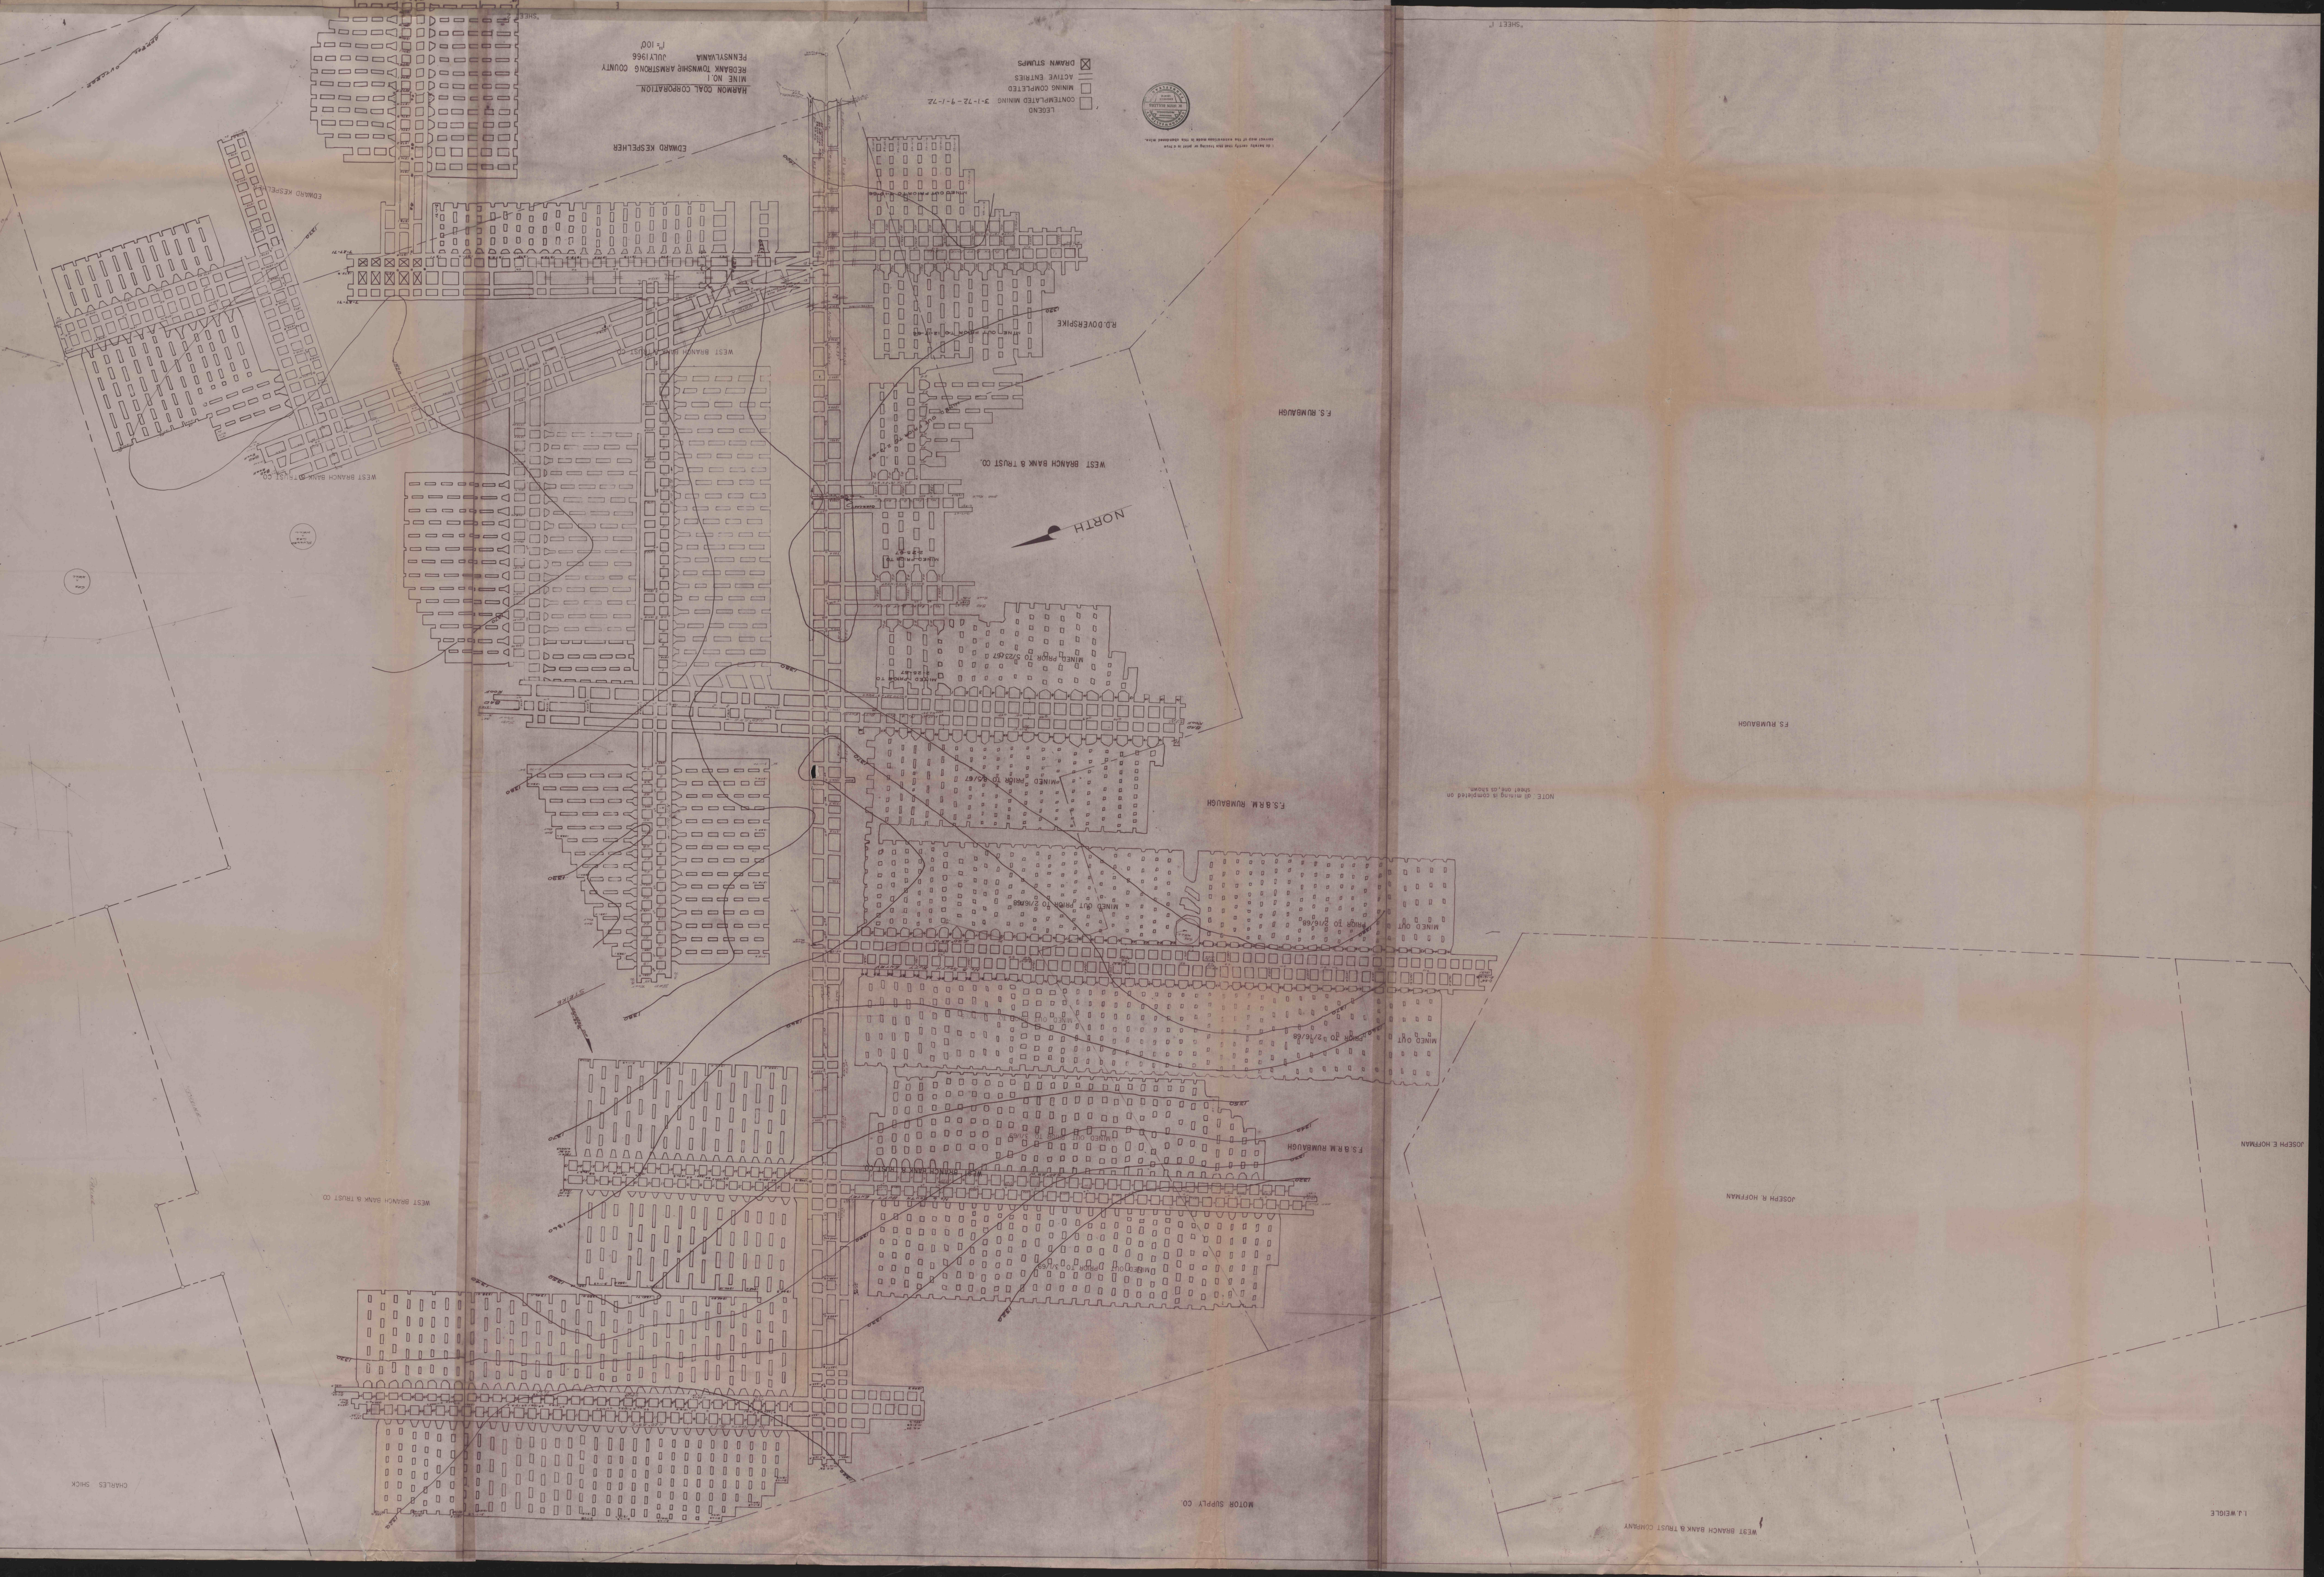




NOTE: All mining is completed on sheet map as shown.

