
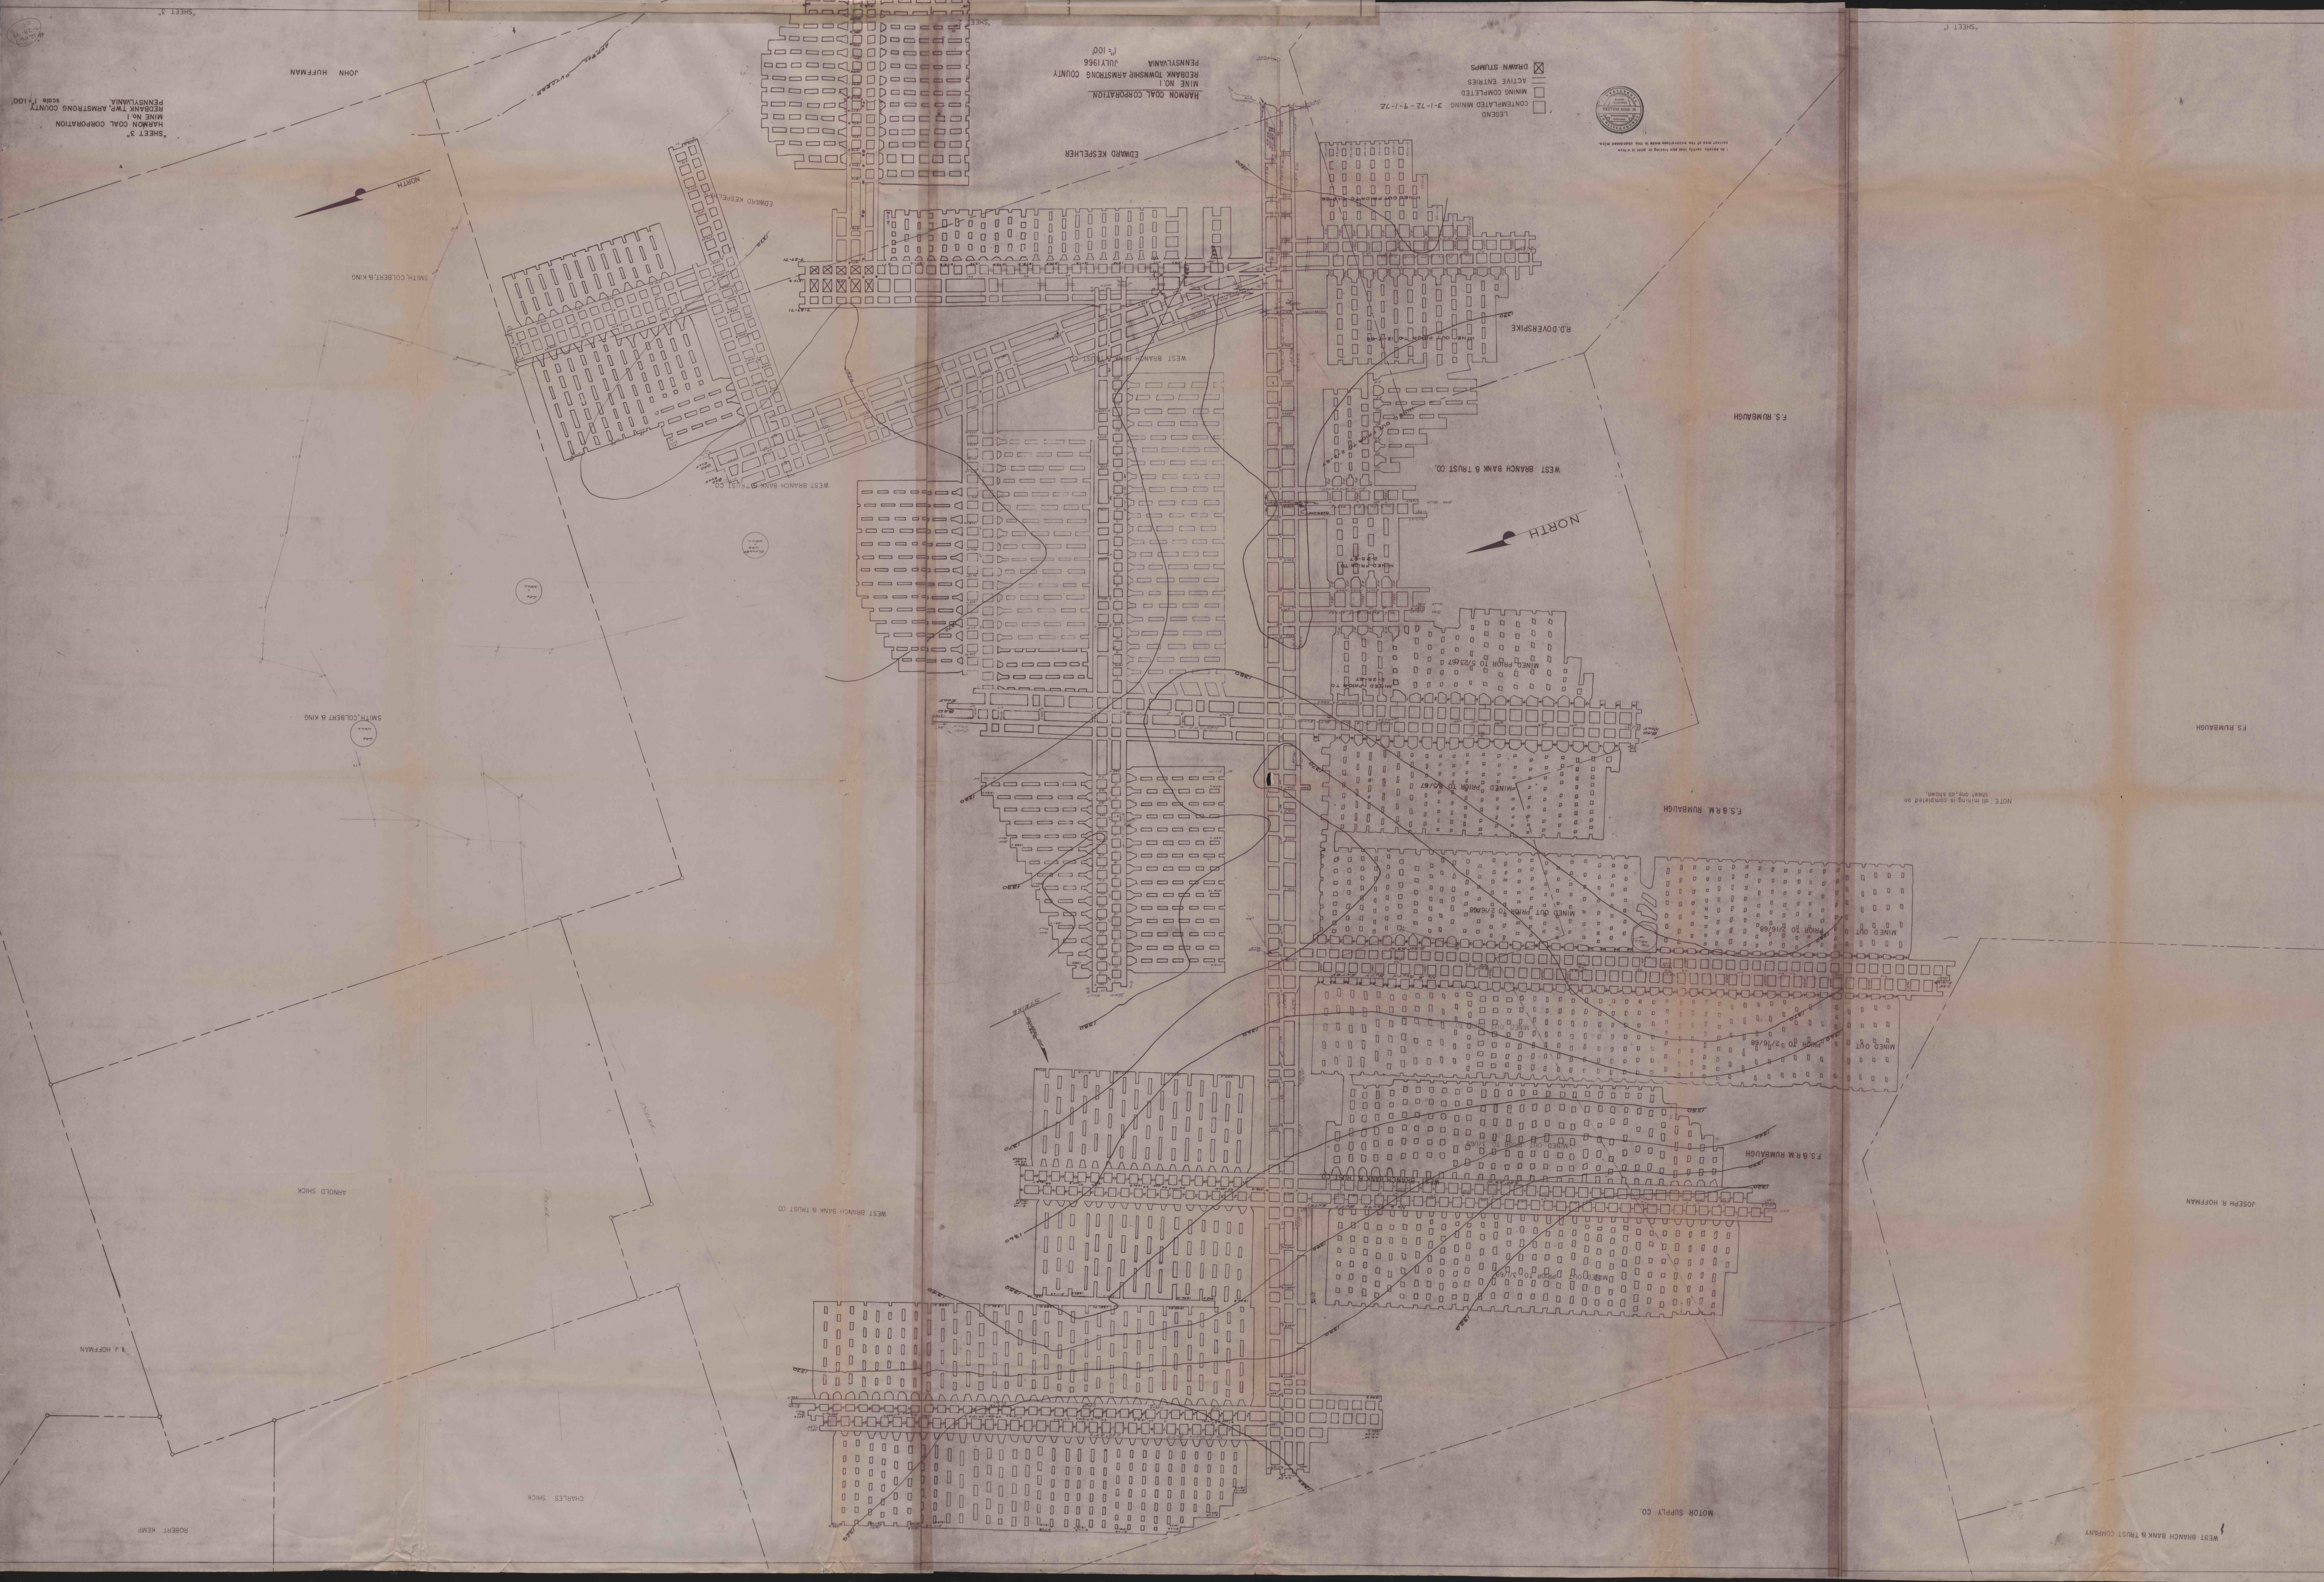
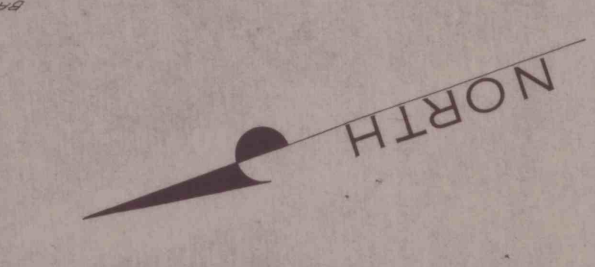


SHEET 3  
HARMON COAL CORPORATION  
MINE NO. 1  
REBANK TWP. ARMSTRONG COUNTY  
PENNSYLVANIA  
SCALE 1"=100'  
JOHN HUFFMAN

HARMON COAL CORPORATION  
MINE NO. 1  
REBANK TWP. ARMSTRONG COUNTY  
PENNSYLVANIA  
JULY 1966  
SCALE 1"=100'

LEGEND  
☐ CONTEMPLATED MINING 3-1-72-7-1-72  
☐ MINING COMPLETED  
☒ ACTIVE ENTRIES  
☒ DRAWN STAMPS

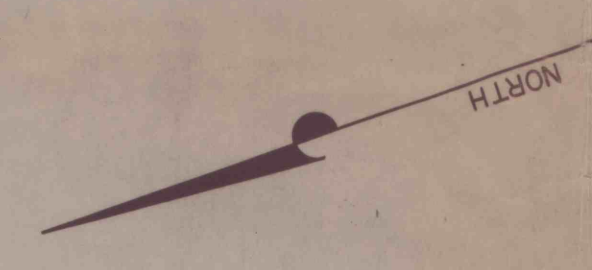

ROBERT KEMP  
CHARLES SHICK

ARNOLD SHICK

WEST BRANCH BANK & TRUST CO.

MOTOR SUPPLY CO.

WEST BRANCH BANK & TRUST COMPANY

JOSEPH B. HOFFMAN

NOTE: All mining is completed on  
sheet one as shown.

F.S. RUMBROUGH

F.S. RUMBROUGH

WEST BRANCH BANK & TRUST CO.

EDWARD KESPELHER

SMITH, COLBERT & KING